
ABELL SURVEYING & MAPPING

1140 SEQUOIA STREET • DELAVAN, WISCONSIN 53115 262-728-6737

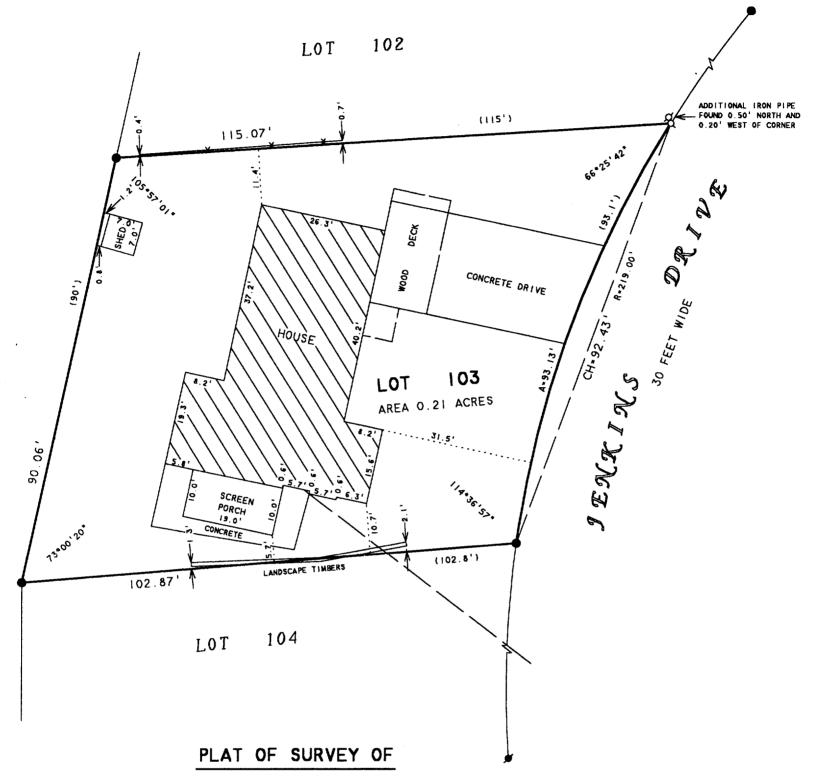

LOT 103, UNIT 2, COUNTRY CLUB ESTATES, LOCATED IN THE VILLAGE OF FONTANA, WALWORTH COUNTY, WISCONSIN.





SCALE | " = 20"

LEGEND

✓ -IRON PIPE FOUND

— CONCRETE MONUMENT FOUND

— IRON ROD FOUND

— OVERHEAD UTILITY LINES

X -WOOD FENCE POSTS

()-RECORDED AS

REVISED AND RECERTIFIED: MAY 19, 2004 ORDERED BY: KEEFE REAL ESTATE

P.O. BOX 460

LAKE GENEVA, WI 53147

AU. 5

 $V\omega$

I HEREBY CERTIFY THAT I HAVE SURVEYED THE ABOVE DESCRIBED PROPERTY AND THAT THE ABOVE MAP IS A TRUE REPRESENTATION THEREOF AND SHOWS THE SIZE AND LOCATION OF THE PROPERTY, ITS EXTERIOR BOUNDARIES, THE LOCATION OF ALL VISIBLE STRUCTURES AND DIMENSIONS OF ALL PRINCIPAL BUILDINGS THEREON, BOUNDARY FENCES, APPARENT EASEMENTS, ROADWAYS AND VISIBLE ENCROACHMENTS, IF ANY, TO THE BEST OF MY KNOWLEDGE AND BELIEF.

THIS SURVEY IS MADE FOR THE USE OF THE PRESENT OWNERS OF THE PROPERTY, AND ALSO THOSE WHO PURCHASE, MORTGAGE, OR GUARANTEE THE TITLE THERETO WITHIN ONE (I) YEAR FROM DATE HEREON.

Land 7. Chil

DAVID F. ABELL WISCONSIN REGISTERED LAND SURVEYOR. S-1596

February 11, 1999

DATE JOB NUMBER - 99010A NOTE: THIS IS NOT A CERTIFIED COPY UNLESS SEALED.

005-2183