
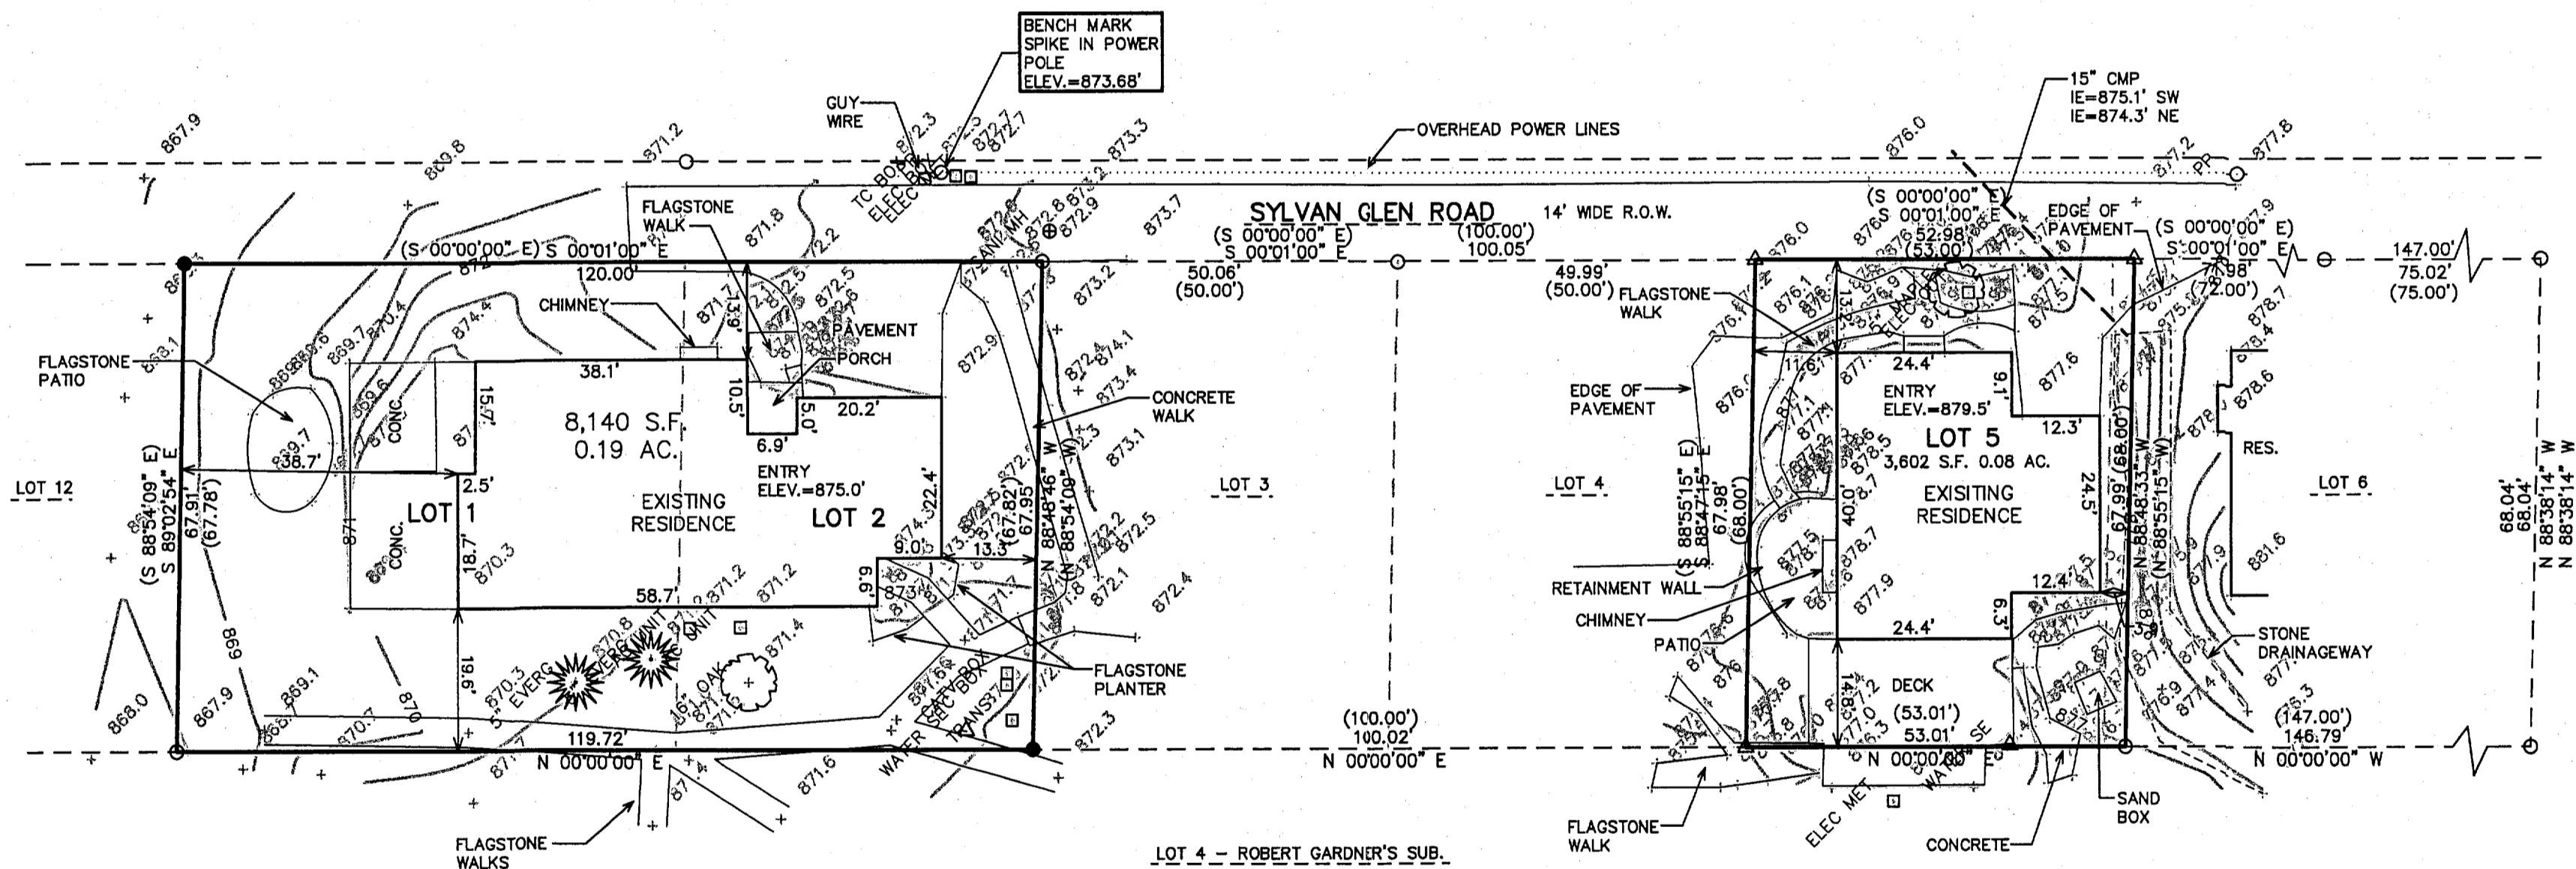


PLAT OF SURVEY

LOTS 1-2, AND LOT 5 AND THE NORTH 3' OF LOT 6 OF SYLVAN GLEN SUBDIVISION

LOCATED IN THE VILLAGE OF FONTANA-ON-GENEVA LAKE,
WALWORTH COUNTY, WISCONSIN

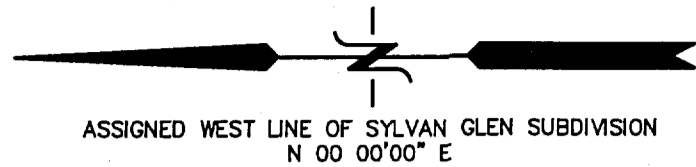

WORK ORDERED BY -
LISA SMITH - SHOEDEN, INC.
17 N. FIRST STREET
GENEVA, IL 60134


FARRIS, HANSEN & ASSOCIATES, INC.
ENGINEERING - ARCHITECTURE - SURVEYING
7 RIDGWAY COURT P.O. BOX 437
ELKHORN, WISCONSIN 53121
OFFICE: (262) 723-2098 FAX: (262) 723-5886

FEB - 4 2005

- LEGEND
- = FOUND IRON PIPE STAKE
 - = SET IRON REBAR STAKE
 - △ = SET "PK" NAIL IN PAVEMENT
 - (XXX) = RECORDED AS


NOTE: COPIES OF THIS MAP TO WHICH THE FOLLOWING CERTIFICATE WILL APPLY SHOW THE SURVEYOR'S ORIGINAL SEAL AND SIGNATURE IN RED INK. COPIES BY ANY OTHER MEANS MAY HAVE ALTERATIONS WHICH DO NOT REPRESENT THE SURVEYOR'S WORK PRODUCT.

I HEREBY CERTIFY THAT THE ABOVE DESCRIBED PROPERTY HAS BEEN SURVEYED UNDER MY DIRECTION AND THAT THE ABOVE MAP IS A TRUE REPRESENTATION THEREOF AND SHOWS THE SIZE AND LOCATION OF THE PROPERTY AND ITS EXTERIOR BOUNDARIES. THIS SURVEY IS MADE FOR THE USE OF THE PRESENT OWNERS OF THE PROPERTY, AND ALSO THOSE WHO PURCHASE, MORTGAGE, OR GUARANTEE THE TITLE THERETO WITHIN ONE YEAR FROM THE DATE HEREOF.

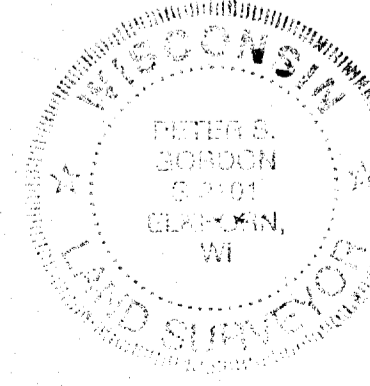

DATED: JANUARY 14, 2005

Peter S. Gordon
PETER S. GORDON R.L.S. 2101

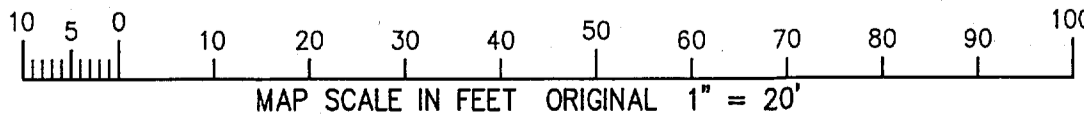

SSGN-1
SSGN-2
SSGN-4

REVISIONS

PROJECT NO.	6686
DATE:	01/14/05
SHEET NO.	1 OF 1

005-2246

1/17/2005 X:\Projects\6686\Draw\Survey

1/17/2005