


ABELL SURVEYING & MAPPING

1140 SEQUOIA STREET • DELAVAN, WISCONSIN 53115
262-728-6737

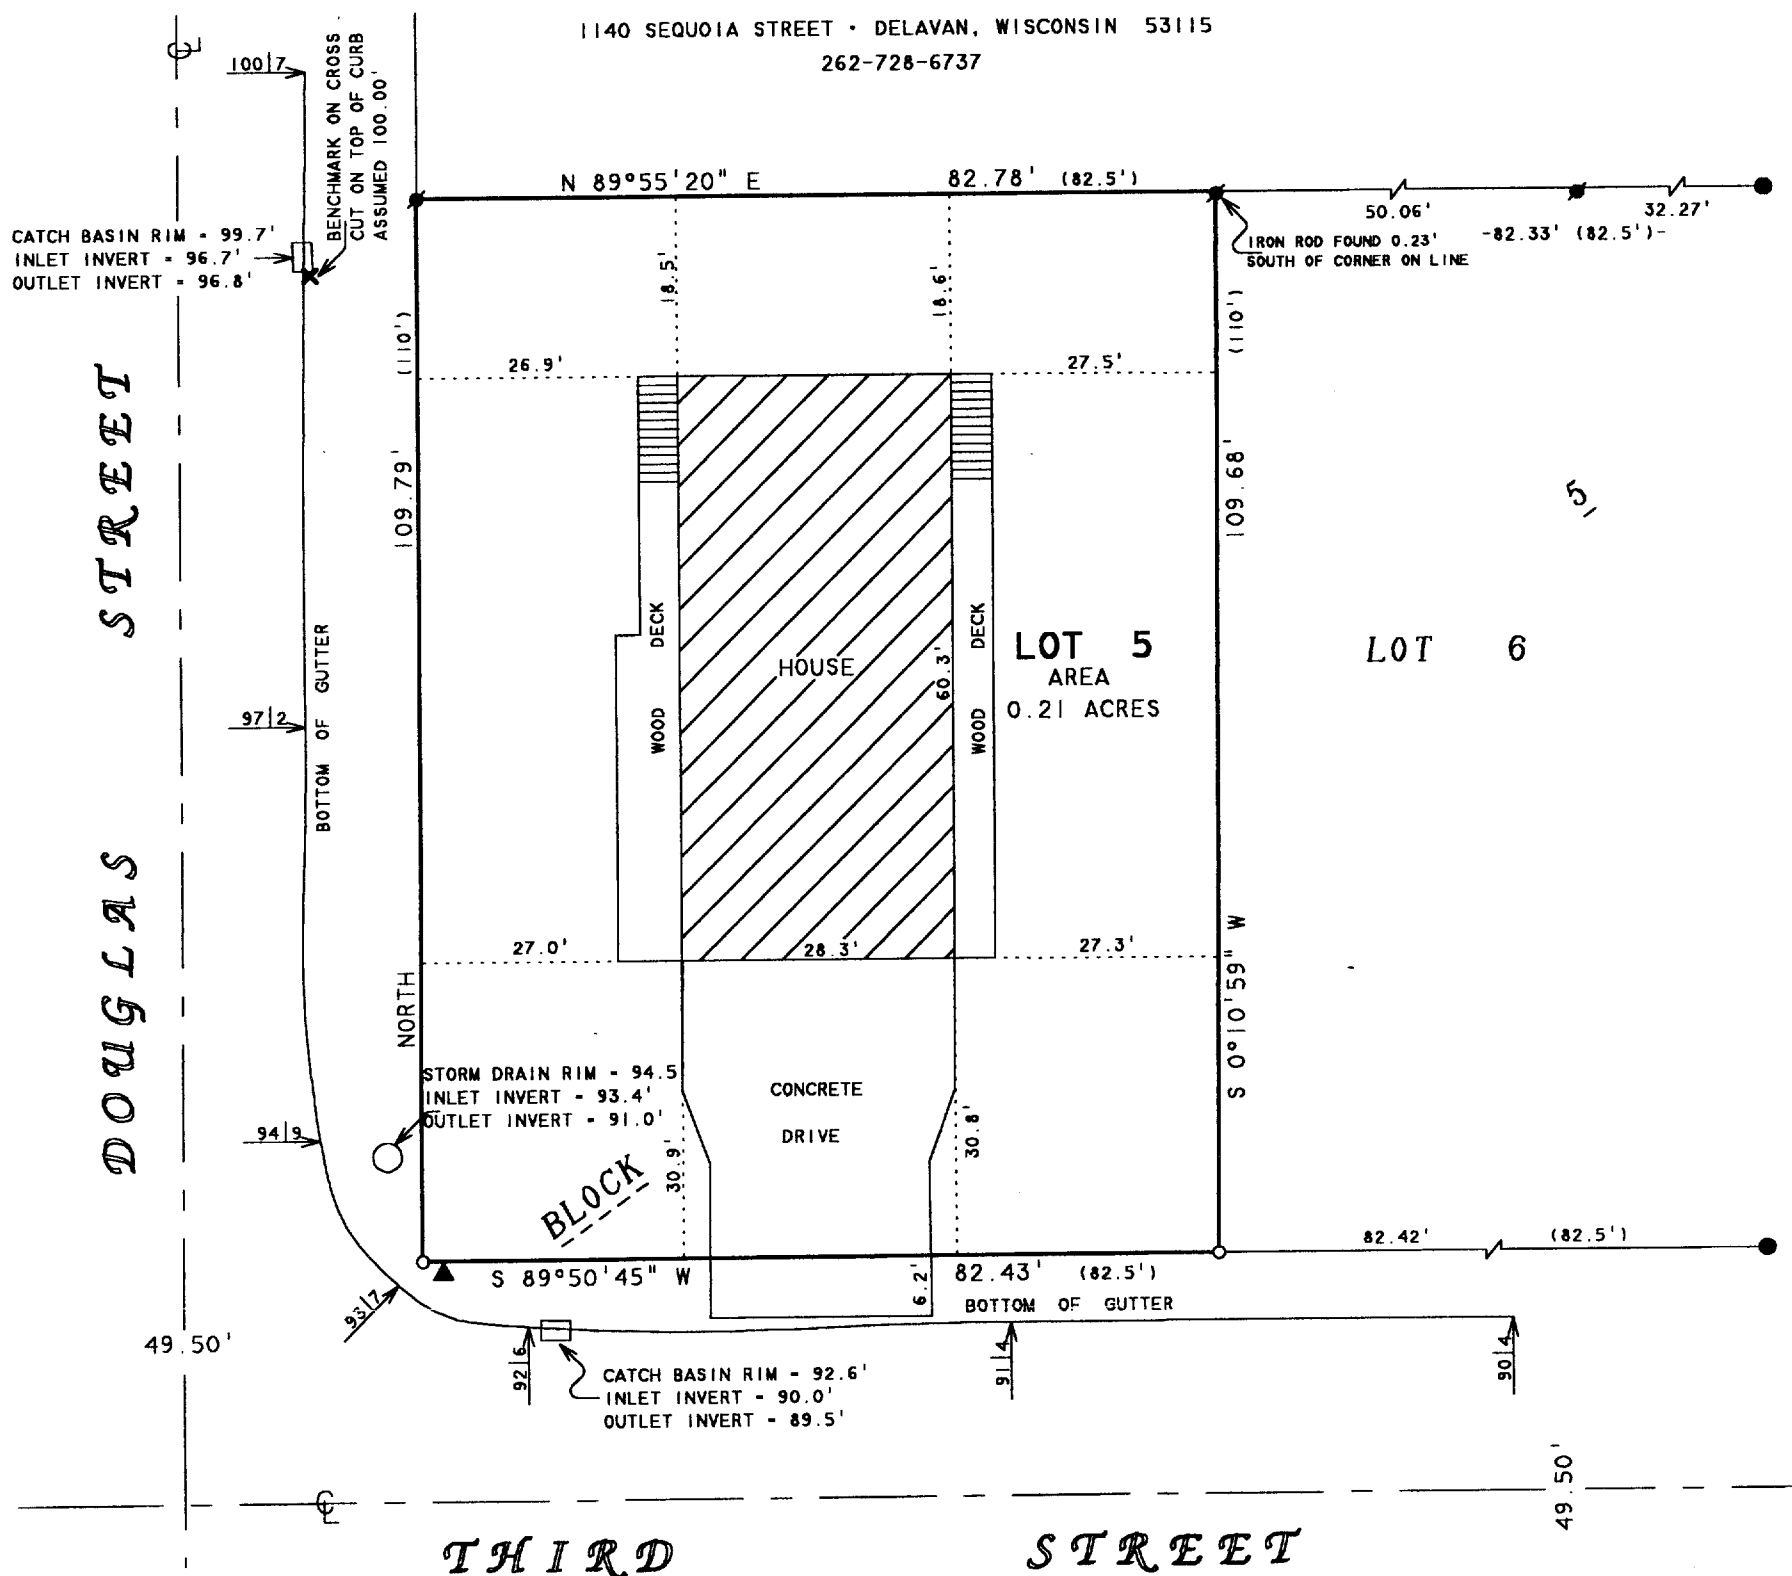

N



SCALE 1"=20'

LEGEND

- -IRON ROD FOUND
- -CONCRETE MONUMENT FOUND
- -3/4" DIA. IRON ROD SET
- -SPOT ELEVATION
- ▲ -FIRE HYDRANT
- ✕ -CROSS CUT ON TOP OF CURB
- () -RECORDED AS

REVISED DATE: MARCH 16, 2004
REVISED TO SHOW SPOT ELEVATIONS,
STORM DRAIN LOCATIONS, INLET AND
OUTLET INVERTS.

REVISED DATE: APRIL 20, 2004
REVISED TO SHOW NEW LOCATION OF
PROPOSED HOUSE.

REVISED DATE: APRIL 23, 2004
REVISED TO SHOW NEW LOCATION OF
PROPOSED HOUSE.

REVISED DATE: JUNE 18, 2004
REVISED TO SHOW NEW LOCATION OF
PROPOSED HOUSE AND LOCATION OF
TIMBER PILES.

REVISED DATE: NOVEMBER 9, 2004
REVISED TO SHOW LOCATION OF
HOUSE.

ORDERED BY: TAGGART REAL ESTATE
797 WELLS STREET
LAKE GENEVA, WI 53147

PLAT OF SURVEY OF

LOT 5, BLOCK 5, ORIGINAL PLAT OF THE VILLAGE OF
FONTANA-ON-GENEVA LAKE, WALWORTH COUNTY, WISCONSIN.

I HEREBY CERTIFY THAT I HAVE SURVEYED THE ABOVE DESCRIBED PROPERTY AND THAT THE ABOVE MAP IS A TRUE REPRESENTATION THEREOF AND SHOWS THE SIZE AND LOCATION OF THE PROPERTY, ITS EXTERIOR BOUNDARIES, THE LOCATION OF ALL VISIBLE STRUCTURES AND DIMENSIONS OF ALL PRINCIPAL BUILDINGS THEREON, BOUNDARY FENCES, APPARENT EASEMENTS, ROADWAYS AND VISIBLE ENCROACHMENTS, IF ANY, TO THE BEST OF MY KNOWLEDGE AND BELIEF.

THIS SURVEY IS MADE FOR THE USE OF THE PRESENT OWNERS OF THE PROPERTY, AND ALSO THOSE WHO PURCHASE, MORTGAGE, OR GUARANTEE THE TITLE THERETO WITHIN ONE (1) YEAR FROM DATE HEREON.

David F. Abell
DAVID F. ABELL
WISCONSIN REGISTERED LAND SURVEYOR, S-1596

February 19, 2004

DATE: JOB NUMBER - 92276F
NOTE: THIS IS NOT A CERTIFIED COPY UNLESS SEALED.

SOP-31

005-2253