



# PLAT OF SURVEY LOT 23 OF BUENA VISTA


A SUBDIVISION LOCATED IN PART OF THE  
VILLAGE OF FONTANA-ON-GENEVA LAKE,  
WALWORTH COUNTY, WISCONSIN

WORK ORDERED BY -  
SUSAN CENAR  
ORREN PICKELL DESIGNERS & BUILDERS  
2201 WAUKEGAN ROAD, SUITE W-285  
BANNOCKBURN, IL 60015

FARRIS, HANSEN & ASSOCIATES, INC.  
ENGINEERING - ARCHITECTURE - SURVEYING  
7 RIDGWAY COURT P.O. BOX 437  
ELKHORN, WISCONSIN 53121  
OFFICE: (262) 723-2098 FAX: (262) 723-5886

REVISIONS  
10/27/2004 SITE, GRADING, DRAINAGE, & EROSION CONTROL PLAN  
11/02/2004 MISC. REVS.  
12-09-04 MISC. REVS.  
12/20/2004 REVISE PRO. RES. LAYOUT  
12-29-04 ADJ. LOC.

PROJECT NO. 6556  
DATE: 05-14-04  
SHEET NO. 1 OF 1

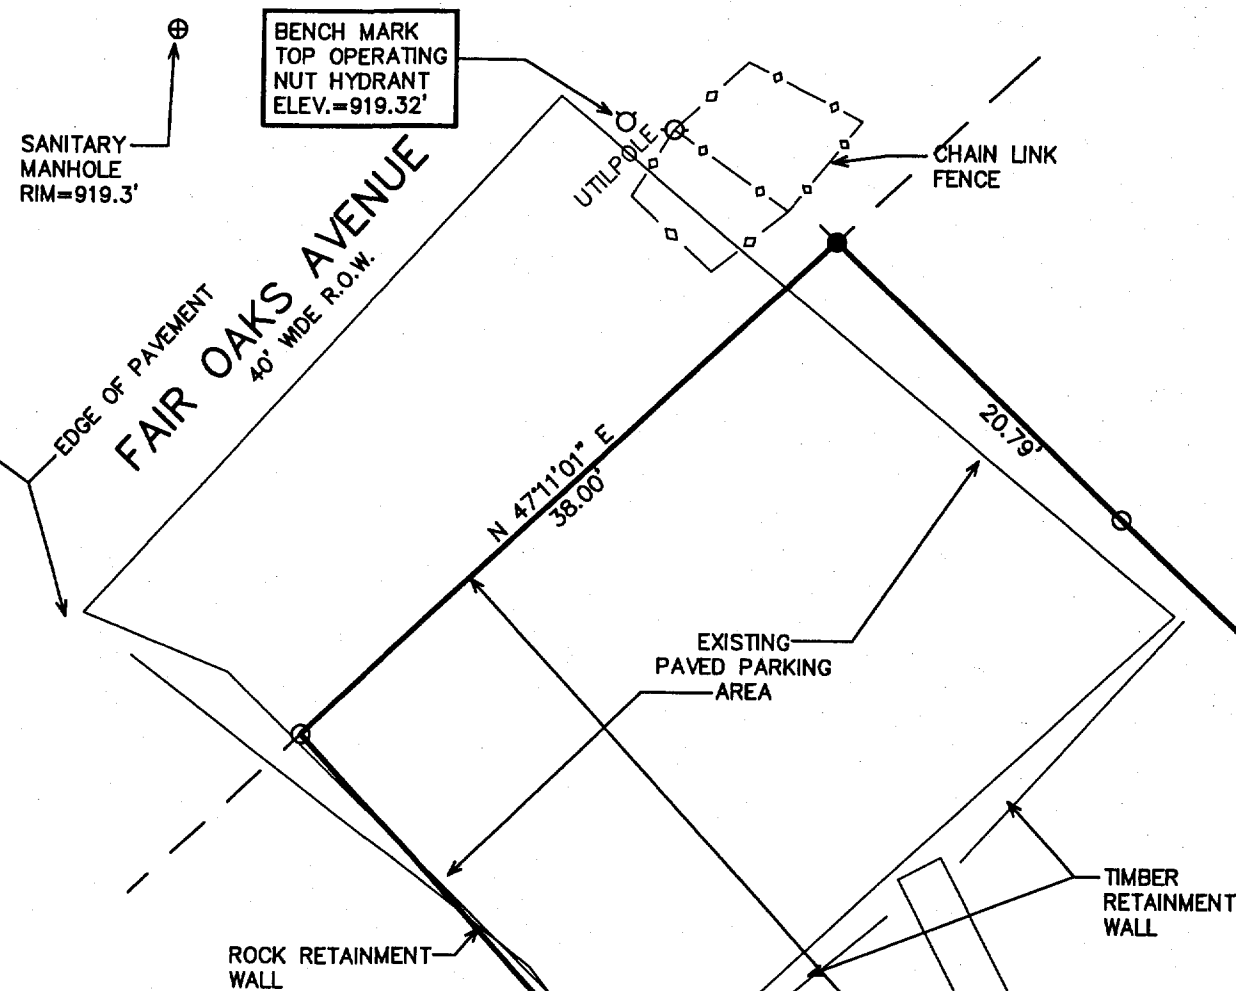

LEGEND  
○ = FOUND IRON PIPE STAKE  
● = SET IRON REBAR STAKE  
(XXX) = RECORDED AS



NOTE: COPIES OF THIS MAP TO WHICH THE FOLLOWING CERTIFICATE WILL APPLY SHOW THE SURVEYOR'S ORIGINAL SEAL AND SIGNATURE IN RED INK. COPIES BY ANY OTHER MEANS MAY HAVE ALTERATIONS WHICH DO NOT REPRESENT THE SURVEYOR'S WORK PRODUCT.

I HEREBY CERTIFY THAT THE ABOVE DESCRIBED PROPERTY HAS BEEN SURVEYED UNDER MY DIRECTION AND THAT THE ABOVE MAP IS A TRUE REPRESENTATION THEREOF AND SHOWS THE SIZE AND LOCATION OF THE PROPERTY AND ITS EXTERIOR BOUNDARIES. THIS SURVEY IS MADE FOR THE USE OF THE PRESENT OWNERS OF THE PROPERTY, AND ALSO THOSE WHO PURCHASE, MORTGAGE, OR GUARANTEE THE TITLE THERETO WITHIN ONE YEAR FROM THE DATE HEREOF.

DATED: MAY 14, 2004

REVISED 02-02-2005  
TO SHOW SIZE & LOCATION OF  
AS BUILT RESIDENCE

PETER S. GORDON R.L.S. 2101

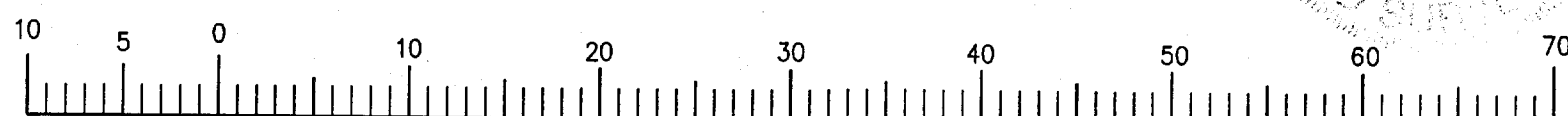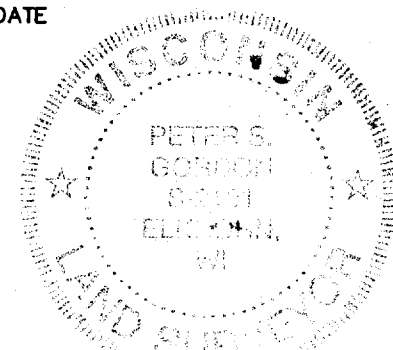

MAP SCALE IN FEET ORIGINAL 1" = 10'

FEB 24 2005

FEB 02 2005

2/2/2005 X:\Projects\6556\DCAD\ASBLT

580 00016

005-2254