
PREPARED FOR: ENGERMAN CONTRACTING & BUILDING INC. W 3411 CTY. HWY. BB LAKE GANEVA WI. 53147

PLAT OF SURVEY

J.K. SURVEYING INC. N3705 WILLOWBEND LANE LAKE GENEVA, WI, 53147 262-248-3697

OUT LOT 61, ASSESSOR'S PLAT NO. 1 (AMENDED), VILLAGE OF FONTANA - ON - GENEVA - LAKE, WALWORTH COUNTY, WISCONSIN.

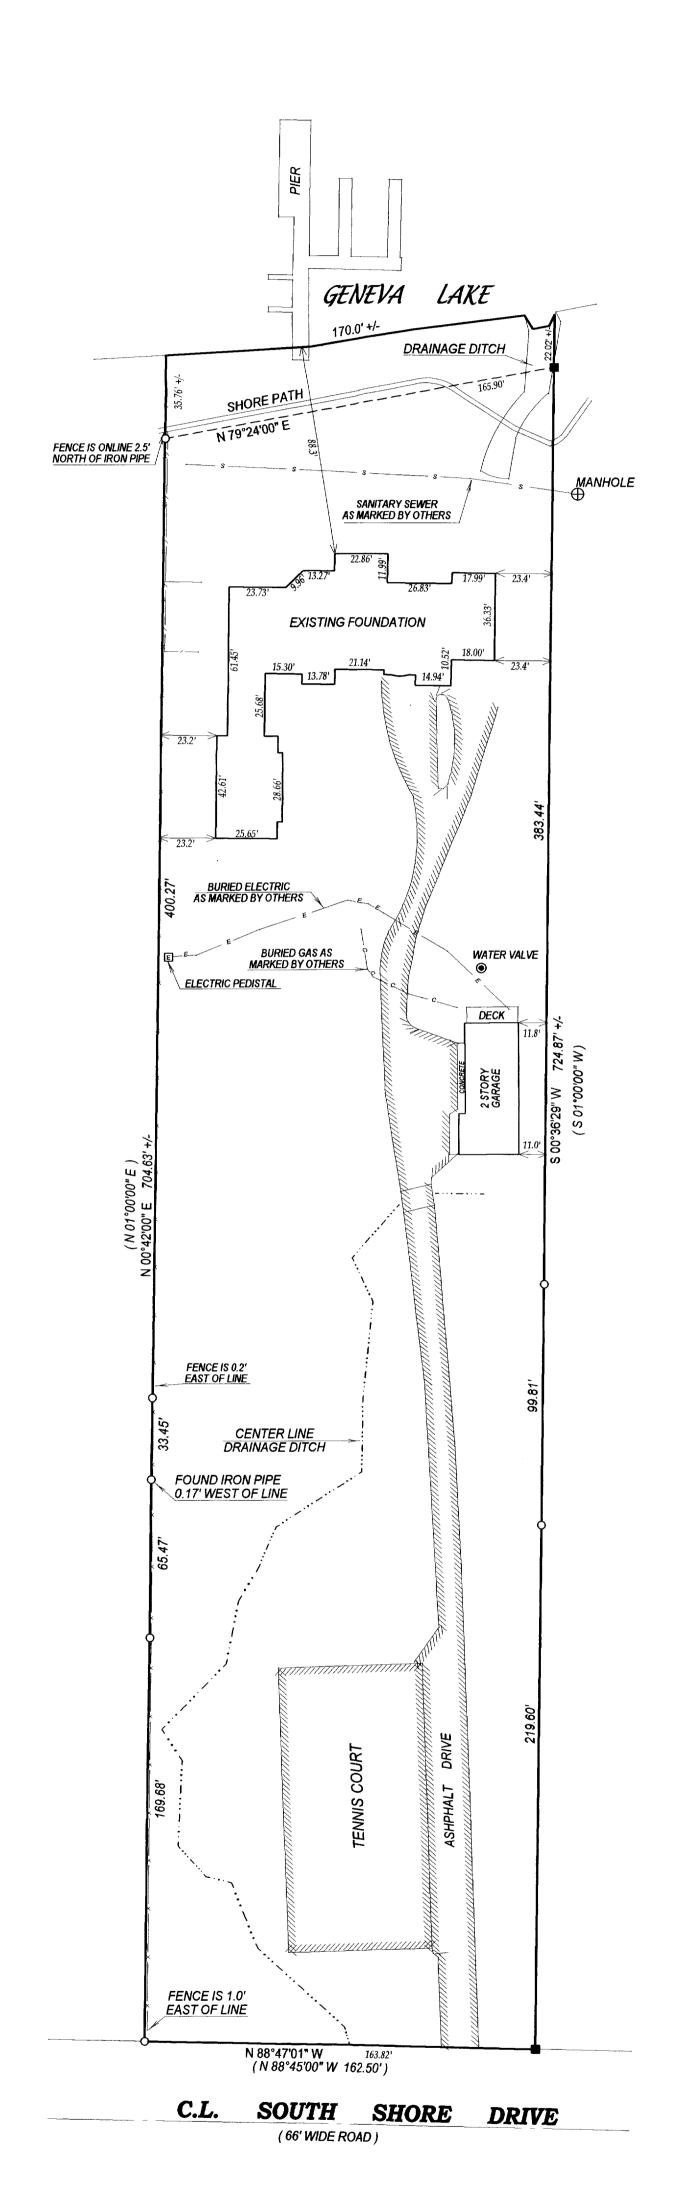


DATE OF LAST REVISION: 10/28/2004 REVISED: 10/04/2004

COMPARE LEGAL DESCRIPTION ABOVE AND DRAWING WITH DEED. FOR BUILDING RESTRICTIONS AND EASEMENTS NOT SHOWN, REFER TO DEED, ABSTRACT SOURCES AND LOCAL MUNICIPAL CODES. NOTIFY THE SURVEYOR IMMEDIATELY OF ANY DISCREPANCY.

"I hereby certify that I have surveyed the above described property and that the above map is a true representation thereof and shows the size and location of all visible structures, apparent easements and encroachments if any."

This survey is made for the present owners of the property, and those who purchase, mortgage, or guarentee the title thereto, within one year from the date hereof.

DATED THIS 30th, DAY OF SEPTEMBER, 2004

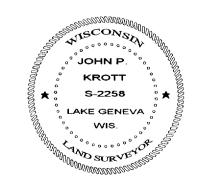

JOHN KROTT S - 2258
Wisconsin Registered Land Surveyor
(original if signed in red)

()= recorded as

TAX ID # STFV00085