


PLAT OF SURVEY
LOTS 4 AND 5, BLOCK 13 OF GLENWOOD SPRINGS SUBDIVISION
LOCATED IN PART OF THE EAST 1/2 OF SECTION 14,
TOWN 1 NORTH, RANGE 16 EAST, WALWORTH COUNTY, WISCONSIN

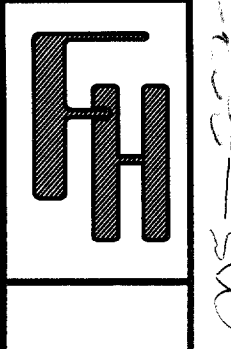

BENCH MARK
TOP IRON REBAR
STAKE; ASSIGNED
ELEV.=203.19'

HARVARD AVENUE
20' WIDE R.O.W.

EDGE OF PAVEMENT

CONCRETE

WOOD
STEPS

RESIDENCE CORNER
0.6' NORTH OF
PROPERTY LINE

FOUND IRON PIPE STAKE
S 03 30' E, 1.67' FROM
PROPERTY CORNER

OVERHEAD POWER LINES

WOOD STEPS

DECK

ENTRY ELEV.=
208.6'

EXISTING
RESIDENCE

CONCRETE
RETAINMENT
WALL

LOT 5

5,600 S.F.
0.13 AC.

LOT 4

LOT 3

DUNLAP AVENUE
30' WIDE R.O.W.

EXISTING
MANHOLE
RIM=204.6'

DUNLAP AVENUE
30' WIDE R.O.W.

BLOCK 12

CATCH
BASINS

- LEGEND
- ▲ = SET NAIL IN PAVEMENT
 - = FOUND IRON PIPE STAKE
 - = FOUND IRON REBAR STAKE
 - ⦿ = SET IRON REBAR STAKE
 - (XXX) = RECORDED AS

NOTE: COPIES OF THIS MAP TO WHICH THE FOLLOWING CERTIFICATE
WILL APPLY SHOW THE SURVEYOR'S ORIGINAL SEAL AND SIGNATURE
IN RED INK. COPIES BY ANY OTHER MEANS MAY HAVE ALTERATIONS
WHICH DO NOT REPRESENT THE SURVEYOR'S WORK PRODUCT.

I HEREBY CERTIFY THAT THE ABOVE DESCRIBED PROPERTY HAS BEEN
SURVEYED UNDER MY DIRECTION AND THAT THE ABOVE MAP IS A TRUE
REPRESENTATION THEREOF AND SHOWS THE SIZE AND LOCATION OF
THE PROPERTY AND ITS EXTERIOR BOUNDARIES. THIS SURVEY IS
MADE FOR THE USE OF THE PRESENT OWNERS OF THE PROPERTY, AND
ALSO THOSE WHO PURCHASE, MORTGAGE, OR GUARANTEE THE TITLE
THERETO WITHIN ONE YEAR FROM THE DATE HEREOF.

DATED: JUNE 9, 2005

Peter S. Gordon
PETER S. GORDON R.L.S. 2101

WORK ORDERED BY -
PAM STARK
10579 N. RIVERLAKE DRIVE
MEQUON, WI 53092

FARRIS, HANSEN & ASSOCIATES, INC.
ENGINEERING - ARCHITECTURE - SURVEYING
7 RIDGWAY COURT P.O. BOX 437
ELKHORN, WISCONSIN 53121
OFFICE: (262) 723-2098 FAX: (262) 723-5886

REVISIONS	
PROJECT NO.	6632
DATE:	09/14/04
SHEET NO.	1 OF 1

