
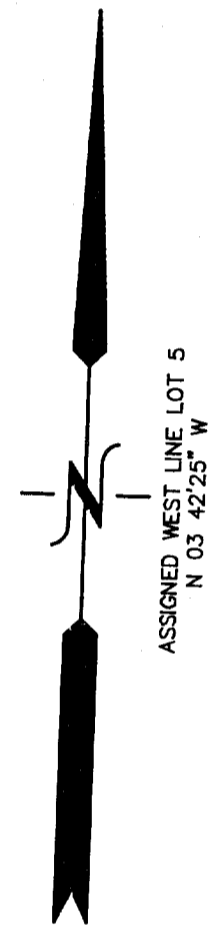


# BOUNDARY & TOPOGRAPHIC SURVEY

LOT 5 OF BLOCK H  
COUNTRY CLUB ESTATES

LOCATED IN SECTIONS 14 AND 23, TOWN 1 NORTH, RANGE 16 EAST,  
WALWORTH COUNTY, WISCONSIN

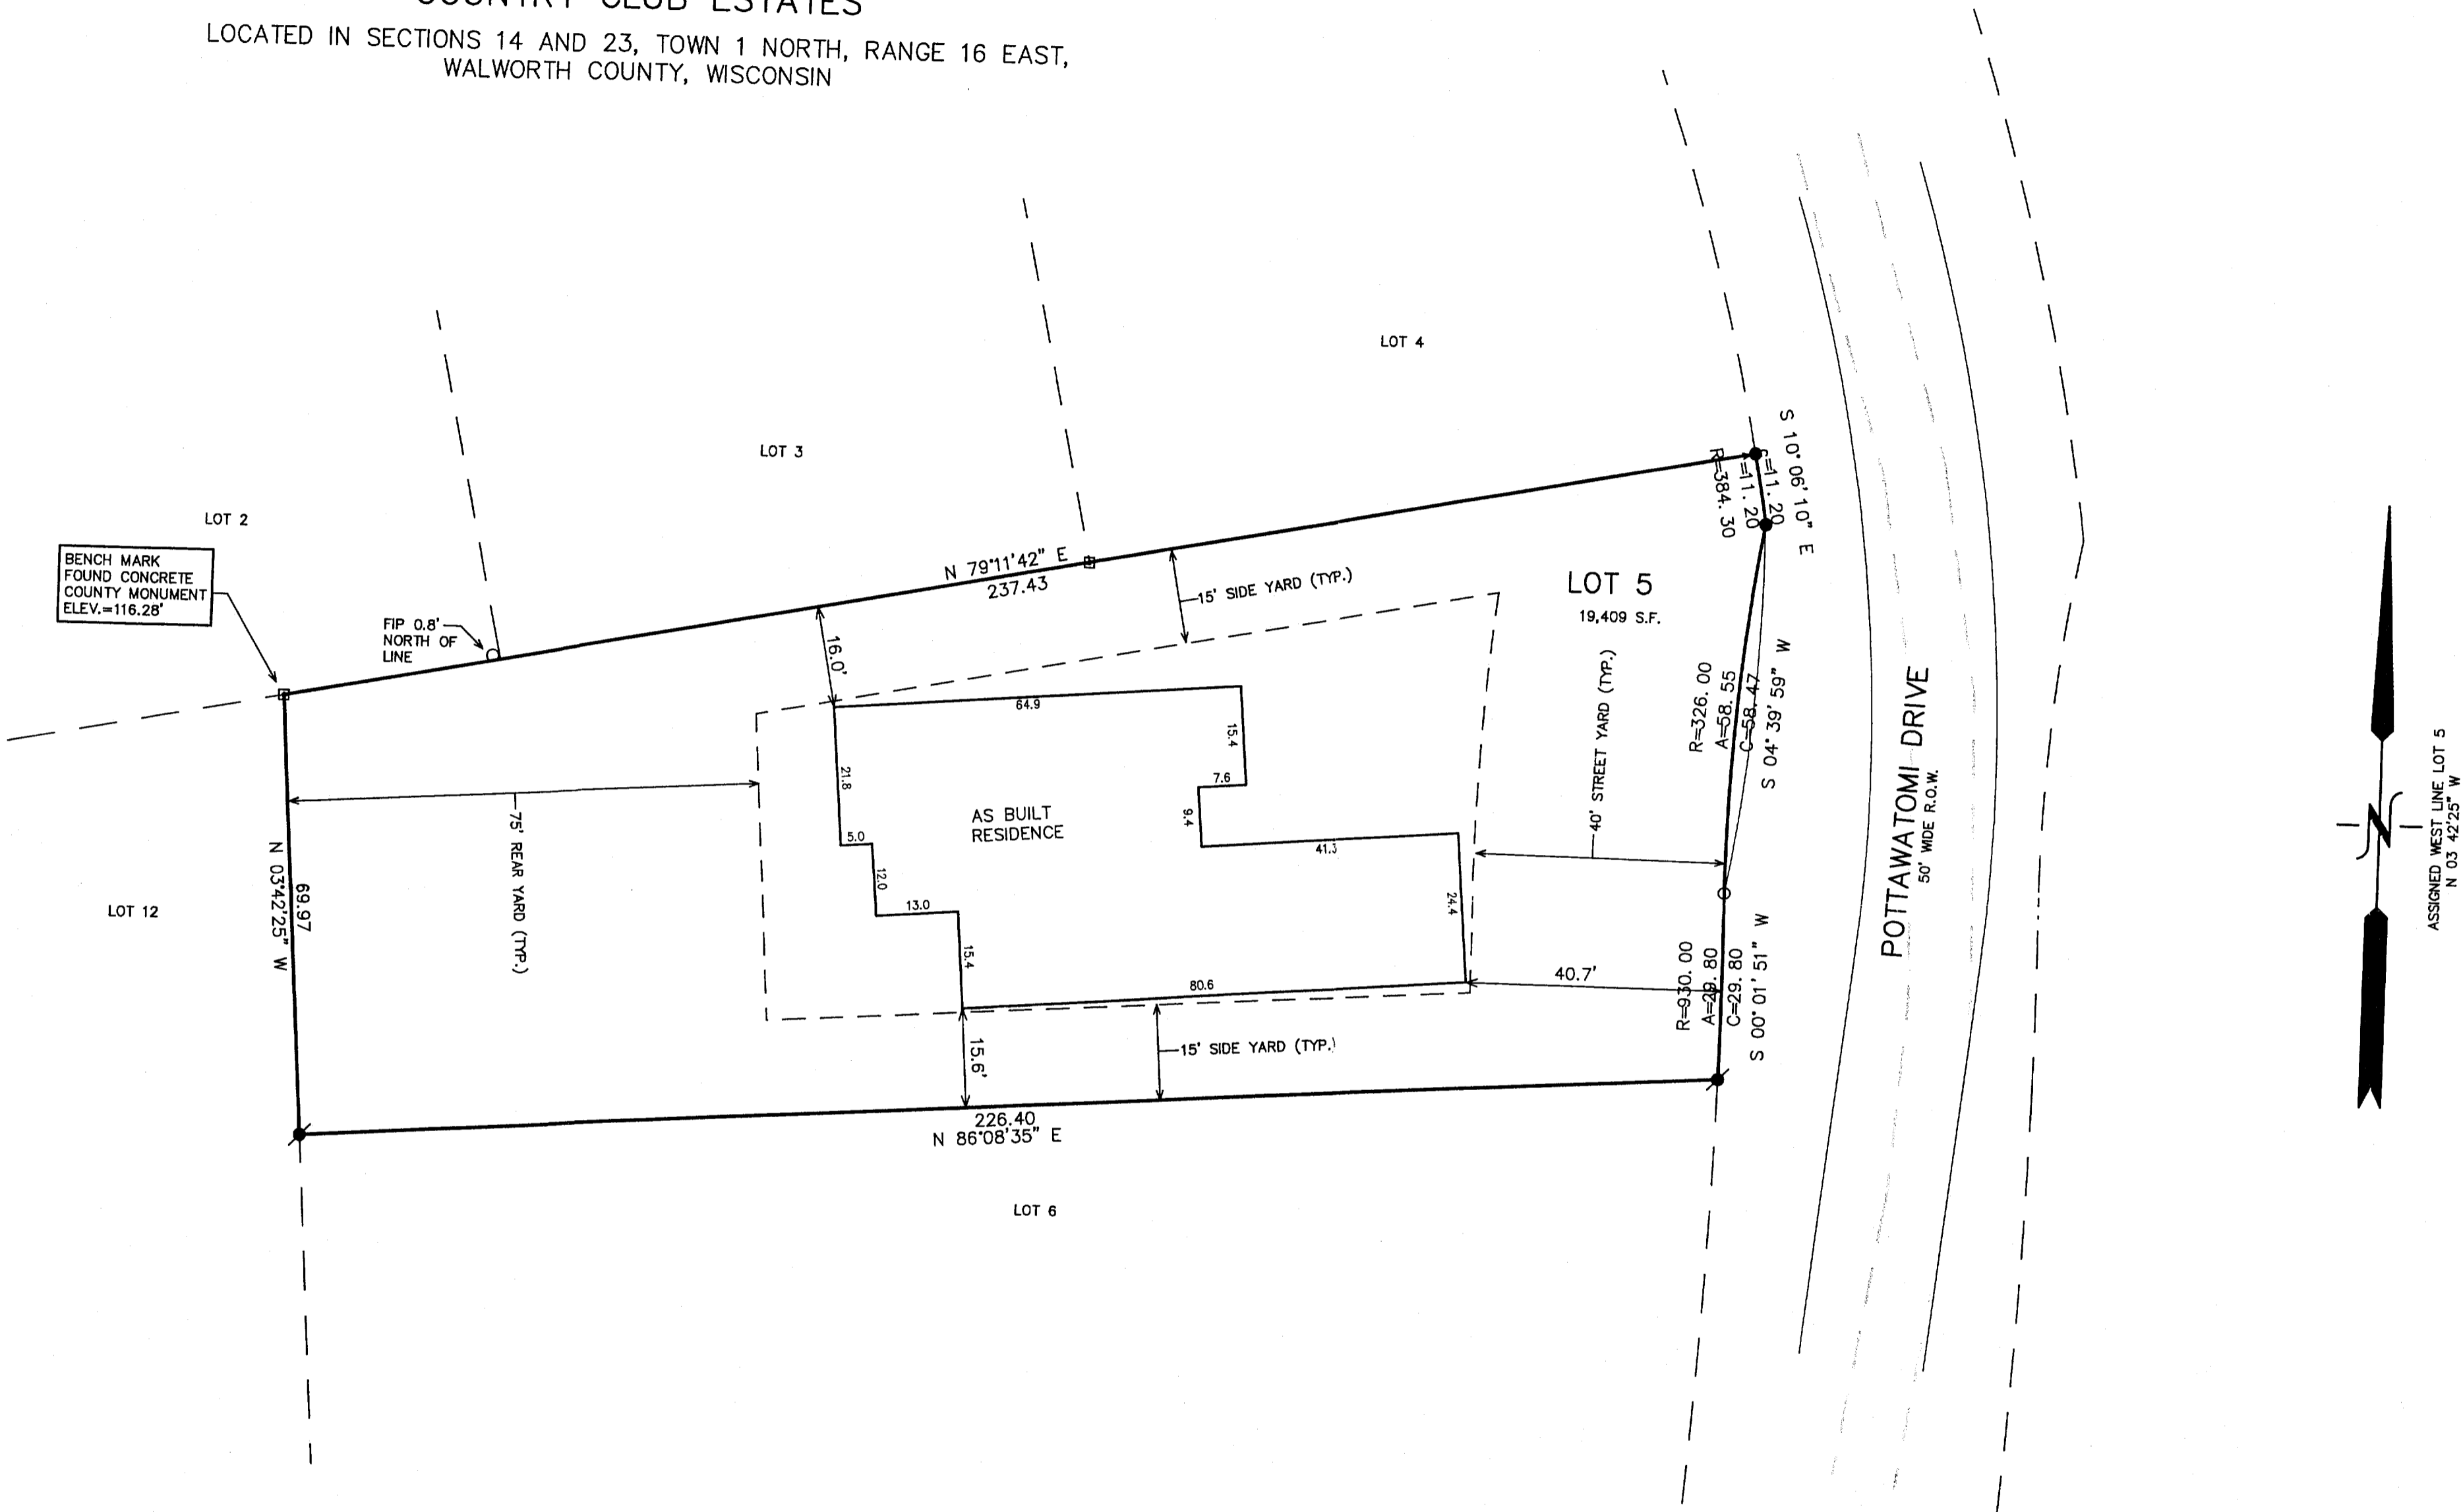

BENCH MARK  
FOUND CONCRETE  
COUNTY MONUMENT  
ELEV.=116.28'

FIP 0.8'  
NORTH OF  
LINE

LOT 2

LOT 3

LOT 4

LOT 5  
19,409 S.F.


POTTAWATOMIE DRIVE  
50' WIDE R.O.W.

LOT 12

LOT 6

**LEGEND**

- = FOUND CONCRETE COUNTY MONUMENT
- = FOUND IRON PIPE STAKE
- = FOUND IRON REBAR STAKE
- ⦿ = SET IRON REBAR STAKE
- (XXX) = RECORDED AS

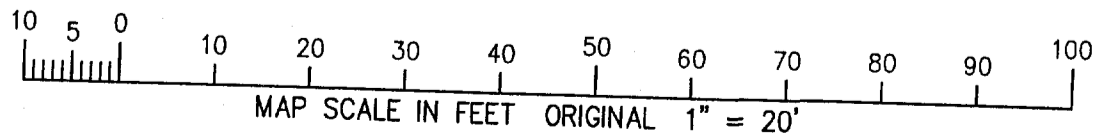


NOTE: COPIES OF THIS MAP TO WHICH THE FOLLOWING CERTIFICATE WILL APPLY SHOW THE SURVEYOR'S ORIGINAL SEAL AND SIGNATURE IN RED INK. COPIES BY ANY OTHER MEANS MAY HAVE ALTERATIONS WHICH DO NOT REPRESENT THE SURVEYOR'S WORK PRODUCT.

I HEREBY CERTIFY THAT THE ABOVE DESCRIBED PROPERTY HAS BEEN SURVEYED UNDER MY DIRECTION AND THAT THE ABOVE MAP IS A TRUE REPRESENTATION THEREOF AND SHOWS THE SIZE AND LOCATION OF THE PROPERTY AND ITS EXTERIOR BOUNDARIES. THIS SURVEY IS MADE FOR THE USE OF THE PRESENT OWNERS OF THE PROPERTY, AND ALSO THOSE WHO PURCHASE, MORTGAGE, OR GUARANTEE THE TITLE THERETO WITHIN ONE YEAR FROM THE DATE HEREOF.

DATED: 04-04-1994

REVISED 06-11-2005  
TO SHOW SIZE & LOCATION OF  
AS BUILT RESIDENCE

*Peter S. Gordon*  
PETER S. GORDON R.L.S. 2101

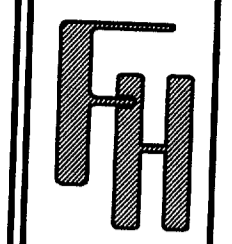

WORK ORDERED BY -  
DENNIS CONDON  
CONDON CONSTRUCTION, INC.  
1521 EAST RACINE STREET  
JANESVILLE, WI 53545

FARRIS, HANSEN & ASSOCIATES, INC.  
ENGINEERING - ARCHITECTURE - SURVEYING  
7 RIDGWAY COURT P.O. BOX 437  
ELKHORN, WISCONSIN 53121  
OFFICE: (262) 723-2098 FAX: (262) 723-5886

REVISIONS

PROJECT NO.	4031.05
DATE:	02/07/03
SHEET NO.	1 OF 1

6/11/2005 X:\Projects\4031\0\_cad\Lot\_05

005-2875

SCT# 00005