
HAROLD M. KOLB

REGISTERED PROFESSIONAL LAND SURVEYOR

LAKE GENEVA, WISCONSIN

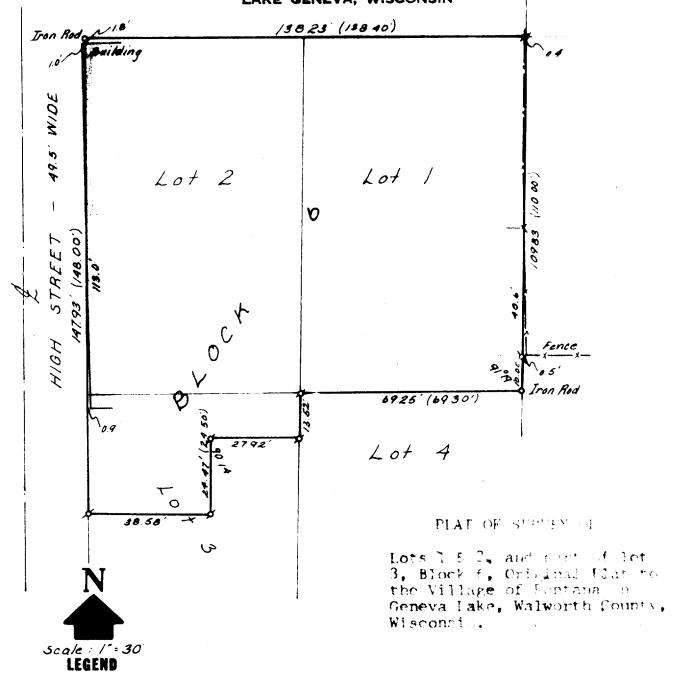

φ - IRON PIPE FOUND

O - IRON PIPE PLACED

● - CONCRETE MONUMENT

X - SPIKE

() PLATTED AS

HAROLD H.
KOLB
1187
LAKE GENEVA

SUF THE PROPERTY OF THE PROPE

I. HAROLD H. KOLB, DO HEREBY CERTIFY THAT I HAVE SURVEYED THE PROPERTY HEREON DESCRIBED ACCORDING TO THE OFFICIAL RECORDS, AND THAT THE PLAT HEREON IS A CORRECT REPRESENTATION OF THE LOT LINES.

Harold W. Holl

HAROLD H. KOLB WISCONSIN REGISTERED LAND SURVEYOR, S-187

DATE <u>Feb. 25, 1972</u>

5-23/