


PREPARED FOR:  
 GARY VOYDA  
 209 CHATEAUGAY RD.  
 NAPERVILLE, IL  
 60450

# PLAT OF SURVEY

PATHFINDER SURVEYING INC.  
 N3705 WILLOWBEND LANE  
 LAKE GENEVA, WI, 53147  
 262-248-3697

- OF -

LOT 5, BLOCK 12 OF GLENWOOD SPRINGS SUBDIVISION, LOCATED IN THE VILLAGE OF FONTANA-ON-GENEVA LAKE, WALWORTH COUNTY, WISCONSIN.

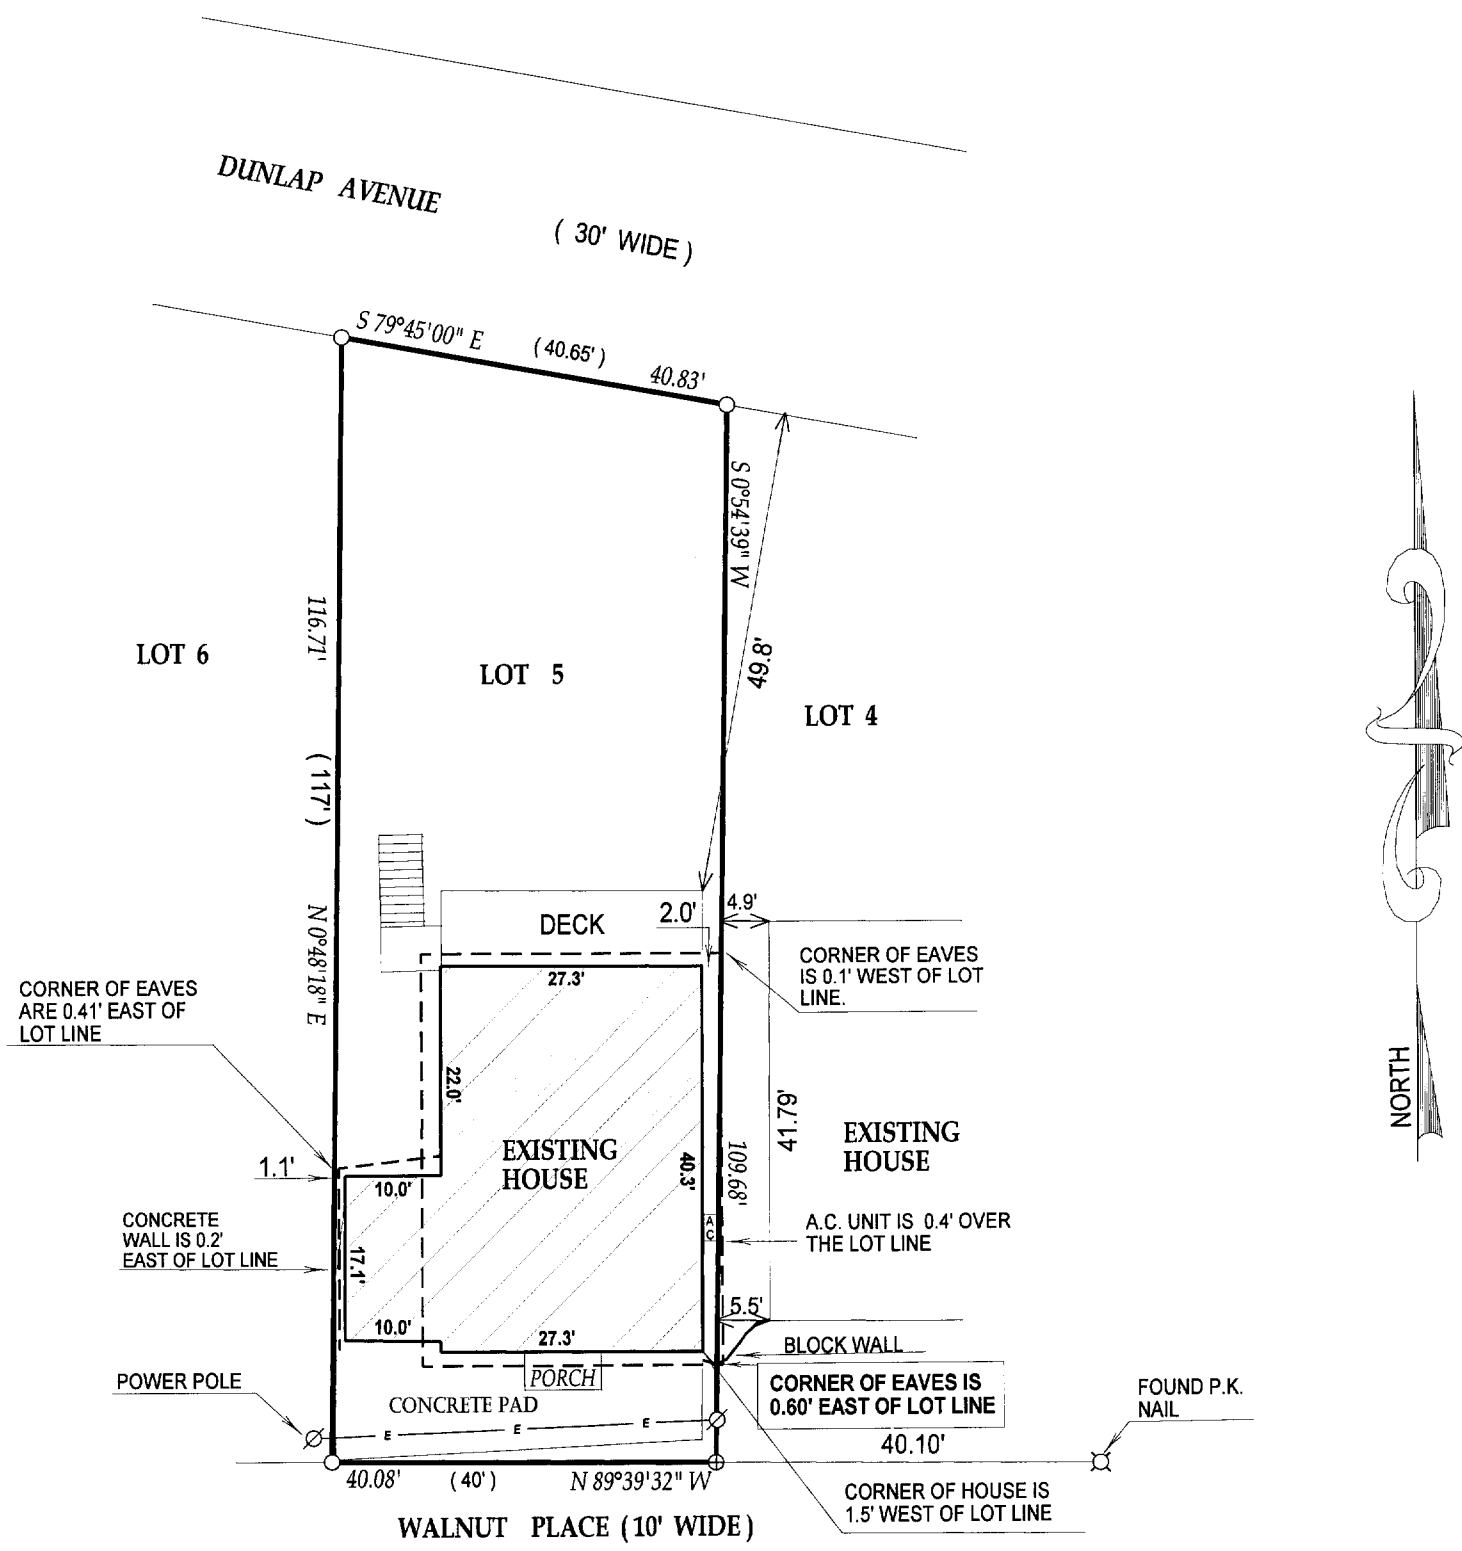

SGS-63

005-2339