


GEORGE T. DUNHAM
SURVEYING & SUBDIVIDING
DELAVAN, WISCONSIN

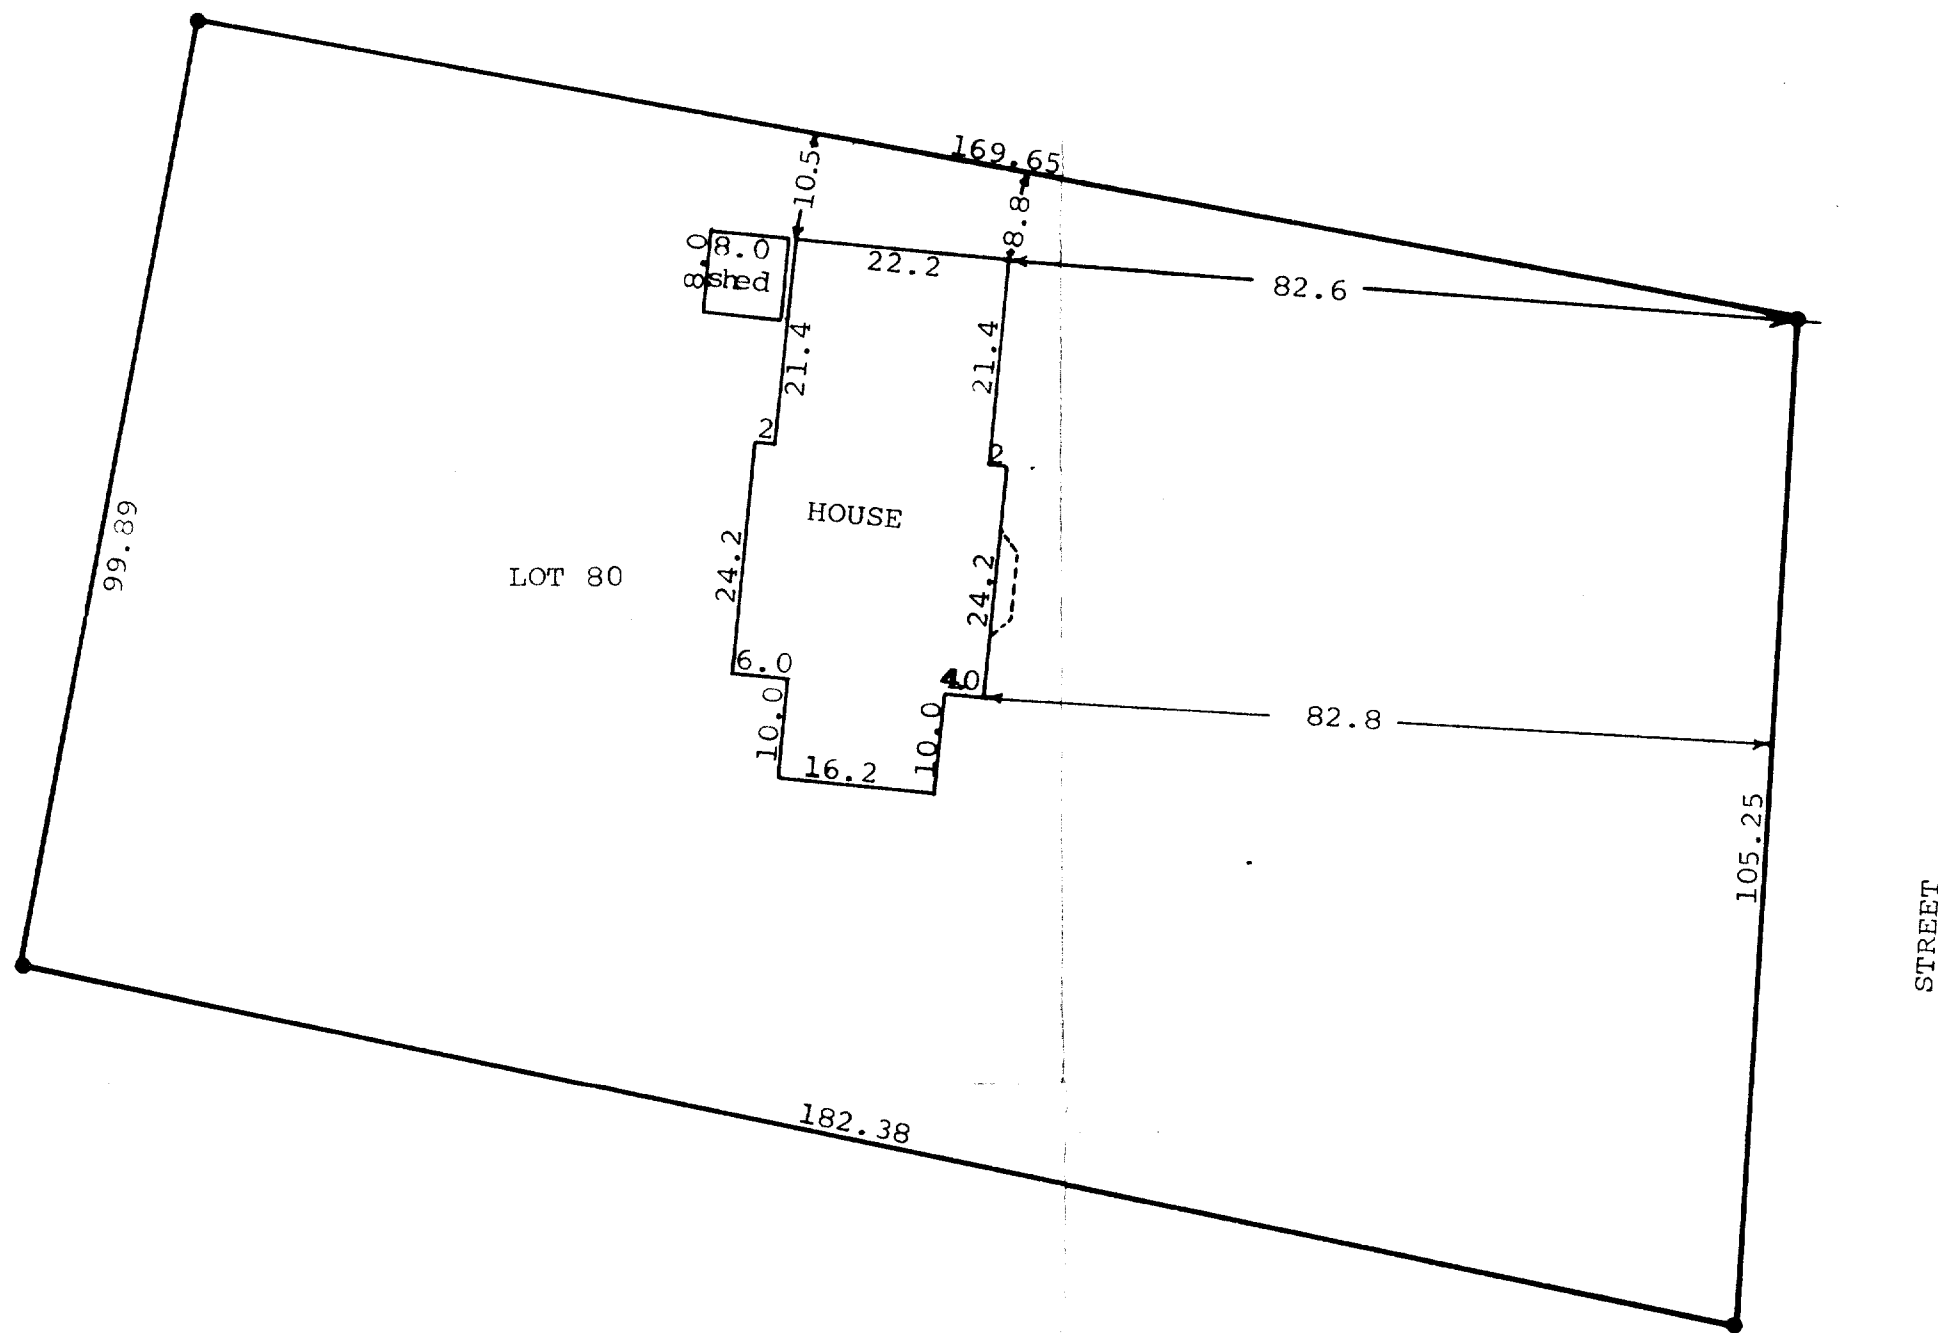


Scale - 1" = 20'
● = Iron Pipe in Concrete

STATE OF WISCONSIN) SS
COUNTY OF WALWORTH)

I, George T. Dunham, Surveyor, certify that I have surveyed the property described as follows,
Lot 80 in Country Club Estates Unit No. 2, Village of Fontana, Walworth County, Wisconsin,
and that the above plat is an accurate survey and a true representation thereof and correctly shows the exterior boundary lines and location of buildings on said property and the correct measurements thereof.
September 23, 1971

George T. Dunham
George T. Dunham, Surveyor

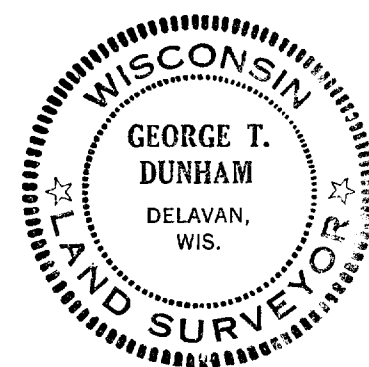

5-243