

ABELL
SURVEYING & MAPPING

1140 SEQUOIA STREET • DELAVAN, WISCONSIN 53115
262-728-6737

N




SCALE 1"=20'

LEGEND

⊘ - IRON PIPE FOUND
() - RECORDED AS

(60')

ELEVATION ON PEAK OF
GARAGE ROOF = 112.04'

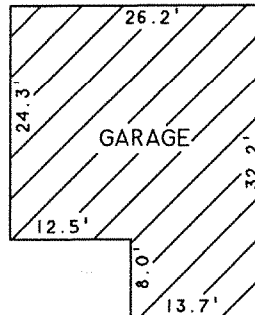

13'

(132')

LOT 12

(132')

LOT 11

LOT 13


BLOCK

PLAT OF

GARAGE ROOF ELEVATION ON LOT 12,
BLOCK 13, OF THE ORIGINAL PLAT
OF THE VILLAGE OF FONTANA-ON-
GENEVA LAKE, WALWORTH COUNTY,
WISCONSIN.

(60')

BENCHMARK ASSUMED ON TOP
OF IRON PIPE = 100.00'

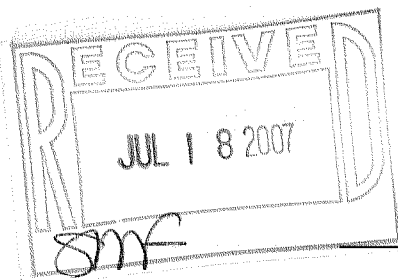

KINZIE STREET

(FIRST AVENUE)

66'

David F. Abell

DAVID F. ABELL
WISCONSIN REGISTERED LAND SURVEYOR, S-1596

ORDERED BY: R & D BUILDERS
3116 ROYAL OAKS DRIVE
ELKHORN, WI 53121

May 9, 2007

DATE: May 9, 2007 JOB NUMBER - 07031
NOTE: THIS IS NOT A CERTIFIED COPY UNLESS SEALED.

SOP - 83A

005-2473