

1140 SEQUOIA STREET • DELAVAN, WISCONSIN 53115  
262-728-6737 1



SCALE 1" = 10'

### LEGEND

- O - IRON PIPE FOR BENCHMARK SET  
 X-----X - CHAINLINK FENCE  
100|8 - SPOT ELEVATION

○ ← BENCHMARK ON TOP OF IRON  
PIPE ASSUMED 100.00'


ROADWAY

ELEVATION OF PEAK  
OF ROOF 129.6'

HOUSE #465D

PLAT OF

HOUSE LOCATION (465D) LOCATED IN UNRECORDED BELVIDERE PARK, BEING PART OF OUTLOT 51 OF THE ASSESSORS PLAT NO. 1 AMENDED AND PART OF TAX PARCEL STFV-71, LOCATED IN THE VILLAGE OF FONTANA-ON-GENEVA LAKE, WALWORTH COUNTY, WISCONSIN.

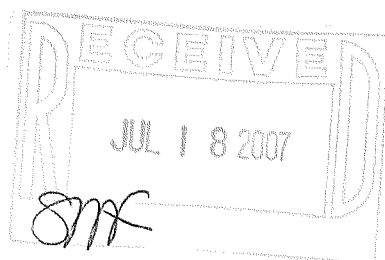

David F. Bell

DAVID F. ABELL  
WISCONSIN REGISTERED LAND SURVEYOR, S-1596

ORDERED BY: ZELL'S WOODWORKING INC.  
1299 CENTER STREET  
DELAYAN, WI 53115

June 27, 2007

DATE \_\_\_\_\_ JOB NUMBER - 07032  
NOTE: THIS IS NOT A CERTIFIED COPY UNLESS SEALED.

STFV-71

005-2476