

Geneva

Lake

Water elevation 864.3
December 18, 2006.

Plat of Survey


of

A parcel of land described in a Warranty Deed recorded November 6, 2006 as Document No. 692811 as shown below:

Outlot 55 and the East 20 feet of Outlot 56. Assessors Plat No. 1 of the Village of Fontana-on-Geneva Lake, County of Walworth, State of Wisconsin, also described as follows: Commence at a point in the East and West quarter lines of Sec. 13, T1N, R16E, of the 4th P.M., being in the County of Walworth and State of Wisconsin, 595.89 feet being in the East line of said Section; thence West in said East and West quarter line of said Section 13, 115.78 feet, thence N. 1° E. 905.17 feet to a point in the shore of Geneva Lake at low water mark; thence Northeast along the shore of said lake at low water line to a point in a line that is 926.01 feet N. 1° E from the place of beginning, thence S 1° West, 926.01 feet to the place of beginning.

Surveyed for: A.J. Madden & Sons, Construction

414 Arlington Avenue
Elmhurst, Illinois 60126

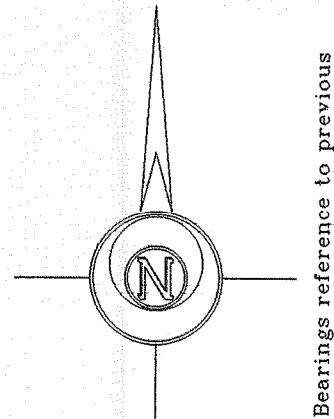


Detail

1"=20'

Geneva

Lake

Water elevation 864.3
December 18, 2006.

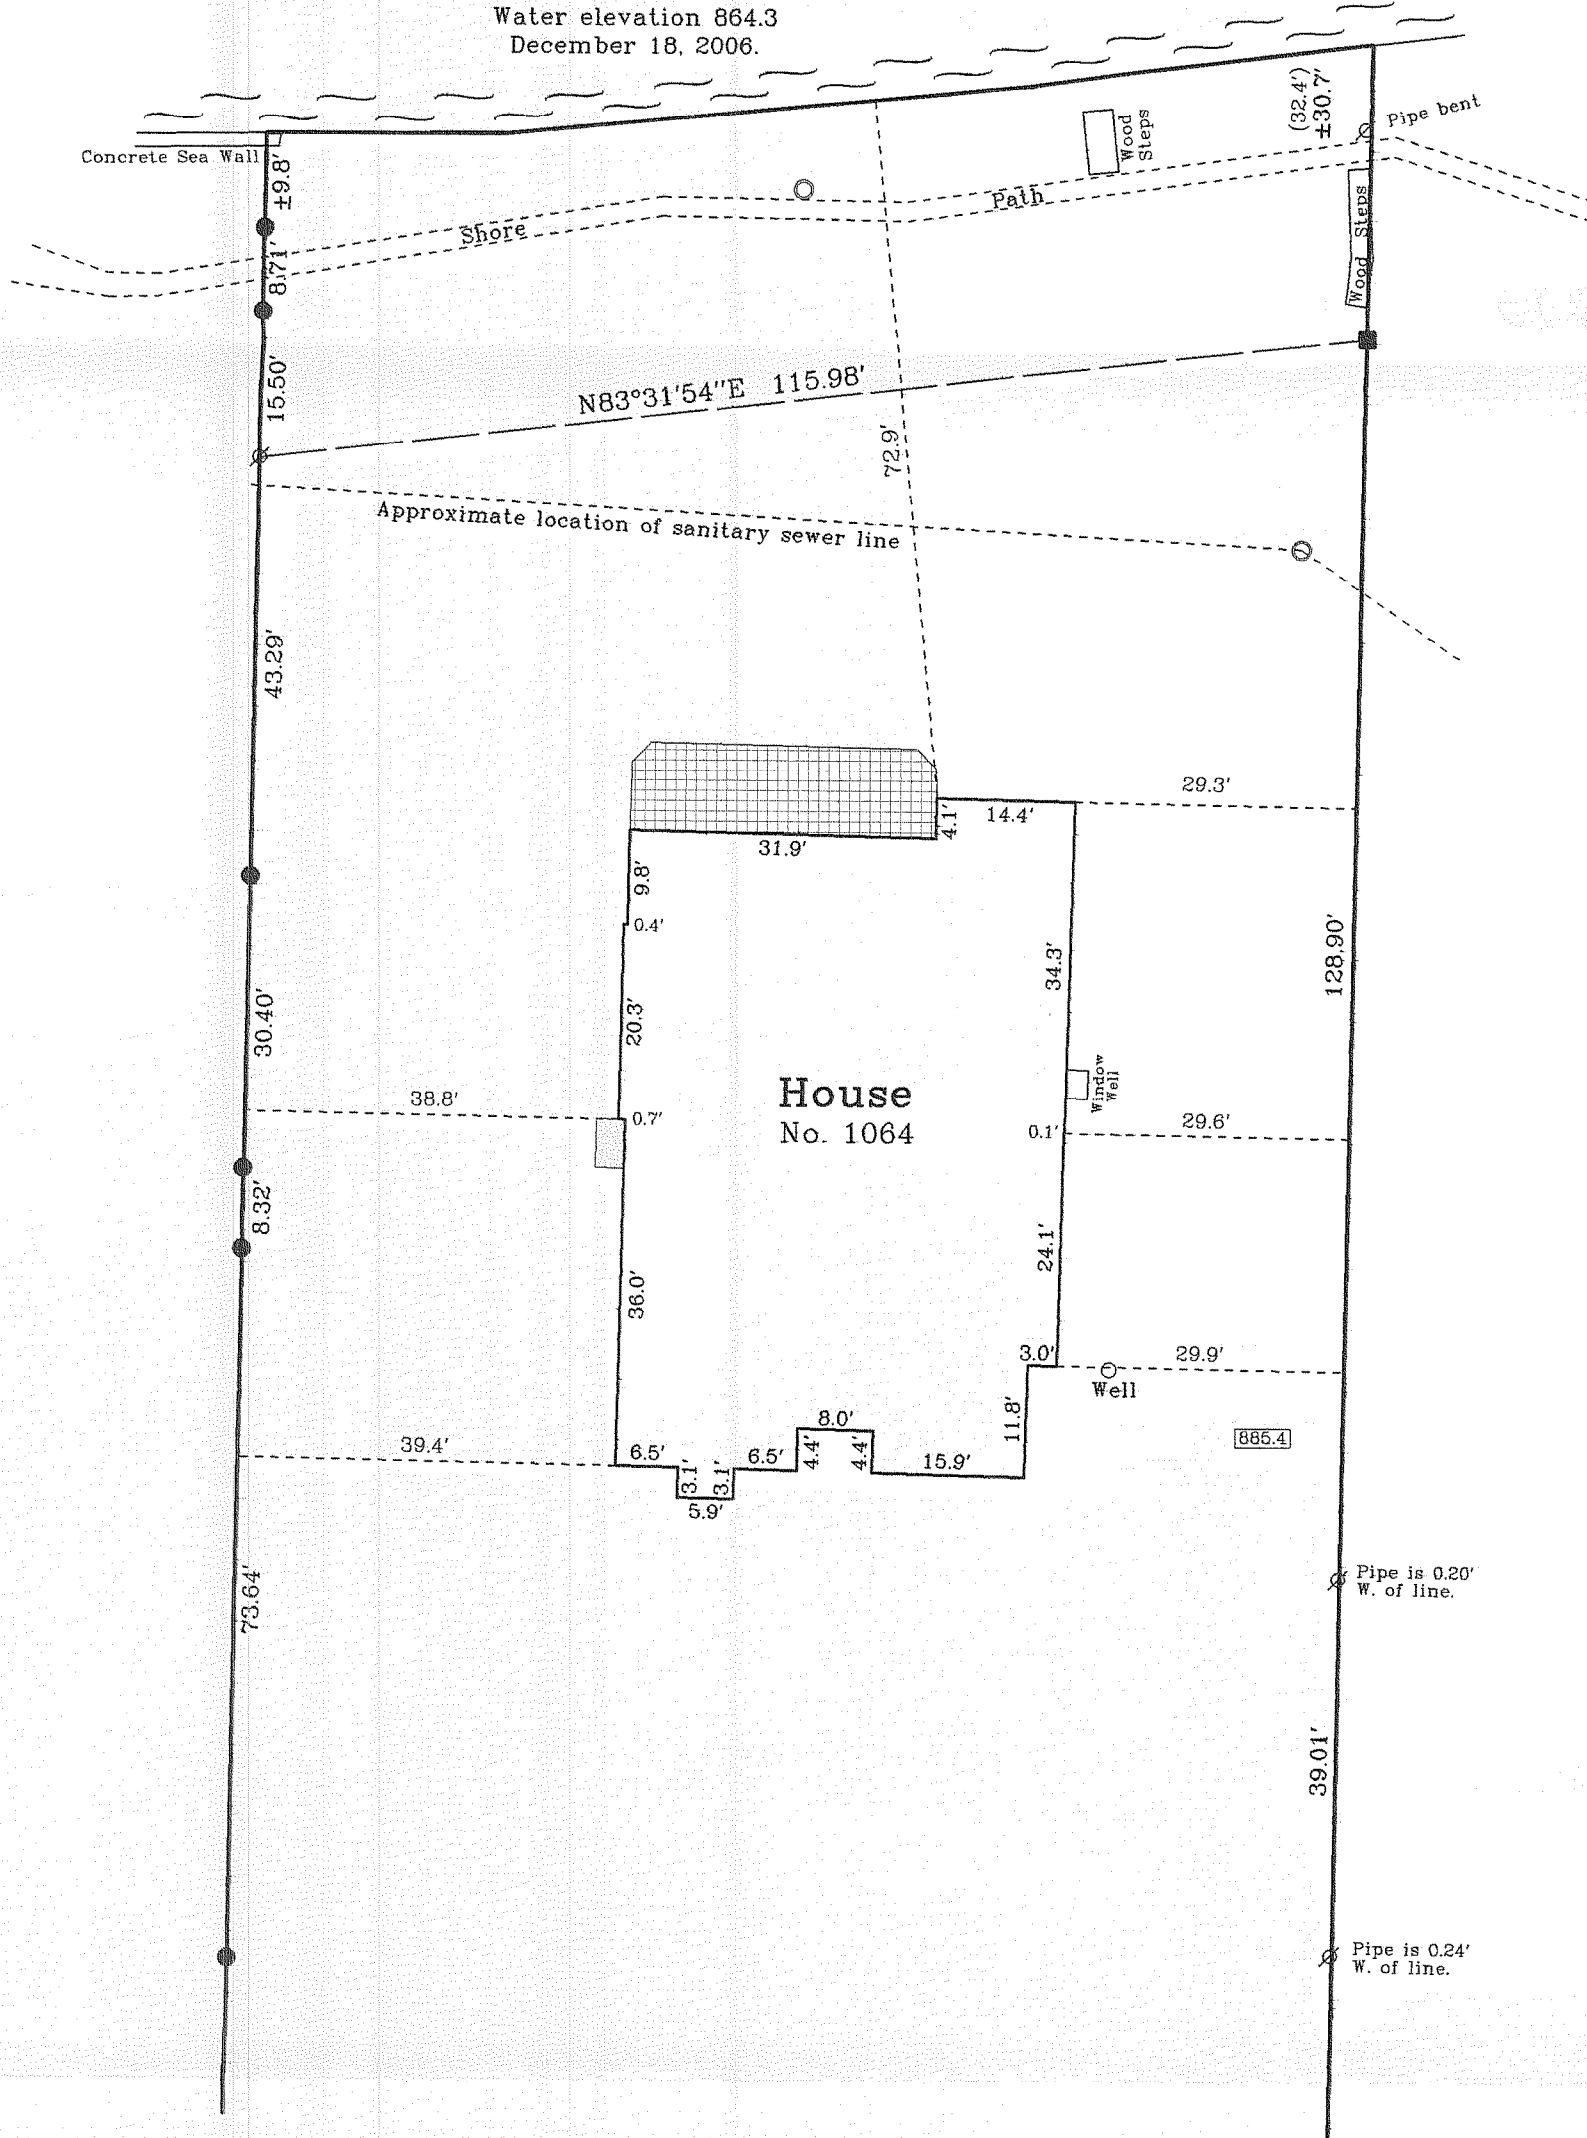

East 1/4 Corner
Section 13-1-16.
N. 202.305.74
E. 2.396.316.73

Copyright © 2007 by Jensen & Olson Land Surveying, LLC.



All rights reserved. No part of this survey plat may be reproduced or transmitted in any form by any means - graphic, electronic, or mechanical, including photocopying, tracing, or information storage and retrieval systems - without permission in writing from Douglas G. Olson, Jensen & Olson Land Surveying, LLC.

I, Douglas G. Olson, Wisconsin Registered Land Surveyor, do hereby certify that this survey was performed by me or under my direction in full compliance with the owner's/agent's instructions and Chapter A-E 7 of the Wisconsin Administrative Code "Minimum Standards for Property Surveys", and that this map is an accurate representation thereof to the best of my knowledge and belief.

Douglas G. Olson
Wisconsin Registered Land Surveyor - 2093

Notes:

- This survey plat is not certified unless signed and sealed in red ink.
- This survey is subject to Wisconsin lien laws. This Plat of Survey is the notice of intent to file lien. Lien waiver required.

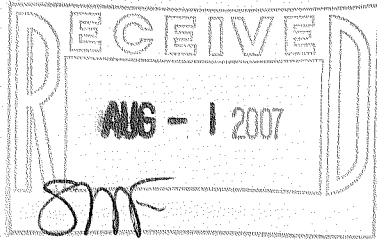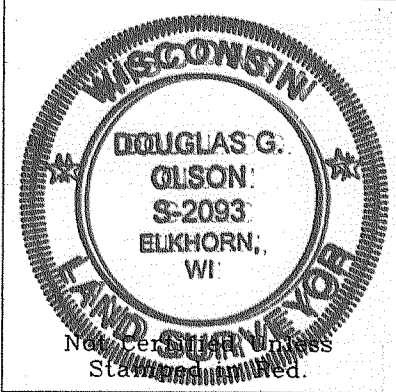

Sheet 1 of 1 Sheets.

Job Reference Number

2006.142

Legend

- Found County Section Corner
- Found Concrete Monument
- Found Iron Pipe
- Found Iron Rod
- Recorded Information
- Manhole
- Fire Hydrant
- Utility Pole
- Asphalt Surface
- Concrete Surface
- Brick Surface
- Deciduous Tree
- Coniferous Tree
- Spot Elevation




Jensen & Olson Land Surveying, LLC

45 South Wisconsin Street P.O. Box 322
Elkhorn, Wisconsin. 53121
Telephone: (262) 723-3434
Facsimile: (262) 723-8044

Scale in Feet

1" = 40'

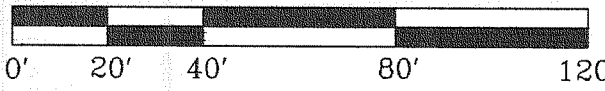

Survey date: December 18, 2006.

Revisions: No. 1 - Proposed Addition
No. 2 - As-built

STFV-79

005-2479