


ELEVATIONS OF EXISTING RESIDENCE ON LOT 7, BLOCK 12, GLENWOOD SPRINGS SUBDIVISION, VILLAGE OF FONTANA-ON-GENEVA, WALWORTH COUNTY, WISCONSIN

THIS IS A RESURVEY OF A SURVEY BY ROBERT M. BAERENWALD DATED 5/2/1996

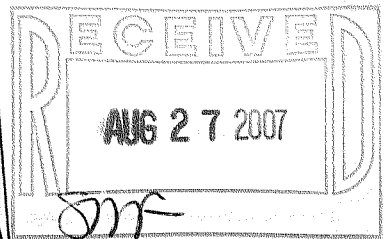


ROOF PEAK ELEV = 140.6'
LOWEST GROUND = 104.1'

OWNER: INGRID A. GEVAVI TRUST
333 N. CANAL ST #1906
CHICAGO, IL 60606

BUILDING HEIGHT = 36.5'

NOTE: THIS IS A CURRENT
BUILDING HEIGHT, WHICH IS
THE SAME AS BEFORE THE
HOUSE WAS RAISED FOR A
FOUNDATION.

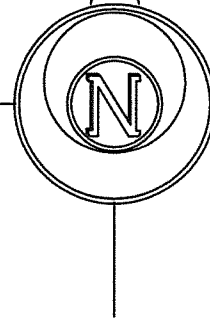

SEE PETER S. GORDON
SURVEY DATED 4/4/02

BENCHMARK
TOP NAIL HEAD OF 60-PENNY
NAIL SE SIDE OF 42' TREE
ASSUMED ELEV = 100.00

LOT 7
2,160 SQ. FT.

LOT 6
SEE GEORGE T. DUNHAM
SURVEY DATED 7/20/1984

LEGEND

- FOUND IRON PIPE
- FOUND IRON ROD
- FOUND RR SPIKE OR PK NAIL
- CUT CROSS IN CONCRETE/ STONE WALL
- SET IRON ROD, 24" LONG, WEIGHING 1.5 LBS./LINEAL FT., 3/4" DIA.
- RECORDED AS DIMENSION

SCALE: 1" = 20 FEET

"I hereby certify that the above described property has been surveyed by me or under my direction and that the above map is a true representation thereof and shows the size and location of the property, its exterior boundaries, the location of all visible structures and dimensions of all principal buildings thereon, boundary fences, apparent easements, roadways and visible encroachments, if any."
"This survey is made for the use of the present owners of the property, and also those who purchase, mortgage, or guarantee the title thereto within one year from date hereof."

R.R. SPIKE P.K. NAIL

Mark L. Miritz
MARK L. MIRITZ
WISCONSIN REGISTERED
LAND SURVEYOR S-2582

DATE: JUNE 21, 2007 JOB NO. 06.1110

N9330 KNUTESON DRIVE
WHITWATER, WI 53190

LAND-MARK SURVEYING

www.Land-MarkSurveying.com

PHONE: (262) 495-3284
CELL: (262) 949-1239
FAX: (262) 495-8421

SGS-65

005-2485

