

ASSIGNED THE WESTERLY BOUNDARY
OF LOT F27 N 27°29'00" E

FARRIS, HANSEN & ASSOCIATES, INC.

ENGINEERING - ARCHITECTURE - SURVEYING
7 RIDGWAY COURT - P.O. BOX 437 - ELKHORN, WISCONSIN 53121
PHONE: (262) 723-2098 FAX: (262) 723-5886




PLAT OF SURVEY OF

LOT F27 OF ADDITION F TO COUNTRY CLUB
ESTATES, LOCATED IN THE SW 1/4 OF THE
SE 1/4 OF SECTION 14, T 1 N, R 16 E,
VILLAGE OF FONTANA-ON-GENEVA LAKE,
WALWORTH COUNTY, WISCONSIN.

- WORK ORDERED BY -
KEEFE REAL ESTATE
751 GENEVA PARKWAY
LAKE GENEVA, WI 53147

LEGEND

- SET IRON REBAR STAKE
- FOUND CONCRETE MONUMENT
- FOUND IRON PIPE STAKE
- (XXX)-RECORDED AS

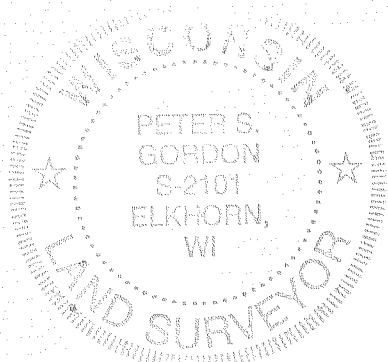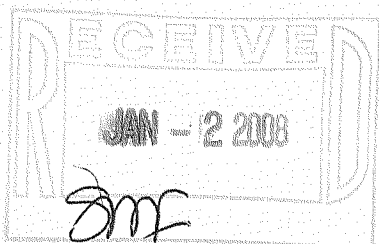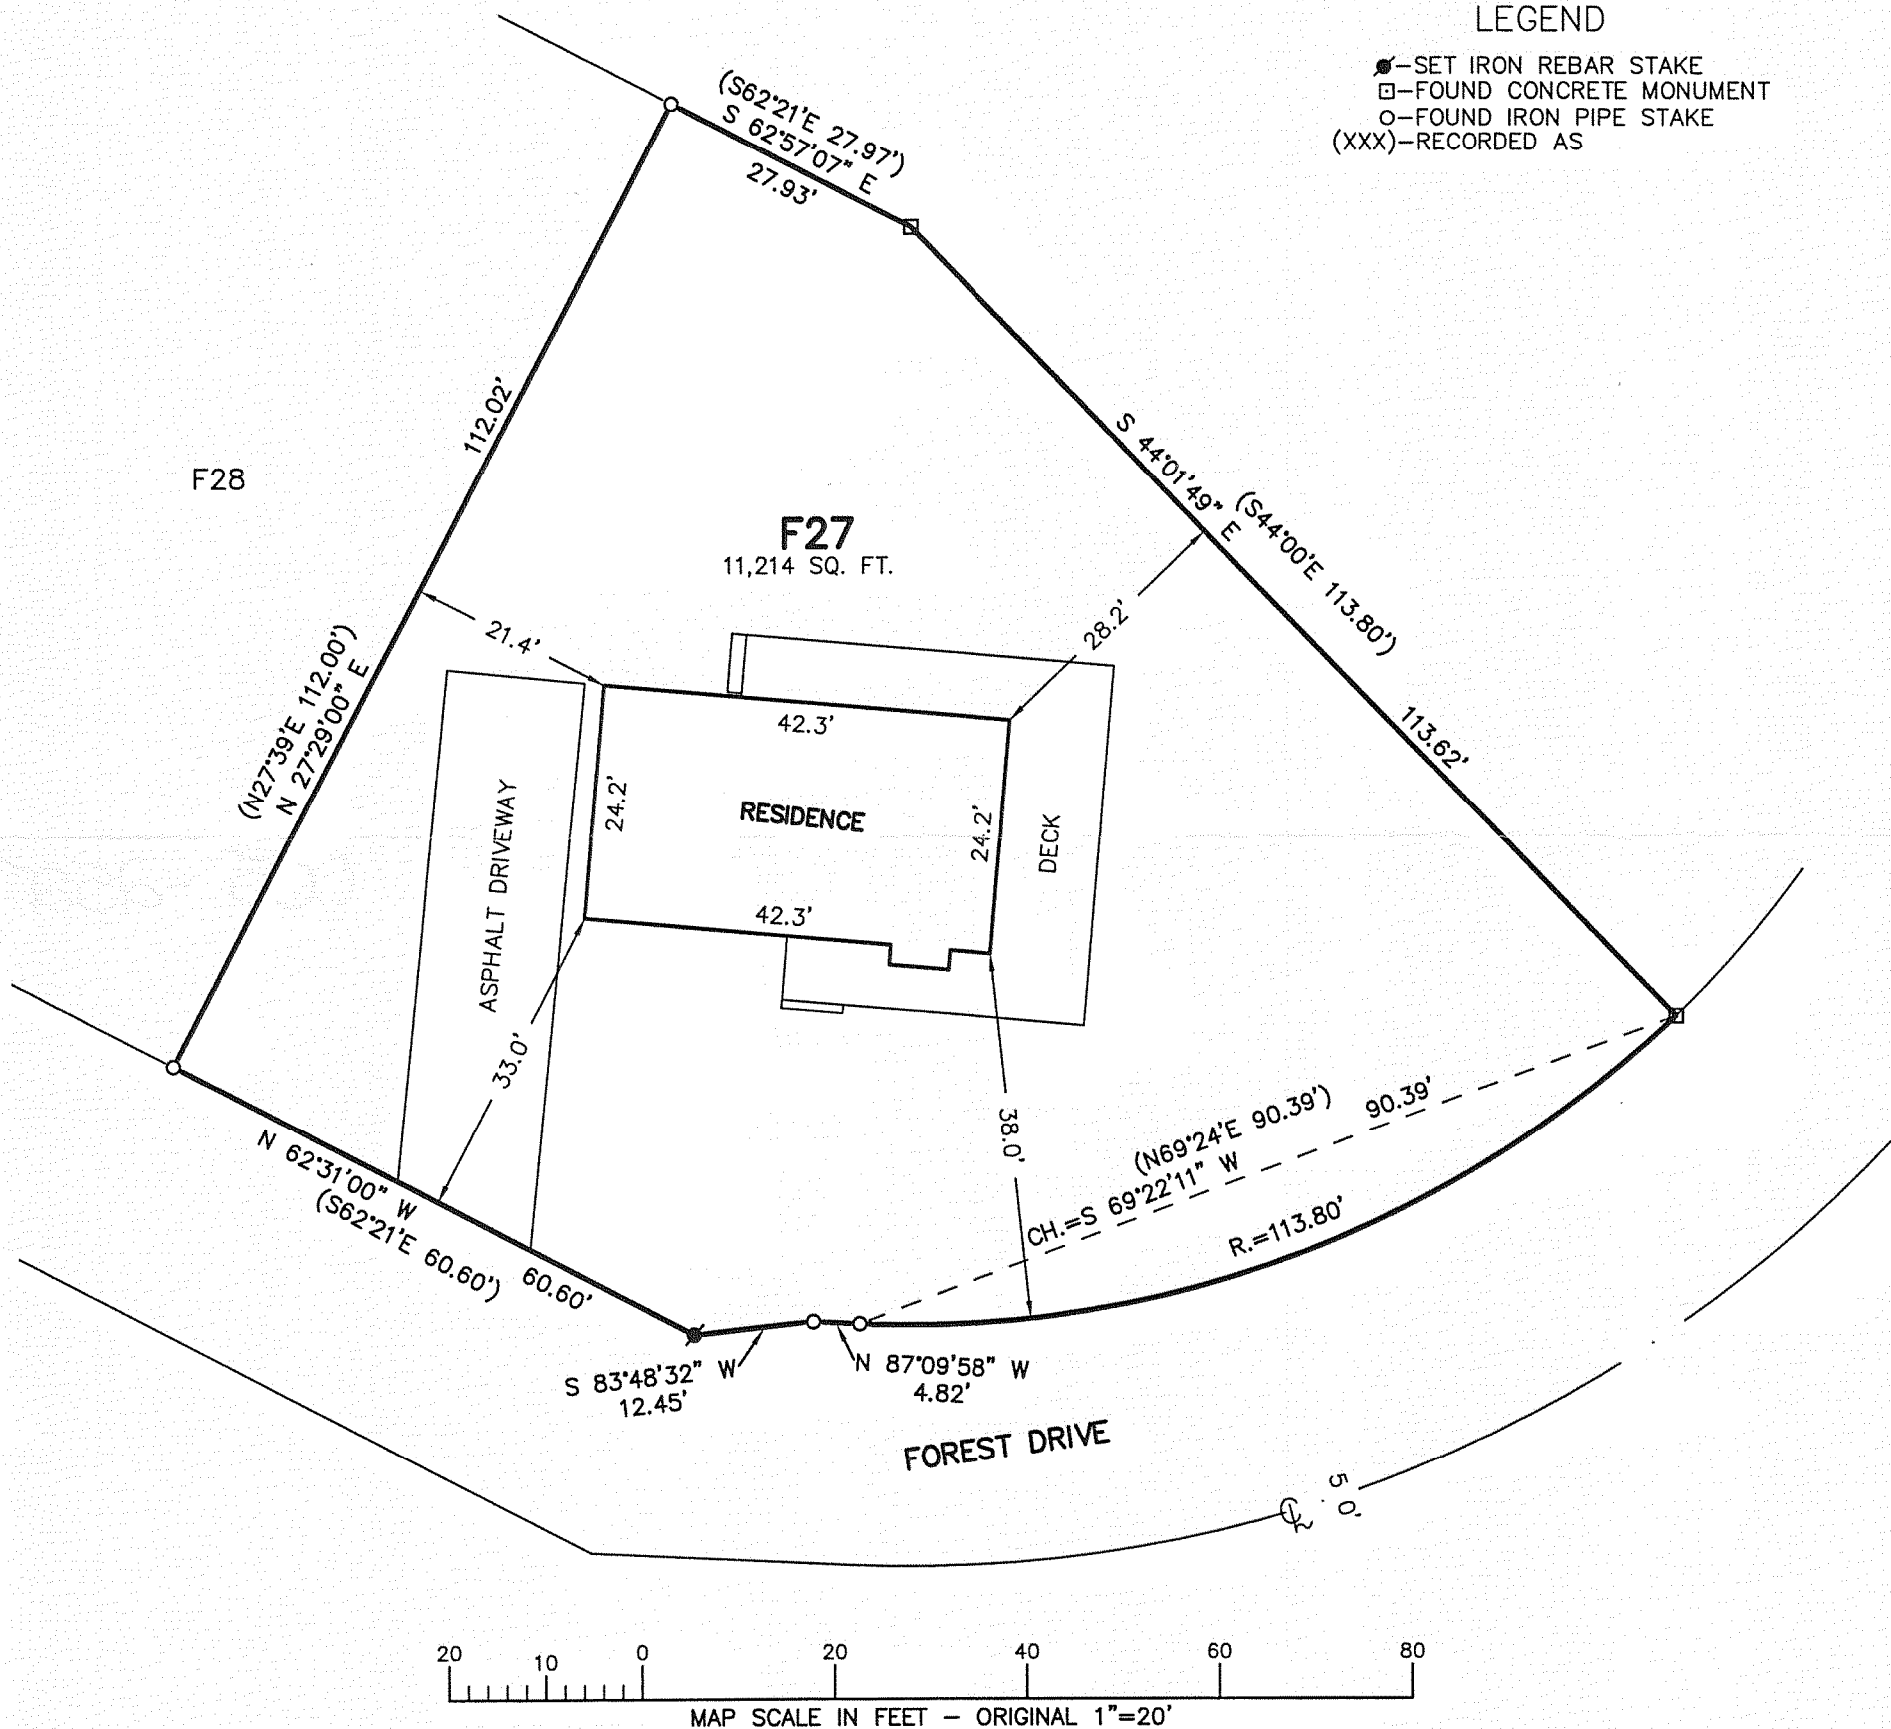

NOTE: COPIES OF THIS MAP TO WHICH THE FOLLOWING CERTIFICATE
WILL APPLY SHOW THE SURVEYOR'S ORIGINAL SEAL AND SIGNATURE
IN RED INK. COPIES BY ANY OTHER MEANS MAY HAVE ALTERATIONS
WHICH DO NOT REPRESENT THE SURVEYOR'S WORK PRODUCT.

I HEREBY CERTIFY THAT THE ABOVE DESCRIBED PROPERTY HAS BEEN
SURVEYED UNDER MY DIRECTION AND THAT THE ABOVE MAP IS A TRUE
REPRESENTATION THEREOF AND SHOWS THE SIZE AND LOCATION OF
THE PROPERTY AND ITS EXTERIOR BOUNDARIES. THIS SURVEY IS
MADE FOR THE USE OF THE PRESENT OWNERS OF THE PROPERTY, AND
ALSO THOSE WHO PURCHASE, MORTGAGE, OR GUARANTEE THE TITLE
THERE TO WITHIN ONE YEAR FROM THE DATE HEREOF.

DATED: 10/31/2007

Signature of Peter S. Gordon
PETER S. GORDON R.L.S. 2101

PROJECT: 7471
DATE: 10/31/2007
SHEET 1 OF 1

OCT 31 2007

SCTF-27

005-2527