


**PLAT OF SURVEY**  
**-OF-**  
**LEGAL DESCRIPTION AS FURNISHED**


LOTS 11 AND 12, BLOCK 9 OF THE ORIGINAL PLAT OF THE VILLAGE OF FONTANA ON GENEVA LAKE. WALWORTH COUNTY, WISCONSIN. EXCEPTING THEREFROM THE SOUTH 10 FEET OF SAID LOTS 11 AND 12 FOR HIGHWAY PURPOSES.

SURVEY FOR: ROSSELAND REAL ESTATE  
 SURVEY ADDRESS: 138 FONTANA BOULEVARD

NOTE: REFER TO A CURRENT TITLE REPORT FOR EASEMENTS AND RESTRICTIONS WHICH MAY AFFECT THIS SITE.

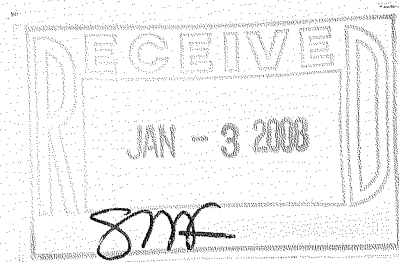

S.T.H. "67" (variable width)

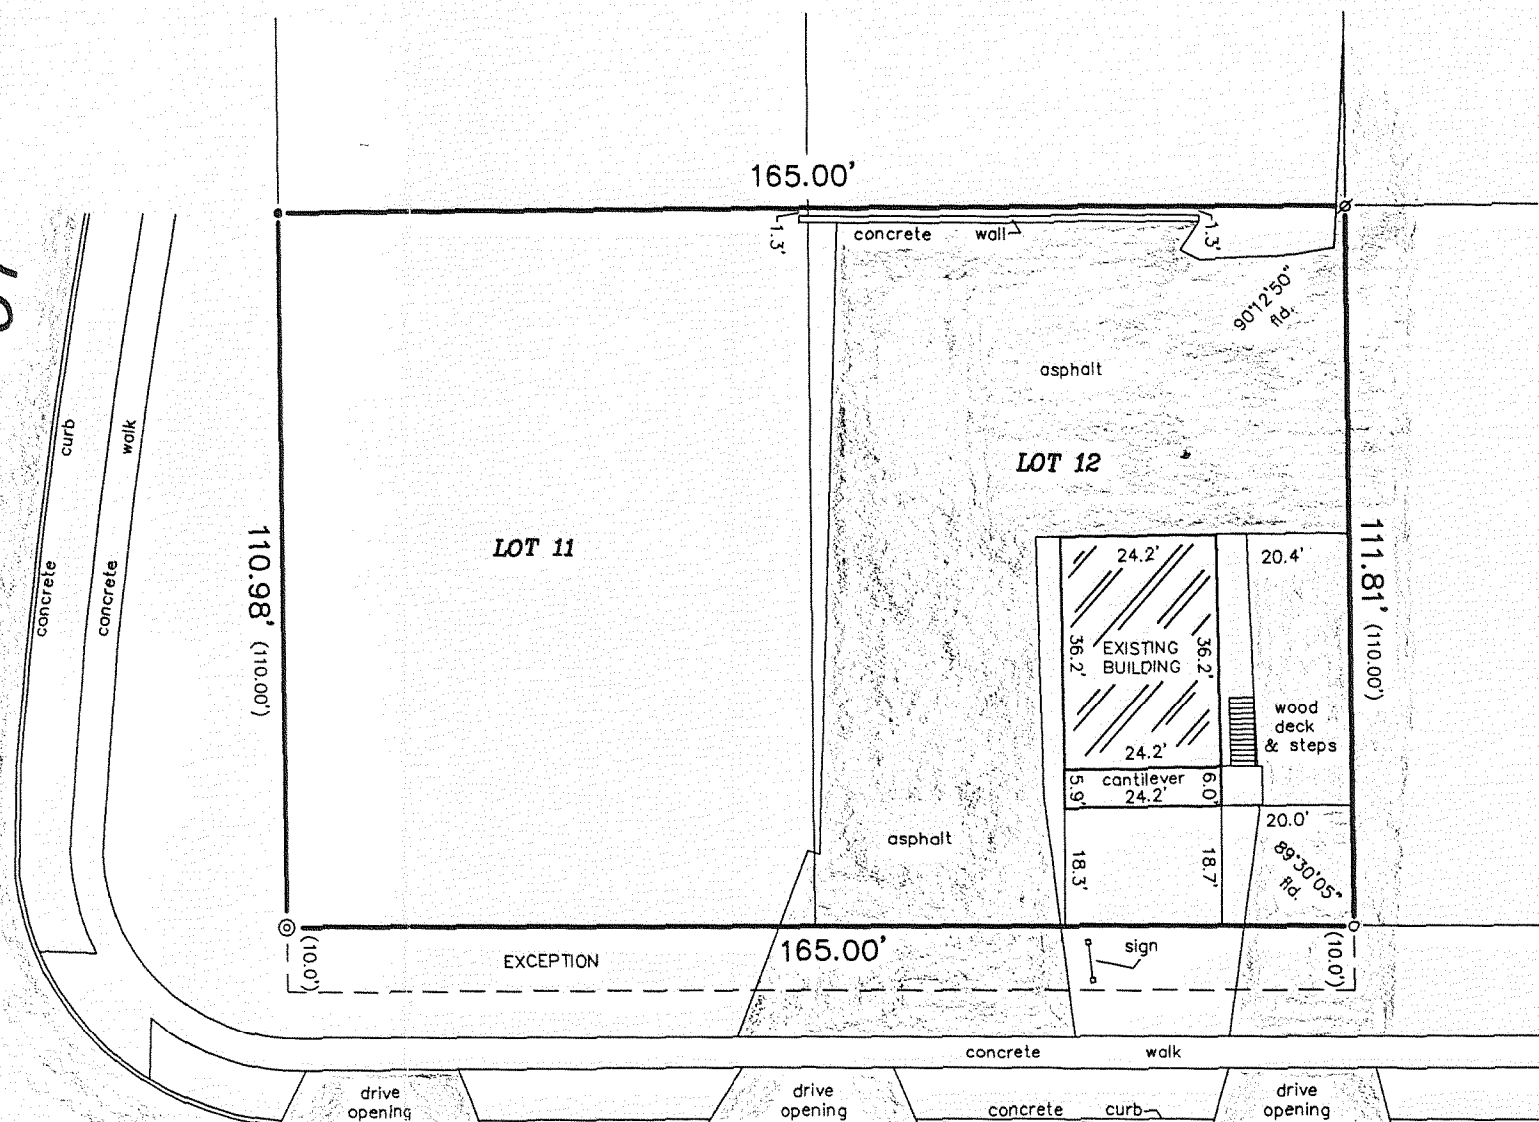


**FONTANA** (variable width) **BOULEVARD**

SCALE 1" = 30'

**LEGEND**

- FOUND IRON PIPE
- ⊙ FOUND CONCRETE MONUMENT
- SET IRON PIPE
- ⊗ SET MASONRY NAIL
- ( ) RECORDED AS

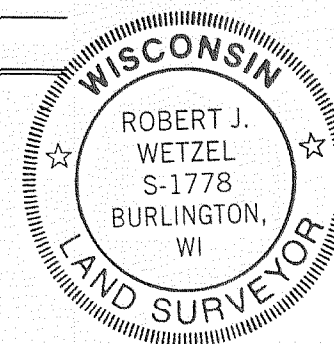


THIS IS NOT AN ORIGINAL PRINT  
 UNLESS THIS SEAL IS RED.

*Robert J. Wetzel*  
 ROBERT J. WETZEL S-1778

SEPTEMBER 12, 2007  
 DATE

7691  
 JOB NUMBER

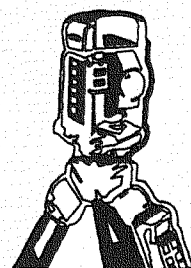

**B.W. SURVEYING, INC.**  
 LAND SURVEYS  
 MAPPING AND PLANNING  
 412 N. PINE STREET  
 BURLINGTON, WI 53105  
 (262)-767-0225

50P-52A

005-2540