

PREPARED FOR:
MAUREEN MARINO
42 STEEPLE RIDGE CT.
OAK BROOK IL. 60523.

PLAT OF SURVEY


KROTT SURVEYING INC.
N3705 WILLOW BEND LANE
LAKE GENEVA WI. 53147
PHONE # (262)248-3697
FAX # (262)249-0639

-OF-

LOTS 2 AND 3, BLOCK 15, GLENWOOD SPRINGS SUBDIVISION,
LOCATED IN SECTION 14, TOWN 1 NORTH, RANGE 16 EAST,
VILLAGE OF FONTANA - ON - GENEVA LAKE, WALWORTH
COUNTY, WISCONSIN.

HARVARD AVENUE


(20' WIDE)

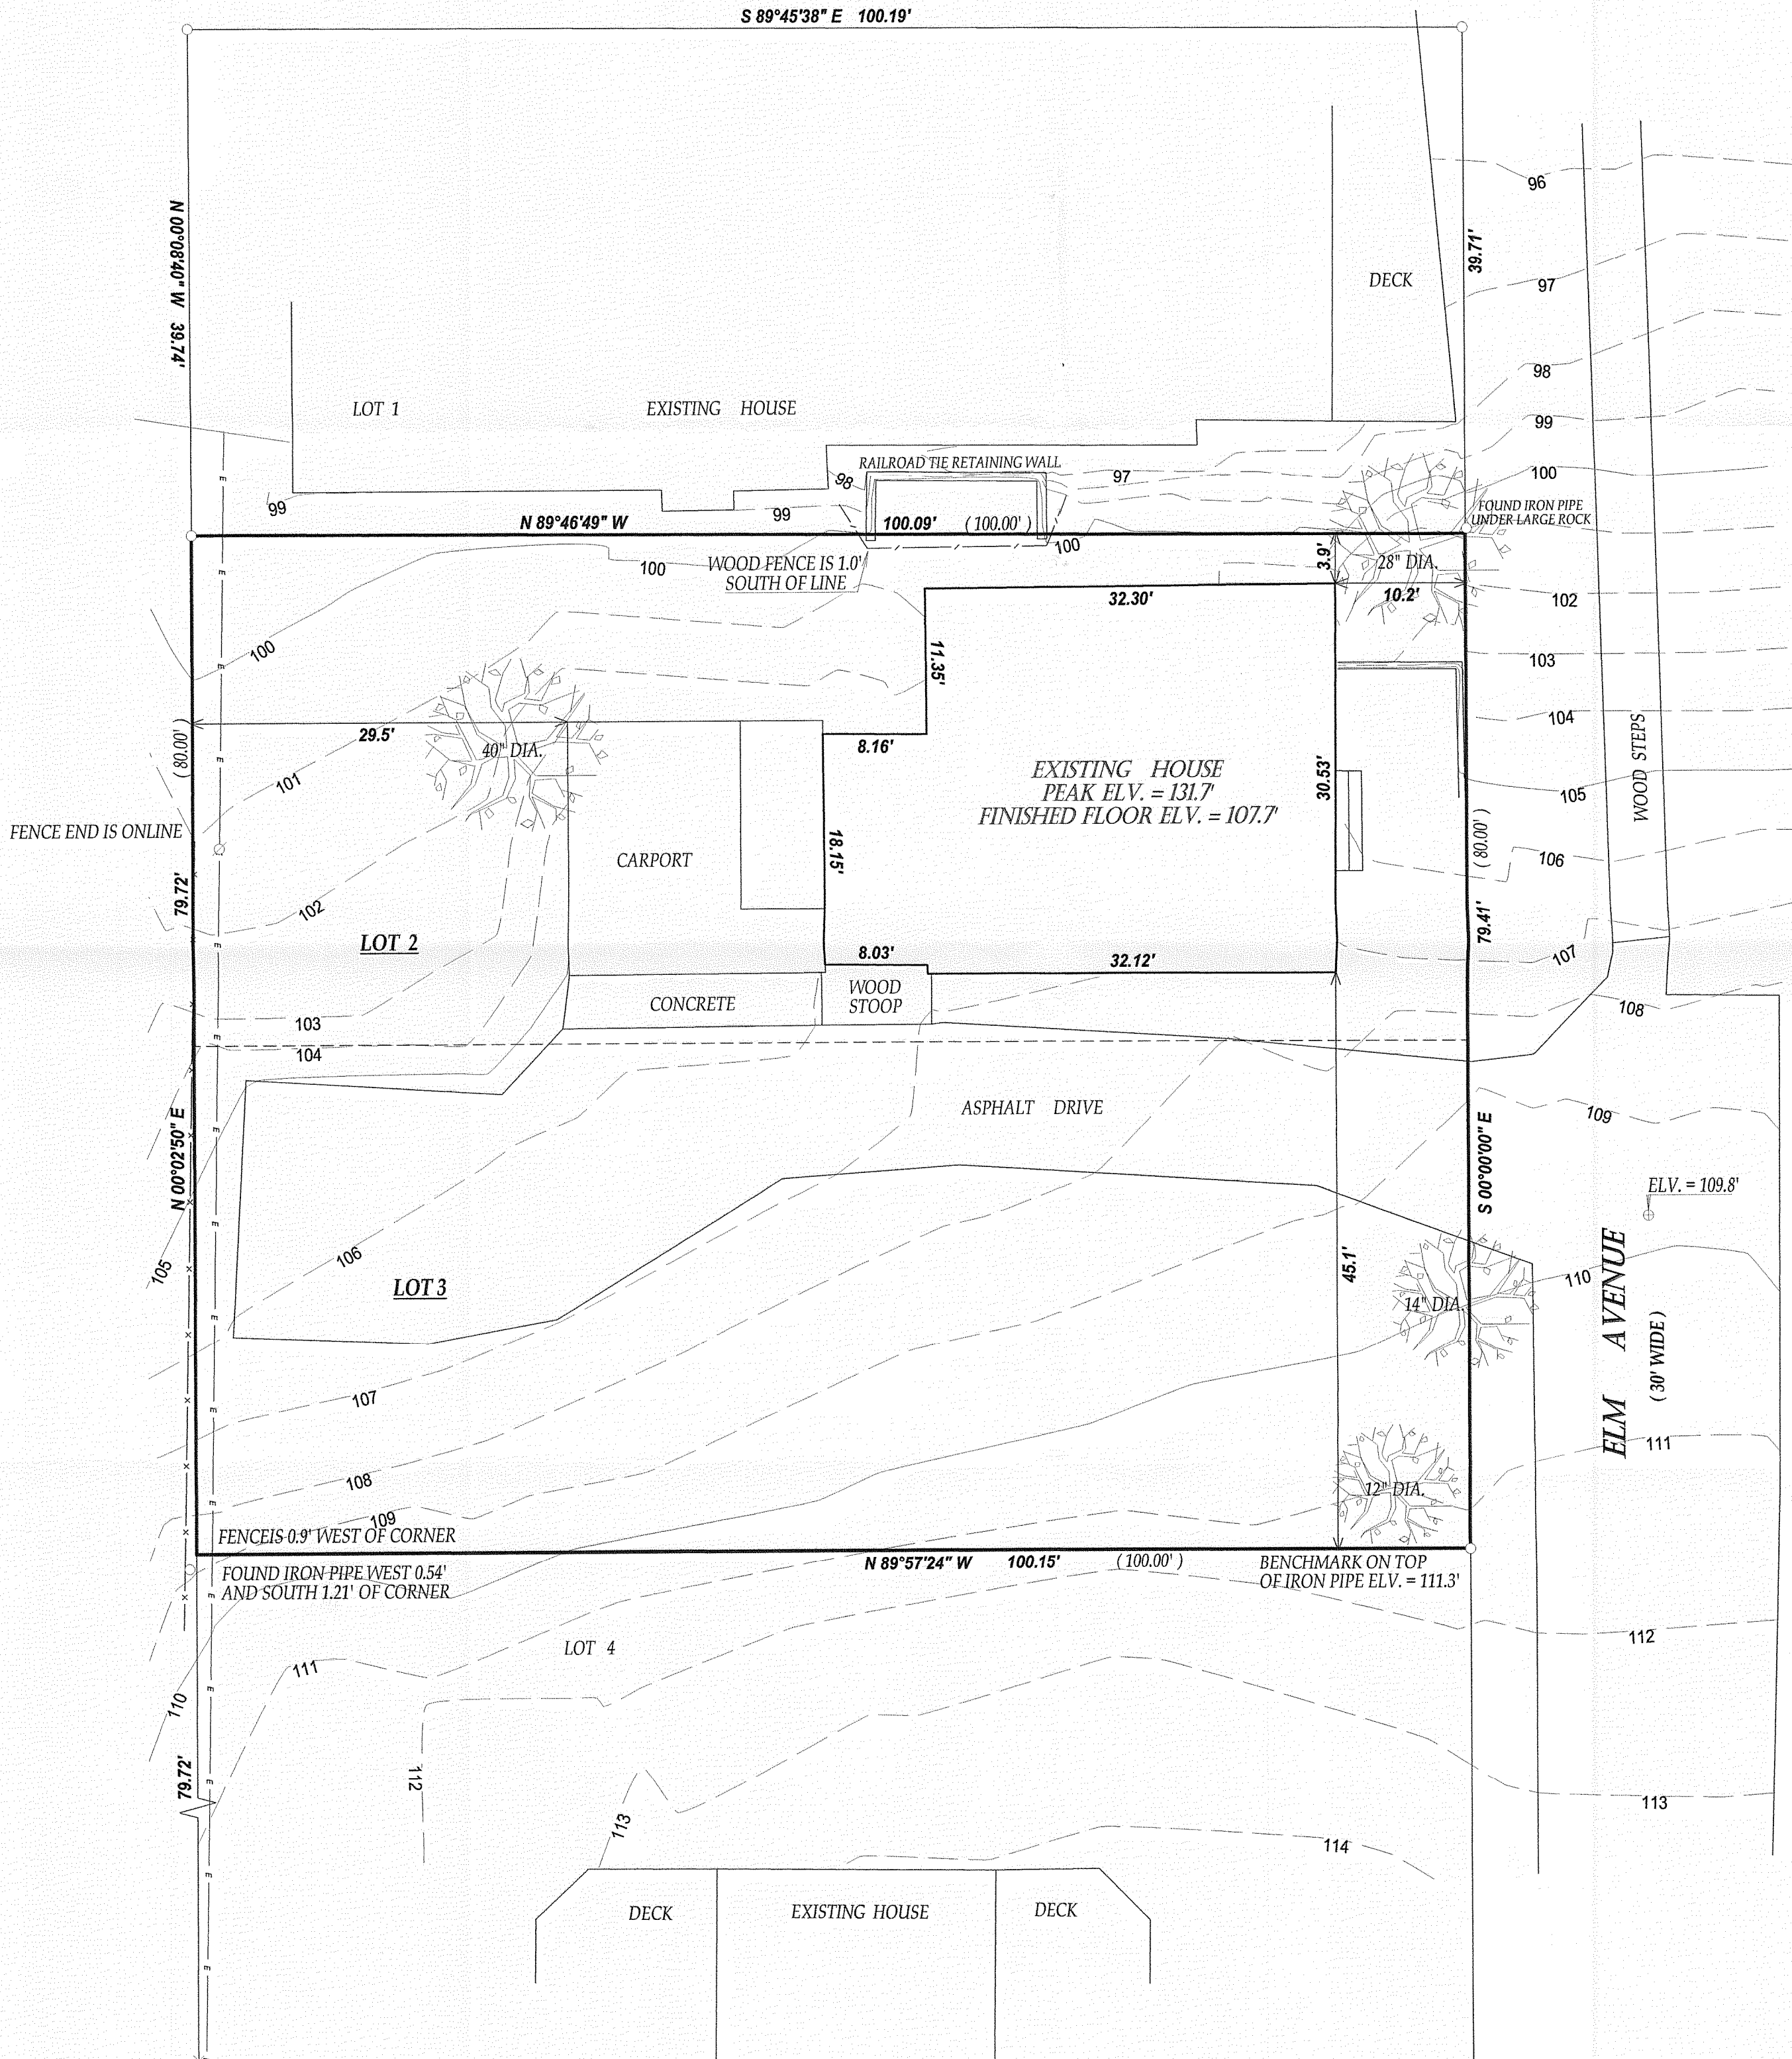

LEGEND

- FOUND IRON PIPE
- × FOUND CUT CROSS IN CONCRETE
- ⊗ POWER POLE
- OVERHEAD WIRES
- ⊕ MANHOLE
- (xx) RECORDED AS

JOB # 08-007 TAX ID # SGS00099
DATED THIS THE 29th DAY OF JANUARY 2008.

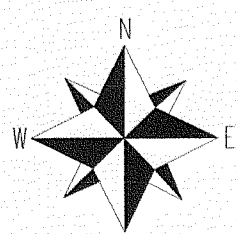


SCALE 1"=10'



NOTE : ELM AVENUE WAS ASSUMED TO BEAR NORTH SOUTH
NOTE : VERTICAL DATUM WAS ASSUMED
NOTE : DUE TO SNOW COVER ALL IMPROVEMENTS MAY NOT BE SHOWN

COMPARE LEGAL DESCRIPTION ABOVE AND DRAWING WITH DEED.
FOR BUILDING RESTRICTIONS AND EASEMENTS NOT SHOWN REFER
TO DEED, ABSTRACT SOURCES AND LOCAL MUNICIPAL CODES. NOTIFY
THE SURVEYOR IMMEDIATELY OF ANY DISCREPANCY.

"I hereby certify that I have surveyed the above described property and that
the above map is a true representation thereof and shows the size and
location of all visible structures, apparent easements and encroachments
if any."
This survey is made for the present owners of the property, and those who
purchase, mortgage, or guarantee the title thereto, within one year from
the date hereof.

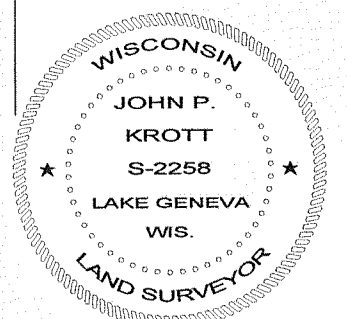

JOHN P. KROTT S-2258
Wisconsin Registered Land Surveyor
(original if signed in red)

595-99

005-2561