



PREPARED FOR:  
 FONTANA BUILDERS  
 1015 TARRANT DR.  
 FONTANA, WI 53125

# PLAT OF SURVEY



KROTT SURVEYING, INC.  
 N3705 WILLOW BEND LANE  
 LAKE GENEVA, WI 53147  
 (262)-248-3697

- OF -

LOT 2, BLOCK 17, IN GLENWOOD SPRINGS, A SUBDIVISION  
 OF A PART OF LOTS NO.3 AND 4 OF THE SE FRACTIONAL 1/4  
 OF SECTION 14, T.1.N., R.16.E., VILLAGE OF FONTANA, WALWORTH  
 COUNTY, WISCONSIN.

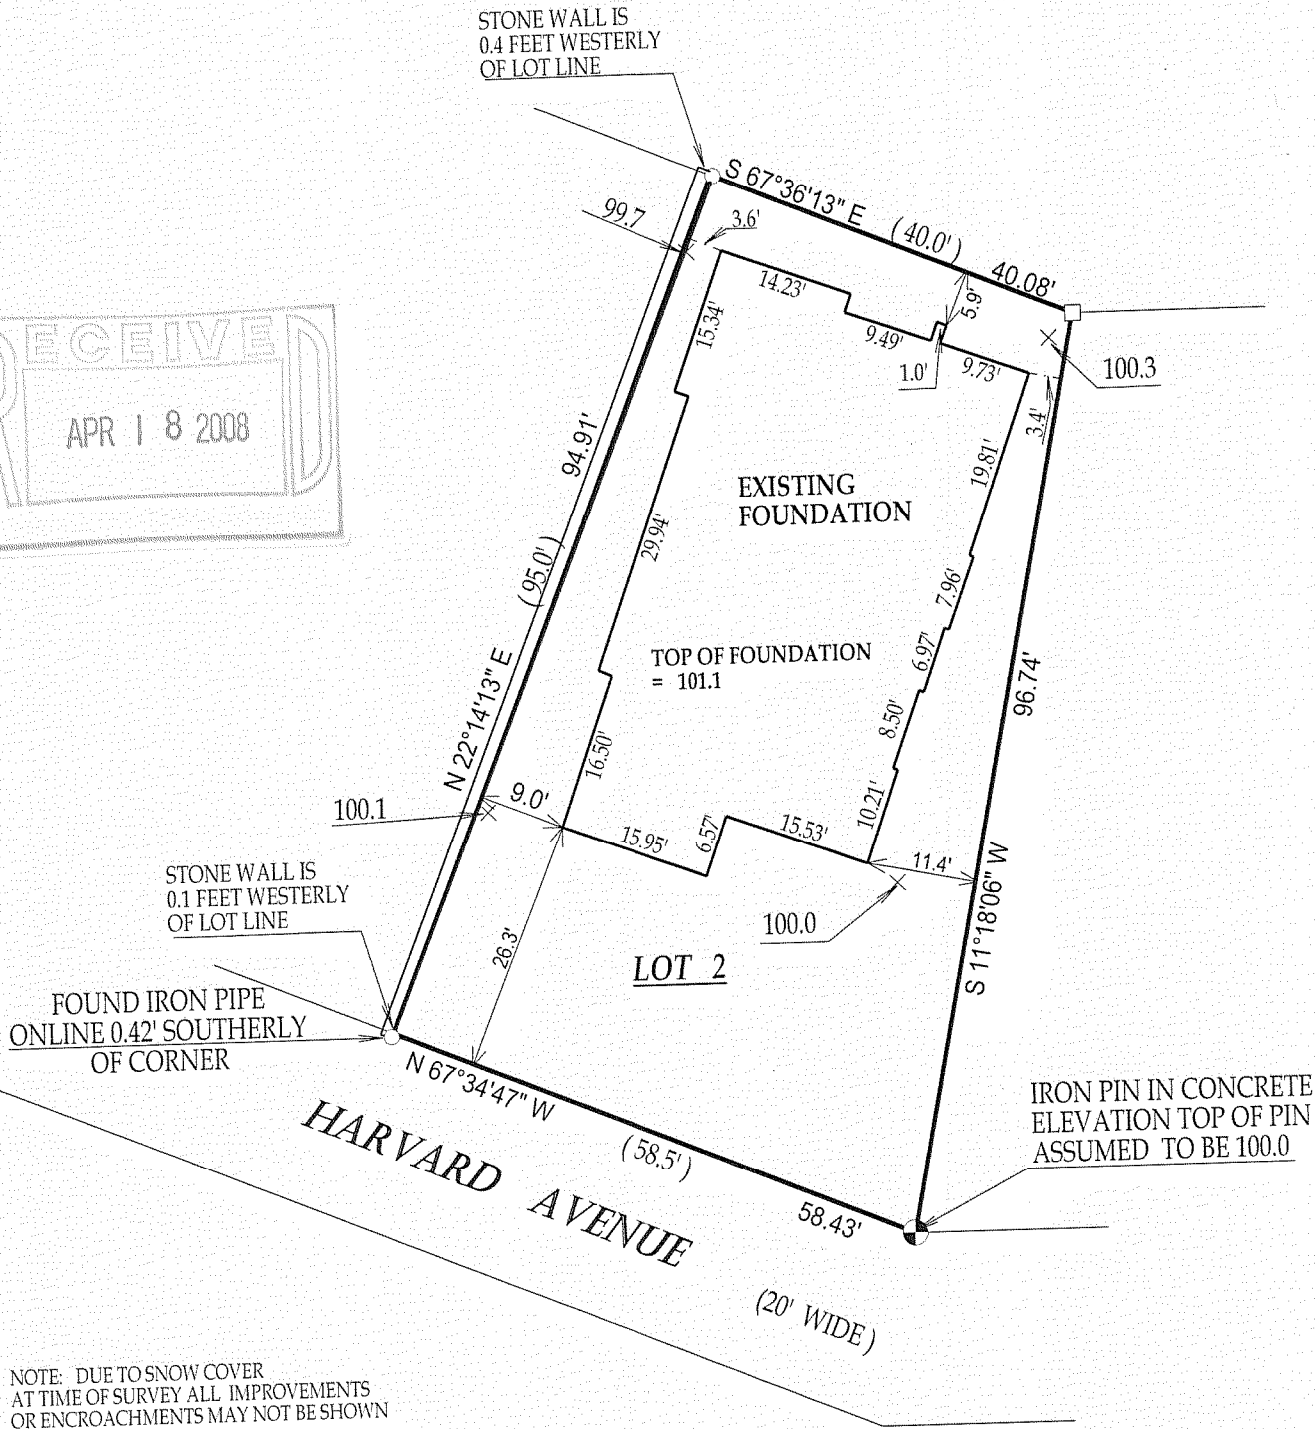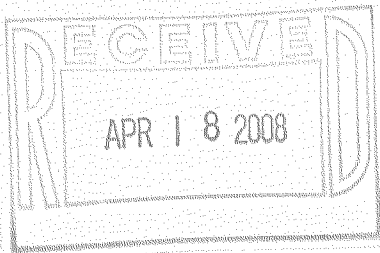

NOTE: DUE TO SNOW COVER AT TIME OF SURVEY ALL IMPROVEMENTS OR ENCROACHMENTS MAY NOT BE SHOWN

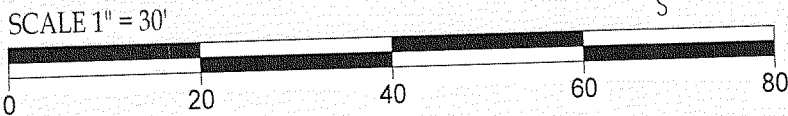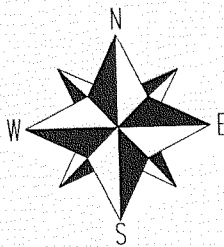


- LEGEND**
- FOUND IRON PIPE
  - FOUND IRON BAR
  - ⊙ FOUND MONUMENT
  - (xx) RECORDED AS

COMPARE LEGAL DESCRIPTION ABOVE AND DRAWING WITH DEED. FOR BUILDING RESTRICTIONS AND EASEMENTS NOT SHOWN, REFER TO DEED, ABSTRACT SOURCES AND LOCAL MUNICIPAL CODES. NOTIFY THE SURVEYOR IMMEDIATELY OF ANY DISCREPANCY.

"I hereby certify that I have surveyed the above described property and that the above map is a true representation thereof and shows the size and location of all visible structures, apparent easements and encroachments if any."

This survey is made for the present owners of the property, and those who purchase, mortgage, or guarantee the title thereto, within one year from the date hereof.

JOB # 07-528AB TAX ID # SGS00124  
 DATED THIS THE 3rd DAY OF JANUARY, 2008

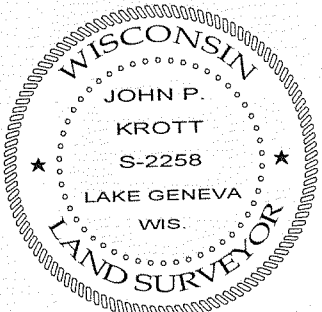

*John P. Krott*  
 JOHN KROTT S - 2258  
 Wisconsin Registered Land Surveyor  
 (original if signed in red)

SGS-124

005-2502