ENGINEERING - ARCHITECTURE - SURVEYING 7 RIDGWAY COURT - P.O. BOX 437 - ELKHORN, WISCONSIN 53121 PHONE: (262) 723-2098 FAX: (262) 723-5886

PLAT OF SURVEY

LOT 5 OF BLOCK 13 OF THE ORIGINAL PLAT OF THE VILLAGE OF FONTANA PART OF THE NW 1/4 SECTION 14 T1N, R16E, WALWORTH COUNTY, WI.

- WORK ORDERED BY -TIM LAROCCA 307 WISNER PARK RIDGE, IL. 60068


FIRST AVENUE 49.5' WIDE ROW SANITARY SEWER 

BLOCK

NORTH LINE

ASSIGNED

N 89'59'24"

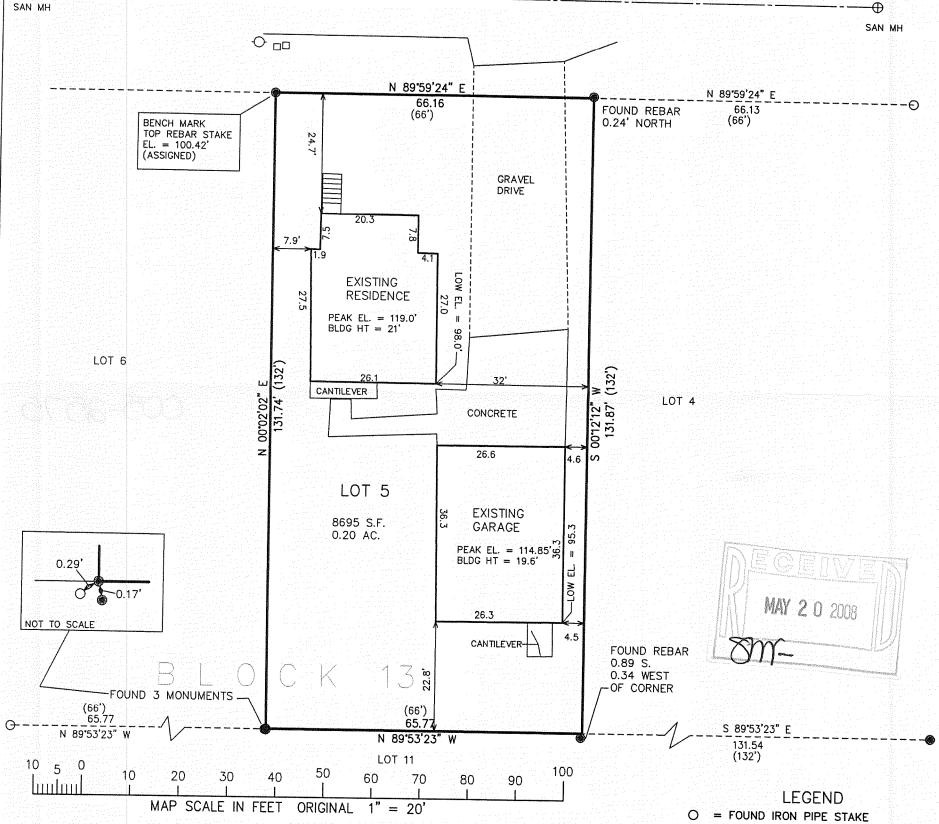

NOTE: COPIES OF THIS MAP TO WHICH THE FOLLOWING CERTIFICATE WILL APPLY SHOW SURVEYOR'S ORIGINAL SEAL AND SIGNATURE IN RED INK. COPIES BY ANY OTHER MEANS MAY HAVE ALTERATIONS WHICH DO NOT REPRESENT THE SURVEYOR'S WORK PRODUCT.

I HEREBY CERTIFY THAT THE ABOVE DESCRIBED PROPERTY HAS BEEN SURVEYED UNDER MY DIRECTION AND THAT THE ABOVE MAP IS A TRUE REPRESENTATION THEREOF AND SHOWS THE SIZE AND LOCATION OF THE PROPERTY AND ITS EXTERIOR BOUNDARIES. THIS SURVEY IS MADE FOR THE USE OF THE PRESENT OWNERS OF THE PROPERTY, AND ALSO THOSE WHO PURCHASE, MORTGAGE, OR GUARANTEE THE TITLE THERETO WITHIN ONE YEAR FROM THE DATE HEREOF.

DATED: MAY 7, 2008

PETER S. GORDON R.L.S. 2101



(XXX) = RECORDED AS

= FOUND IRON REBAR STAKE

PROJECT: 7618 DATE: 05-07-2008

MAY 0 7 2008

SHEET 1 OF 1