
## GEORGE T. DUNHAM SURVEYING & SUBDIVIDING DELAYAN, WISCONSIN

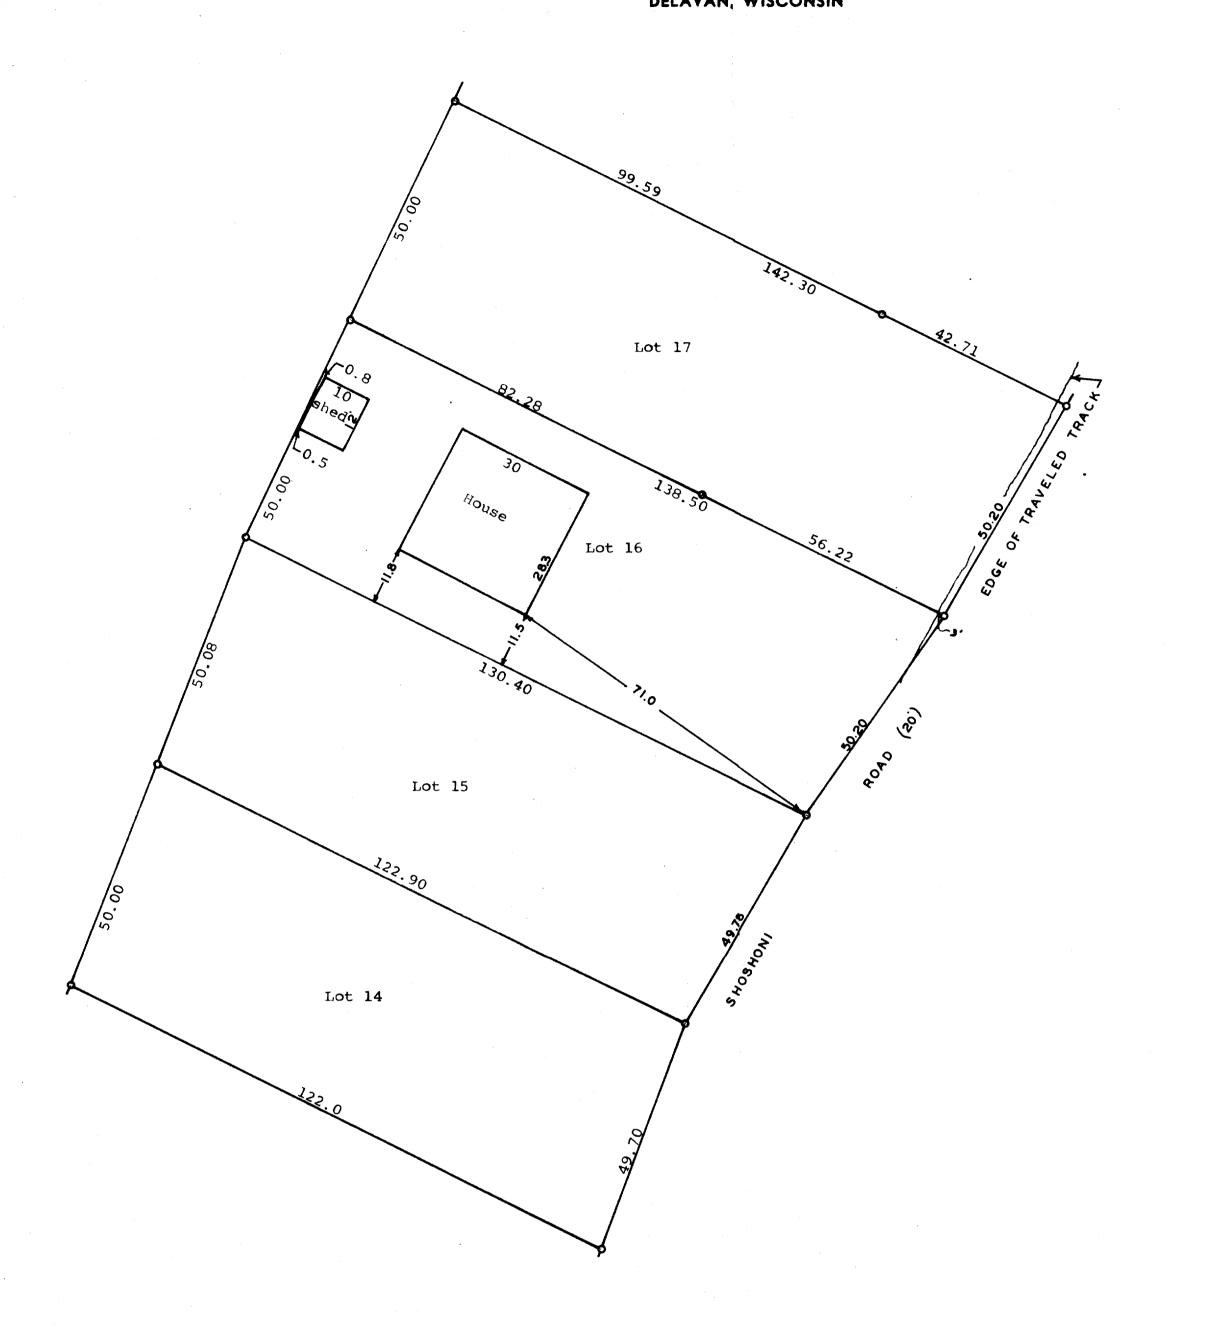

Scale - 1" = 20'o = Iron Pipe


STATE OF WISCONSIN S COUNTY OF WALWORTH

I, George T. Dunham, Surveyor, certify that I have surveyed

the property described as follows,

Lots 14, 15, 16, & 17 in Block 4 of Indian Hills 1st Addition located in the Village of Fontana, Walworth County, Wisconsin, and that the plat shown above is an accurate survey and a true representation thereof and correctly shows the boundary lines of the lots and location of the buildings on said property and the correct measurements thereof. June 1, 1972

George T. Dunham, Surveyor

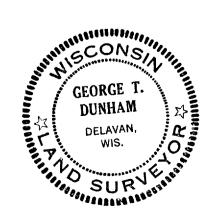

KRE 10-0198 480-10-71