


PLAT OF SURVEY

LOT 4 OF CERTIFIED SURVEY MAP NO. 3421

RECORDED IN VOL. 19 ON PG. 293 AS DOC. NO. 507115
LOCATED IN PART OF THE NE 1/4 OF THE SW 1/4 OF SECTION 15,
TOWN 1 NORTH, RANGE 16 EAST, VILLAGE OF FONTANA-ON-GENEVA LAKE,
WALWORTH COUNTY, WISCONSIN

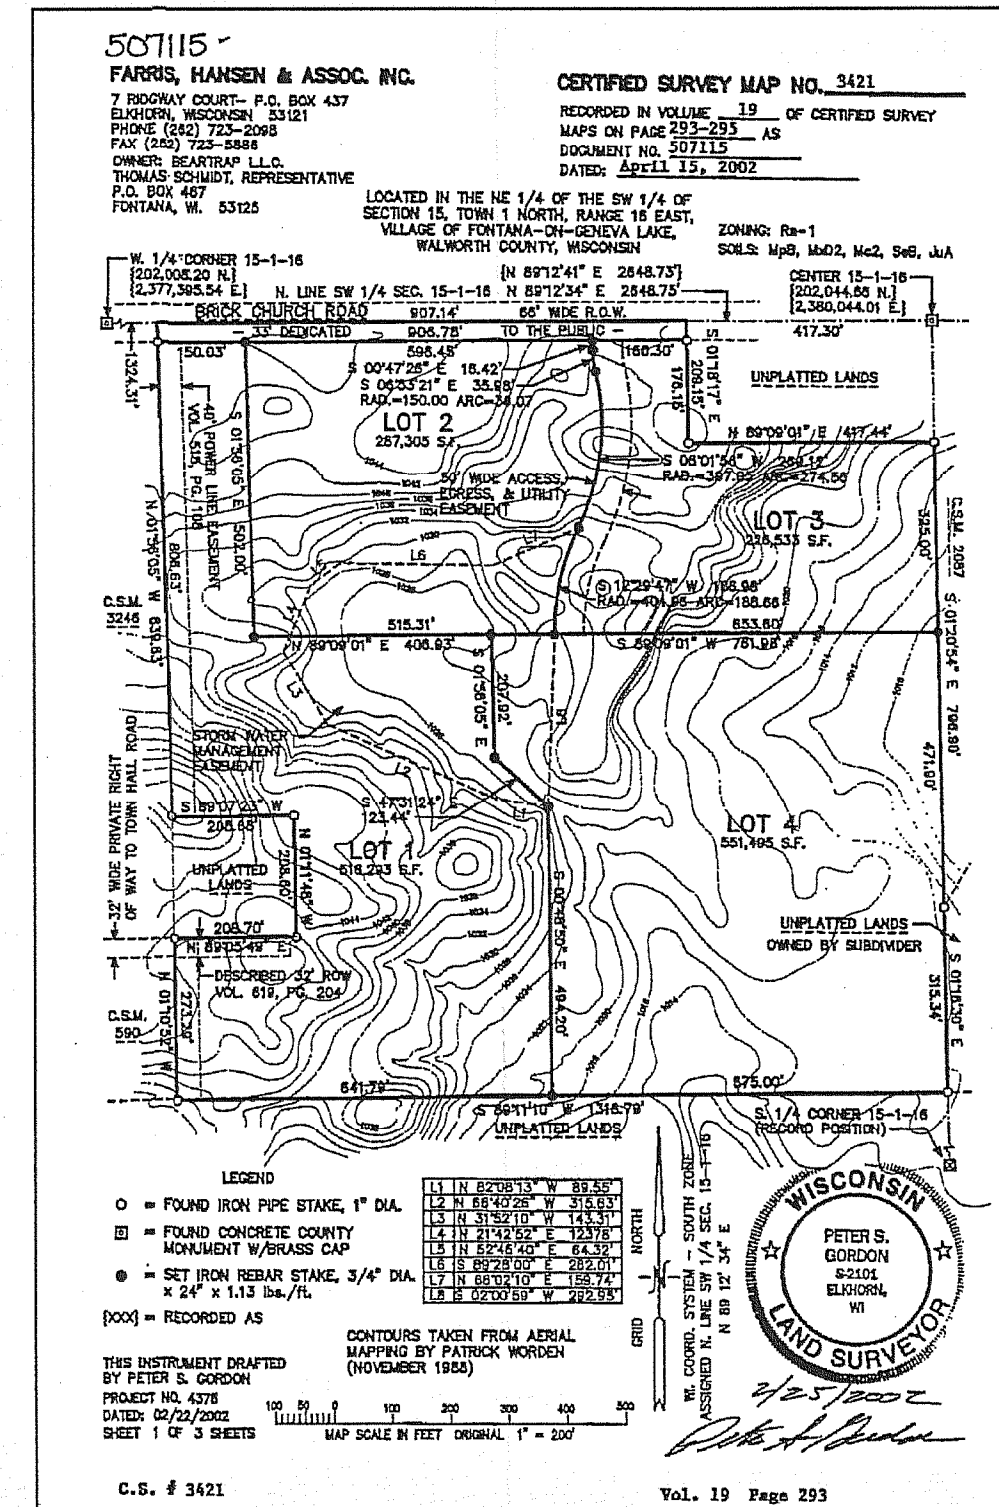


NOTE: THE EASEMENT IN VOL. 619 OF DEEDS, PAGE 204
RE-RECORDED IN VOL. 620 OF DEEDS ON PAGE 553 IS A
ROW WHICH LIES WEST OF LOT 1 OF CSM 3421 AND
DOES NOT AFFECT LOT 4.

LEGAL DESCRIPTION
Lot 4 of Certified Survey Map No. 3421, recorded in the office of the Register of Deeds for Walworth County, Wisconsin on
April 15, 2002, as Document No. 0507115, located in the NE 1/4 of the SW 1/4 of Section 15, Town 1 North, Range 16 East,
Village of Fontana-on-Geneva Lake, Walworth County, Wisconsin.

Together with a fifty foot (50') wide perpetual easement over, across and through Lot 3 of Certified Survey
Map No. 3421 ("CSM 3421"), recorded in the office of the Register of Deeds for Walworth County, Wisconsin
on April 15, 2002, as Document No. 0507115, further described and depicted on said CSM 3421, for the
purpose of providing ingress and egress for vehicular and pedestrian traffic, as well as the installation,
construction and maintenance of utilities, from Lot 4 of CSM 3421, which such easement shall be deemed
appurtenant to Lot 4 of CSM 3421, and shall run with the land.

Tax Key No. SA342100004

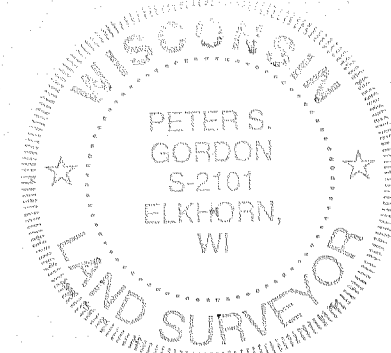



NOTE: COPIES OF THIS MAP TO WHICH THE FOLLOWING CERTIFICATE WILL APPLY SHOW SURVEYOR'S ORIGINAL SEAL
AND SIGNATURE IN RED INK. COPIES BY ANY OTHER MEANS MAY HAVE ALTERATIONS WHICH DO NOT REPRESENT THE
SURVEYOR'S WORK PRODUCT.

I HEREBY CERTIFY THAT THE ABOVE DESCRIBED PROPERTY HAS BEEN SURVEYED UNDER MY DIRECTION AND THAT THE
ABOVE MAP IS A TRUE REPRESENTATION THEREOF AND SHOWS THE SIZE AND LOCATION OF THE PROPERTY, ITS
EXTERIOR BOUNDARIES, THE LOCATION OF ALL VISIBLE STRUCTURES, AND DIMENSIONS OF ALL PRINCIPLE
BUILDINGS THEREON, BOUNDARY FENCES, APPARENT EASEMENTS, ROADWAYS, AND VISIBLE ENCROACHMENTS, IF ANY.
THIS SURVEY IS MADE FOR THE USE OF THE PRESENT OWNERS OF THE PROPERTY, AND ALSO THOSE WHO PURCHASE,
MORTGAGE, OR GUARANTEE THE TITLE THERETO WITHIN ONE YEAR FROM THE DATE HEREOF.



DATED: JUNE 12, 2007

PETER S. GORDON R.L.S. 2101


REVISED 11-07-2007
TO SHOW AS BUILT FOUNDATION SIZE & LOCATION
AND UPDATE THE SURVEY TO TITLE SPEC'S.
06-19-2008
AS BUILT PEAK ELEVATION & SEPTIC

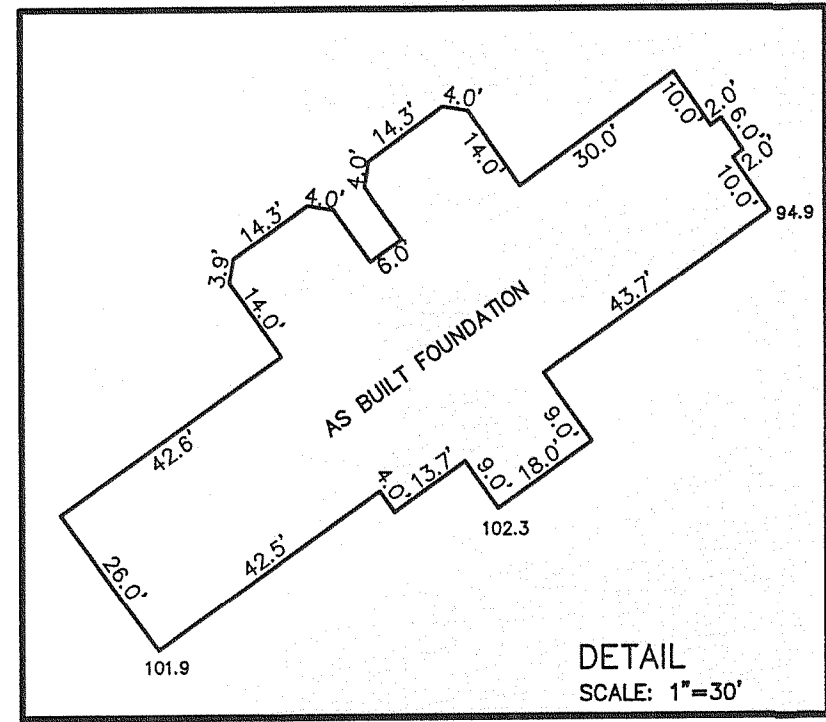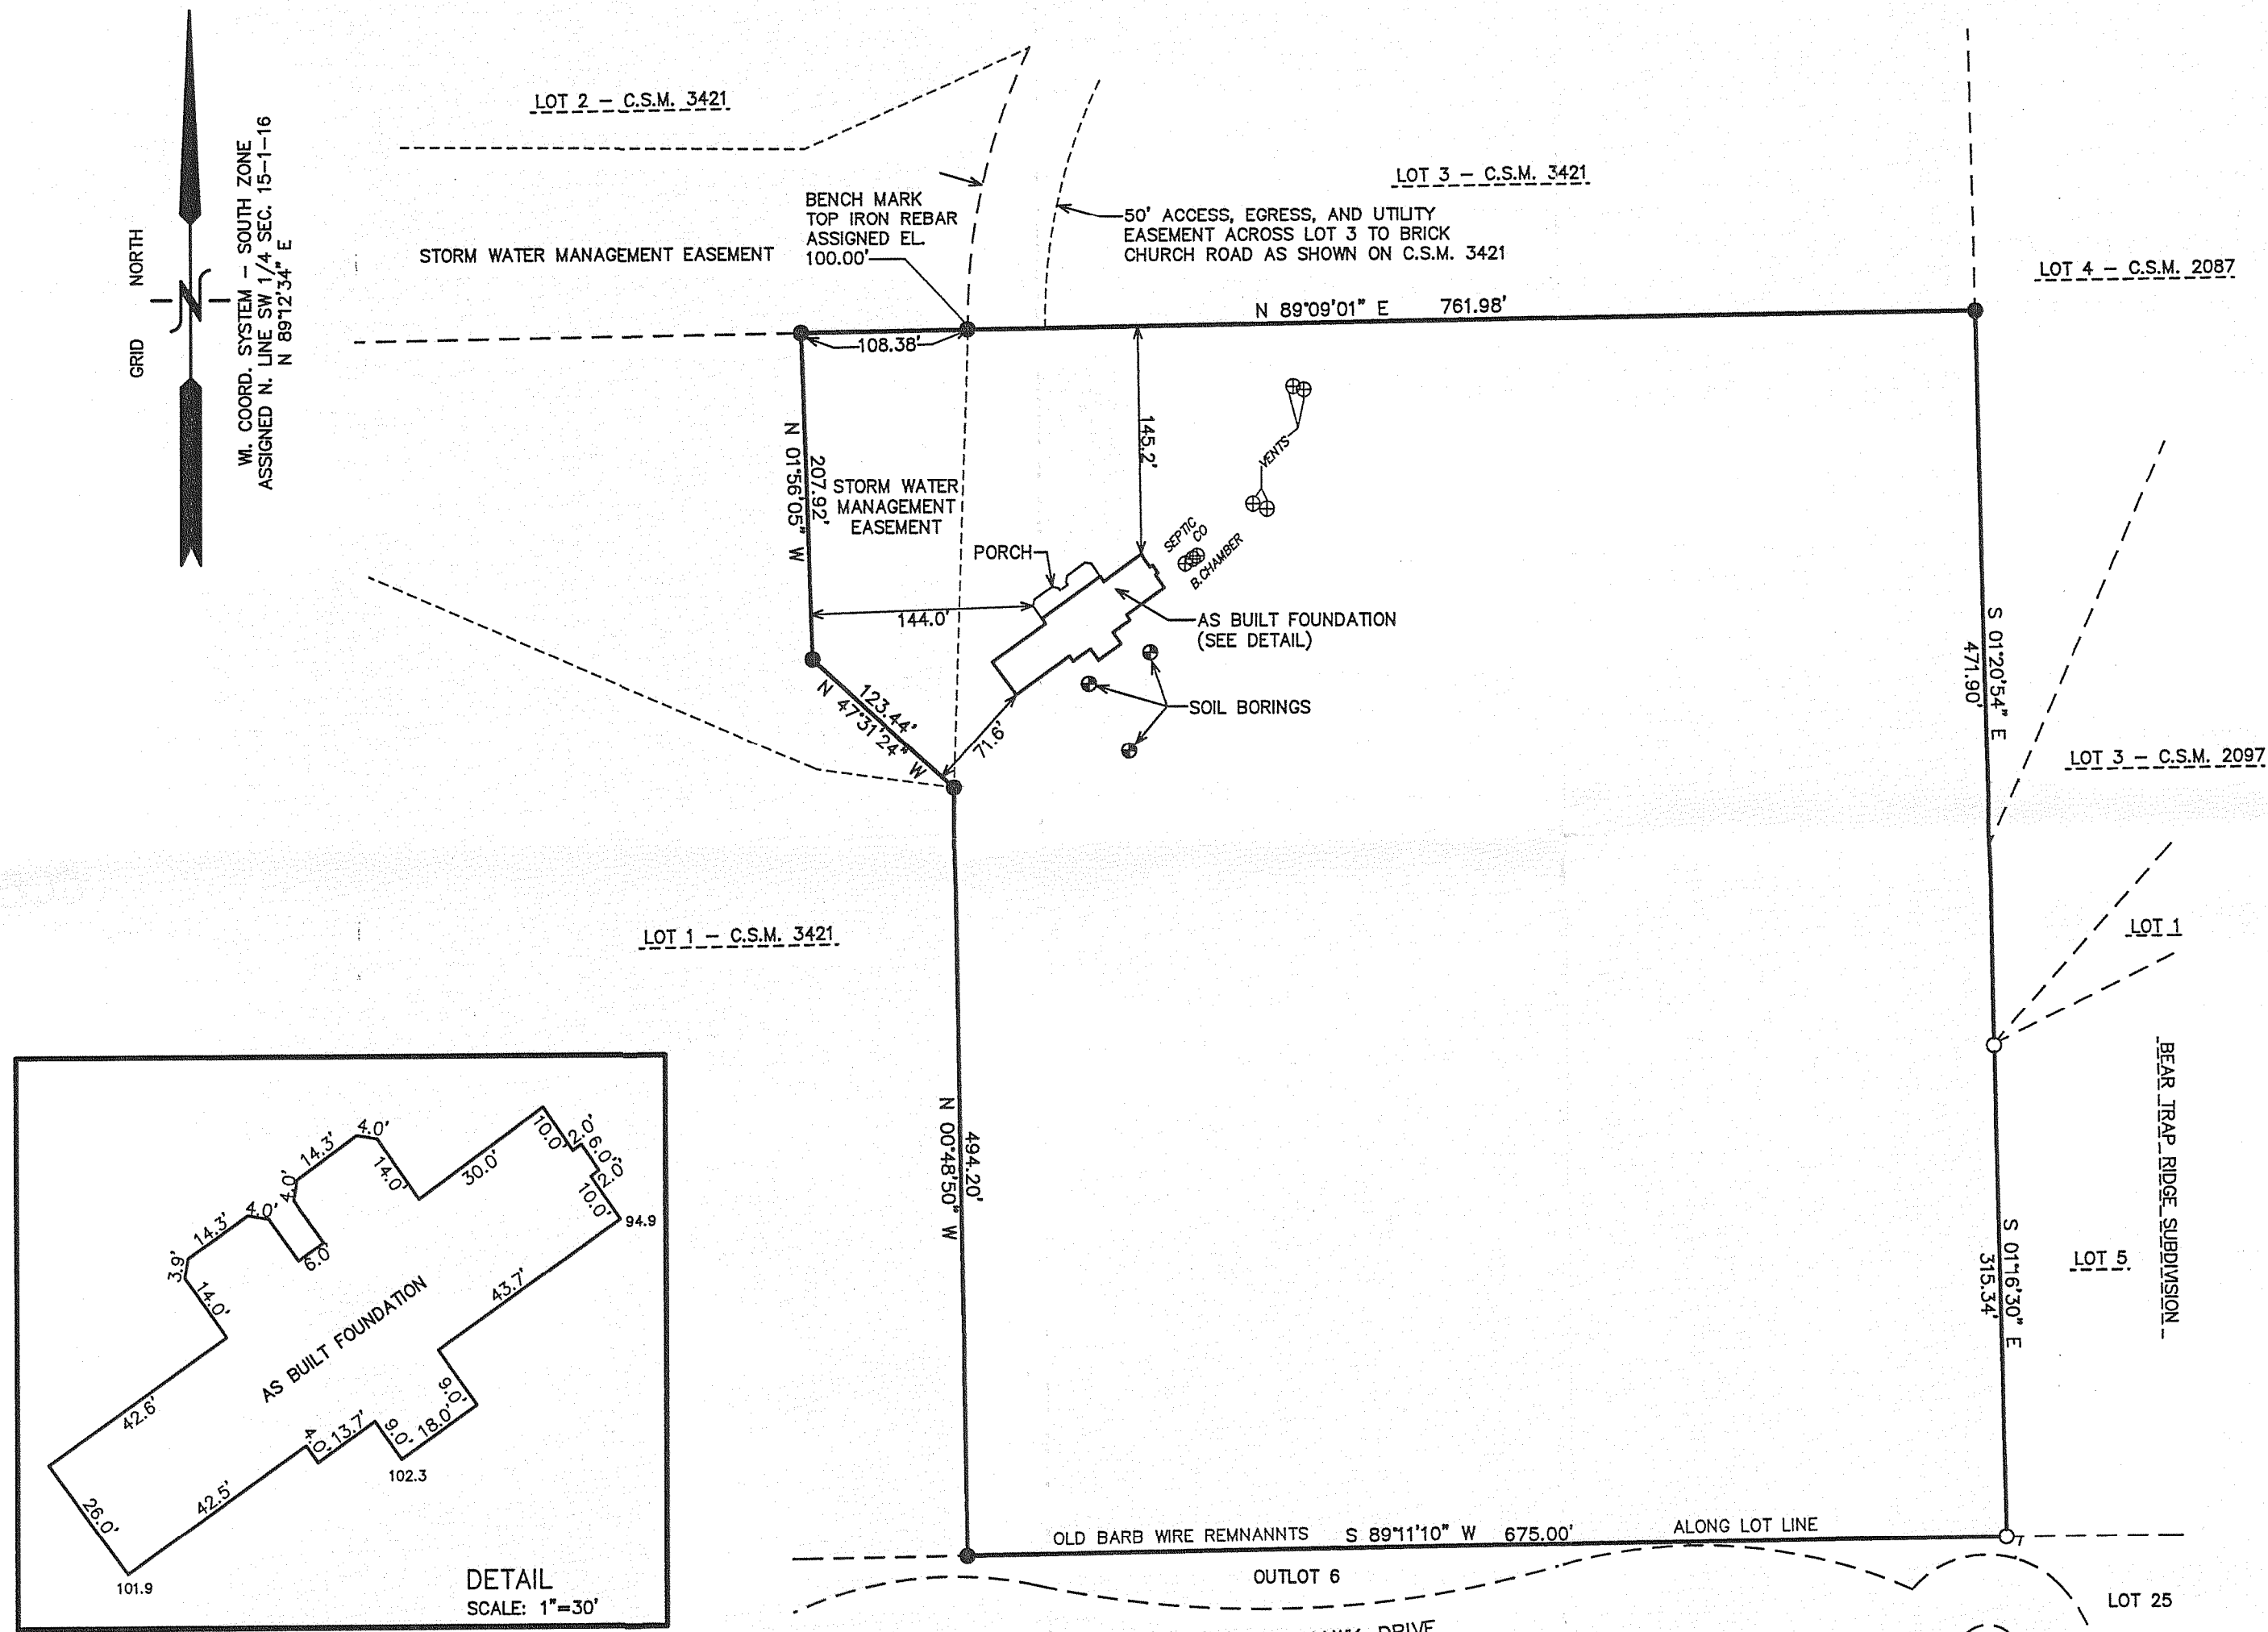

LOW ELEVATION = 94.9'
+ 35 FEET =
MAX BLDG EL. = 129.9'
AS BUILT PEAK ELEVATION = 128.1'
1.8' LOWER THAN ALLOWED MAX EL.

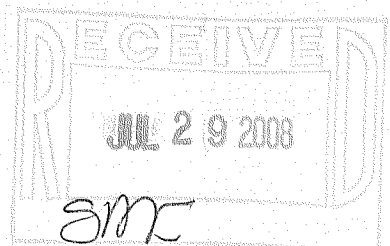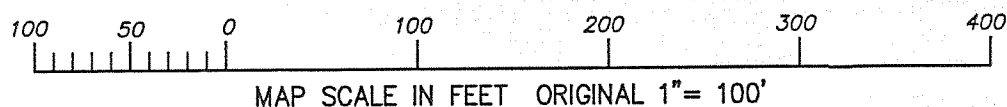

LEGEND
○ = FOUND IRON PIPE STAKE
● = FOUND IRON REBAR STAKE
[XXXX] = RECORDED AS

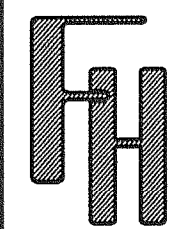

WORK ORDERED BY -
STEVE HIRN
107 FONTAINE COURT
FONTANA, WI 53125

FARRIS, HANSEN & ASSOCIATES, INC.
ENGINEERING - ARCHITECTURE - SURVEYING
7 RIDGWAY COURT P.O. BOX 437
ELKHORN, WISCONSIN 53121
OFFICE: (262) 723-2098 FAX: (262) 723-5886

REVISIONS

PROJECT NO.
4378.04
DATE:
06/12/2007
SHEET NO.
1 OF 1

005-2584