LAND-MARK SURVEYING

Mark L. Miritz

Wisconsin Registered Land Surveyor S-2582

N9330 Knuteson Drive Whitewater, WI 53190 Phone:(262)495-3284 FAX: (262) 495-8421 LAND-MARKSURVEYING.COM


PLAT OF SURVEY

LOT 1, BLOCK "H", COUNTRY CLUB ESTATES SUBDIVISION UNIT NO. 3, LOCATED IN SECTIONS 14 AND 23, TOWN 1 NORTH, RANGE 16 EAST, VILLAGE OF FONTANA, WALWORTH COUNTY, WISCONSIN.

ORDERED BY: KEBBEKUS CARPENTRY

DAN KEBBEKUS **428 FOREST DR.** FONTANA, WI 53125



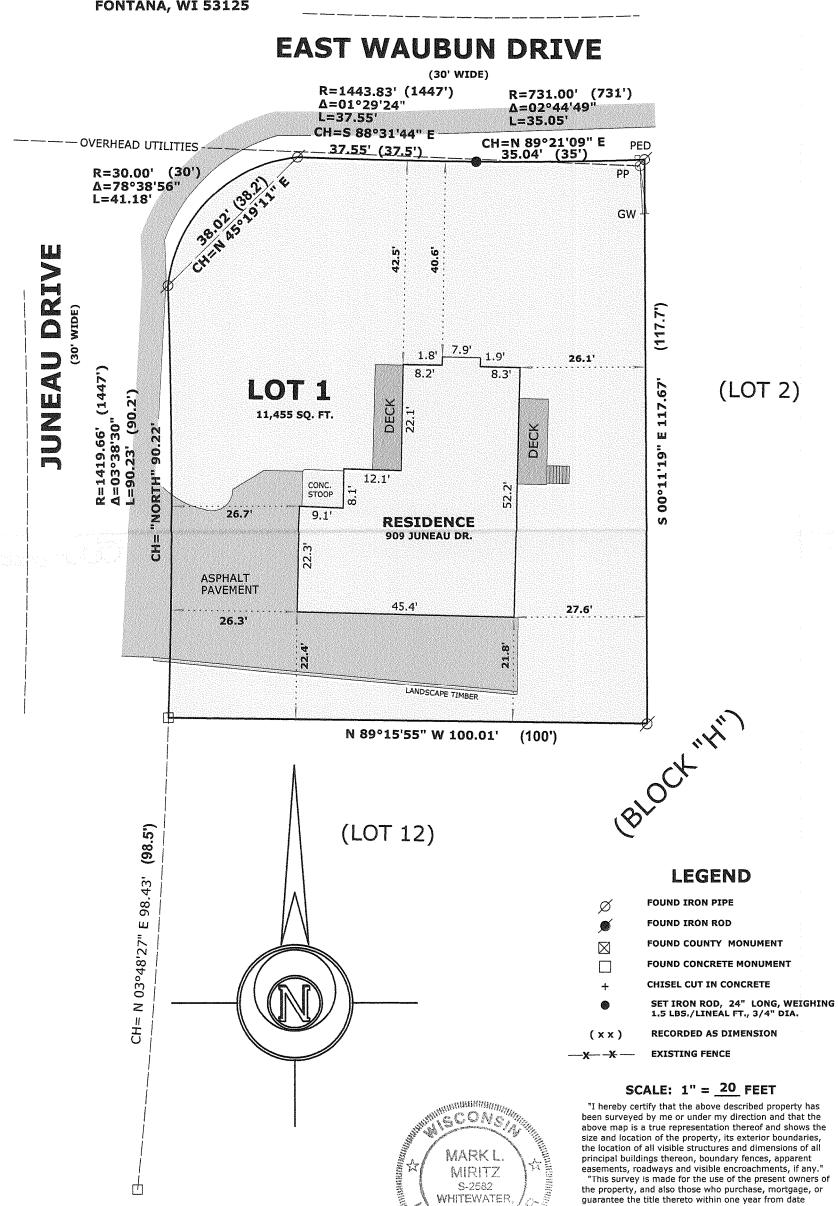

WHITEWATER WI

SUR

JCO3-118

JOB NO. 08.1002

MARK L. MIRITZ

DATE:_OCT. 15, 2008

WISCONSIN REGISTERED **LAND SURVEYOR S-2582**