FARRIS, HANSEN & ASSOCIATES, INC.

ENGINEERING - ARCHITECTURE - SURVEYING 7 RIDGWAY COURT - P.O. BOX 437 - ELKHORN, WISCONSIN PHONE: (262) 723-2098 FAX: (262) 723-5886

PLAT OF SURVEY

LOTS 6 AND 7, BLOCK 2, INDIAN HILLS, A SUBDIVISION LOCATED IN SECTION 14, TOWN 1 NORTH, RANGE 16 EAST, WALWORTH COUNTY, WISCONSIN


- WORK ORDERED BY -MARK & KATHERINE FRANCIS 1649 EAGLE BROOK DRIVE GENEVA, IL. 60134

LOW ELEVATION PRIOR TO CONSTRUCTION = 913.1' ADD 35' MAX HEIGHT FOR MAX PEAK EL. = 948.1' AS BUILT PEAK = 943.5'

LOT


3 88 r Z

LOT 5

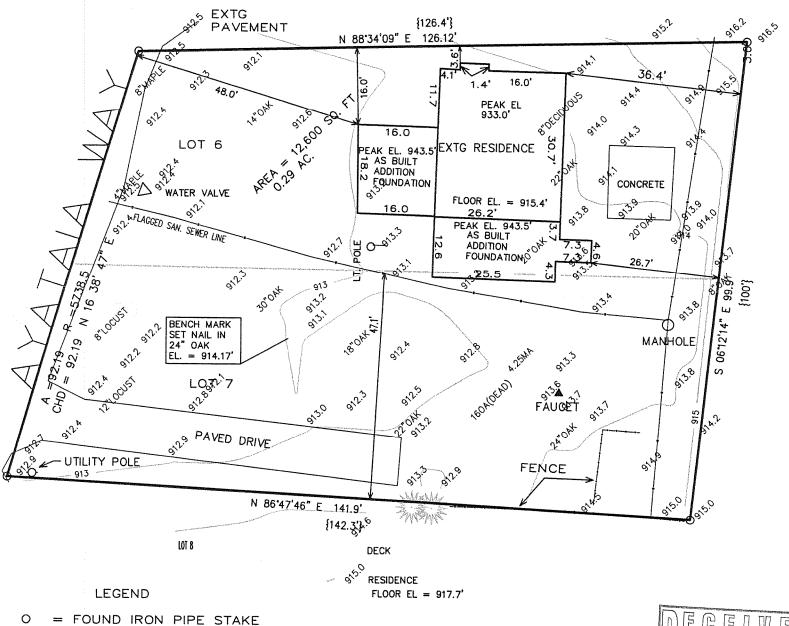

 $\{XXX\}$ = RECORDED AS

10 5 0 100 80 90 ORIGINAL

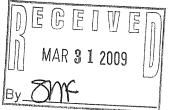

NOTE: COPIES OF THIS MAP TO WHICH THE FOLLOWING CERTIFICATE WILL APPLY SHOW THE SURVEYOR'S ORIGINAL SEAL AND SIGNATURE IN RED INK. COPIES BY ANY OTHER MEANS MAY HAVE ALTERATIONS WHICH DO NOT REPRESENT THE SURVEYOR'S WORK PRODUCT.

I HEREBY CERTIFY THAT THE ABOVE DESCRIBED PROPERTY HAS BEEN SURVEYED UNDER MY DIRECTION AND THAT THE ABOVE MAP IS A TRUE REPRESENTATION THEREOF AND SHOWS THE SIZE AND LOCATION OF THE PROPERTY AND ITS EXTERIOR BOUNDARIES. THIS SURVEY IS MADE FOR THE USE OF THE PRESENT OWNERS OF THE PROPERTY, AND ALSO THOSE WHO PURCHASE, MORTGAGE, OR GUARANTEE THE TITLE THERETO WITHIN ONE YEAR FROM THE DATE HEREOF.

DATED: 06-19-2000

REVISED 07-22-2008 TO SHOW TOPO AND FLAGGED SAN. SEWER REVISED 11-26-2008

TO SHOW AS BUILT ADDITIONS

REVISED 02-19-2009 TO SHOW ROOF ELEVATIONS AS BUILT



PROJECT: 5617 DATE: 06/16/00 SHEET 1 OF 1

PETER S. GORDON R.L.S. 2101