

Plat of Survey


of

Lots 44 and 63 of Buena Vista,



a subdivision located in the Southwest 1/4 of Section 11,
Town 1 North, Range 16 East, Village of Fontana-on-Geneva
Lake, Walworth County, Wisconsin.

Surveyed for: **Keprta Family Trust**

761 Wilson Lane
Hinsdale, Illinois. 60521

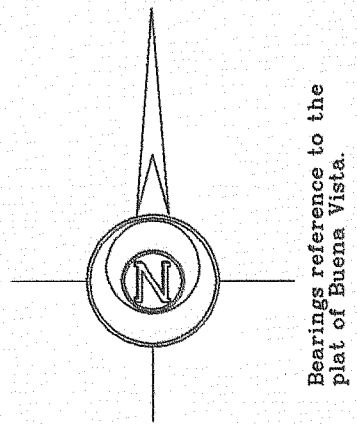

North Lake Shore Drive
(66' Wide)

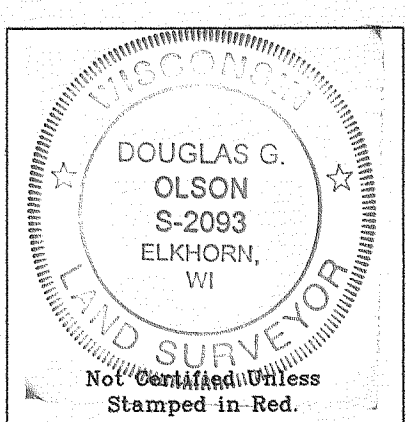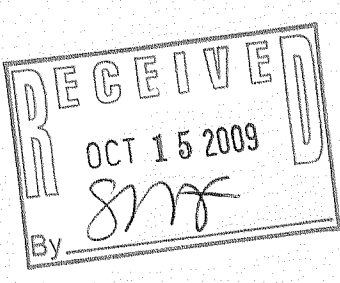

Copyright 2007 by Jensen & Olson Land Surveying, LLC.

All rights reserved. No part of this survey plat may be reproduced or transmitted in any form by any means - graphic, electronic, or mechanical, including photocopying, tracing, or information storage and retrieval systems - without permission in writing from Douglas G. Olson, Jensen & Olson Land Surveying, LLC.

I hereby certify that I have surveyed the above described property and the map hereon is correct to the best of my professional knowledge and belief and shows the size and location of the property, its exterior boundaries, the location and dimensions of all visible structures thereon, boundary fences, apparent easements and roadways and visible encroachments, if any.
This survey is made for the exclusive use of the present owners of property, and also those who purchase, mortgage or guarantee title thereto, within one year from the date hereof.

Douglas G. Olson
Wisconsin Registered Land Surveyor - 2093

- Notes: 1) This survey plat is not certified unless signed and sealed in red ink.
2) This survey is subject to Wisconsin lien laws. This Plat of Survey is the notice of intent to file lien. Lien waiver required.

2009.052	<p>Sheet 1 of 1 Sheets</p> <p>Job Reference Number</p> <p>2009.052</p>	<p>Legend</p> <ul style="list-style-type: none">Found Iron PipeFound Chiseled CrossRecorded InformationUtility PoleMetal CoverAsphalt SurfaceConcrete SurfaceWater Valve	<p>Jensen & Olson Land Surveying, LLC</p> <p>45 South Wisconsin Street P.O. Box 322 Elkhorn, Wisconsin. 53121 Telephone (262) 723-3434 Facsimile (262) 723-8044</p>	<p>Scale in Feet</p> <p>1" = 20'</p> <p>0' 10' 20' 40'</p>	<p>Survey Date: July 27, 2007.</p> <p>Revisions: No. 1 - Patio</p>
----------	--	---	--	--	--

SBV 32 SBV-43

005-2671