


PLAT OF SURVEY  
 LOTS 6-9, BLOCK 15 OF GLENWOOD SPRINGS  
 LOCATED IN PART OF THE VILLAGE OF FONTANA-ON-GENEVA LAKE,  
 WALWORTH COUNTY, WISCONSIN

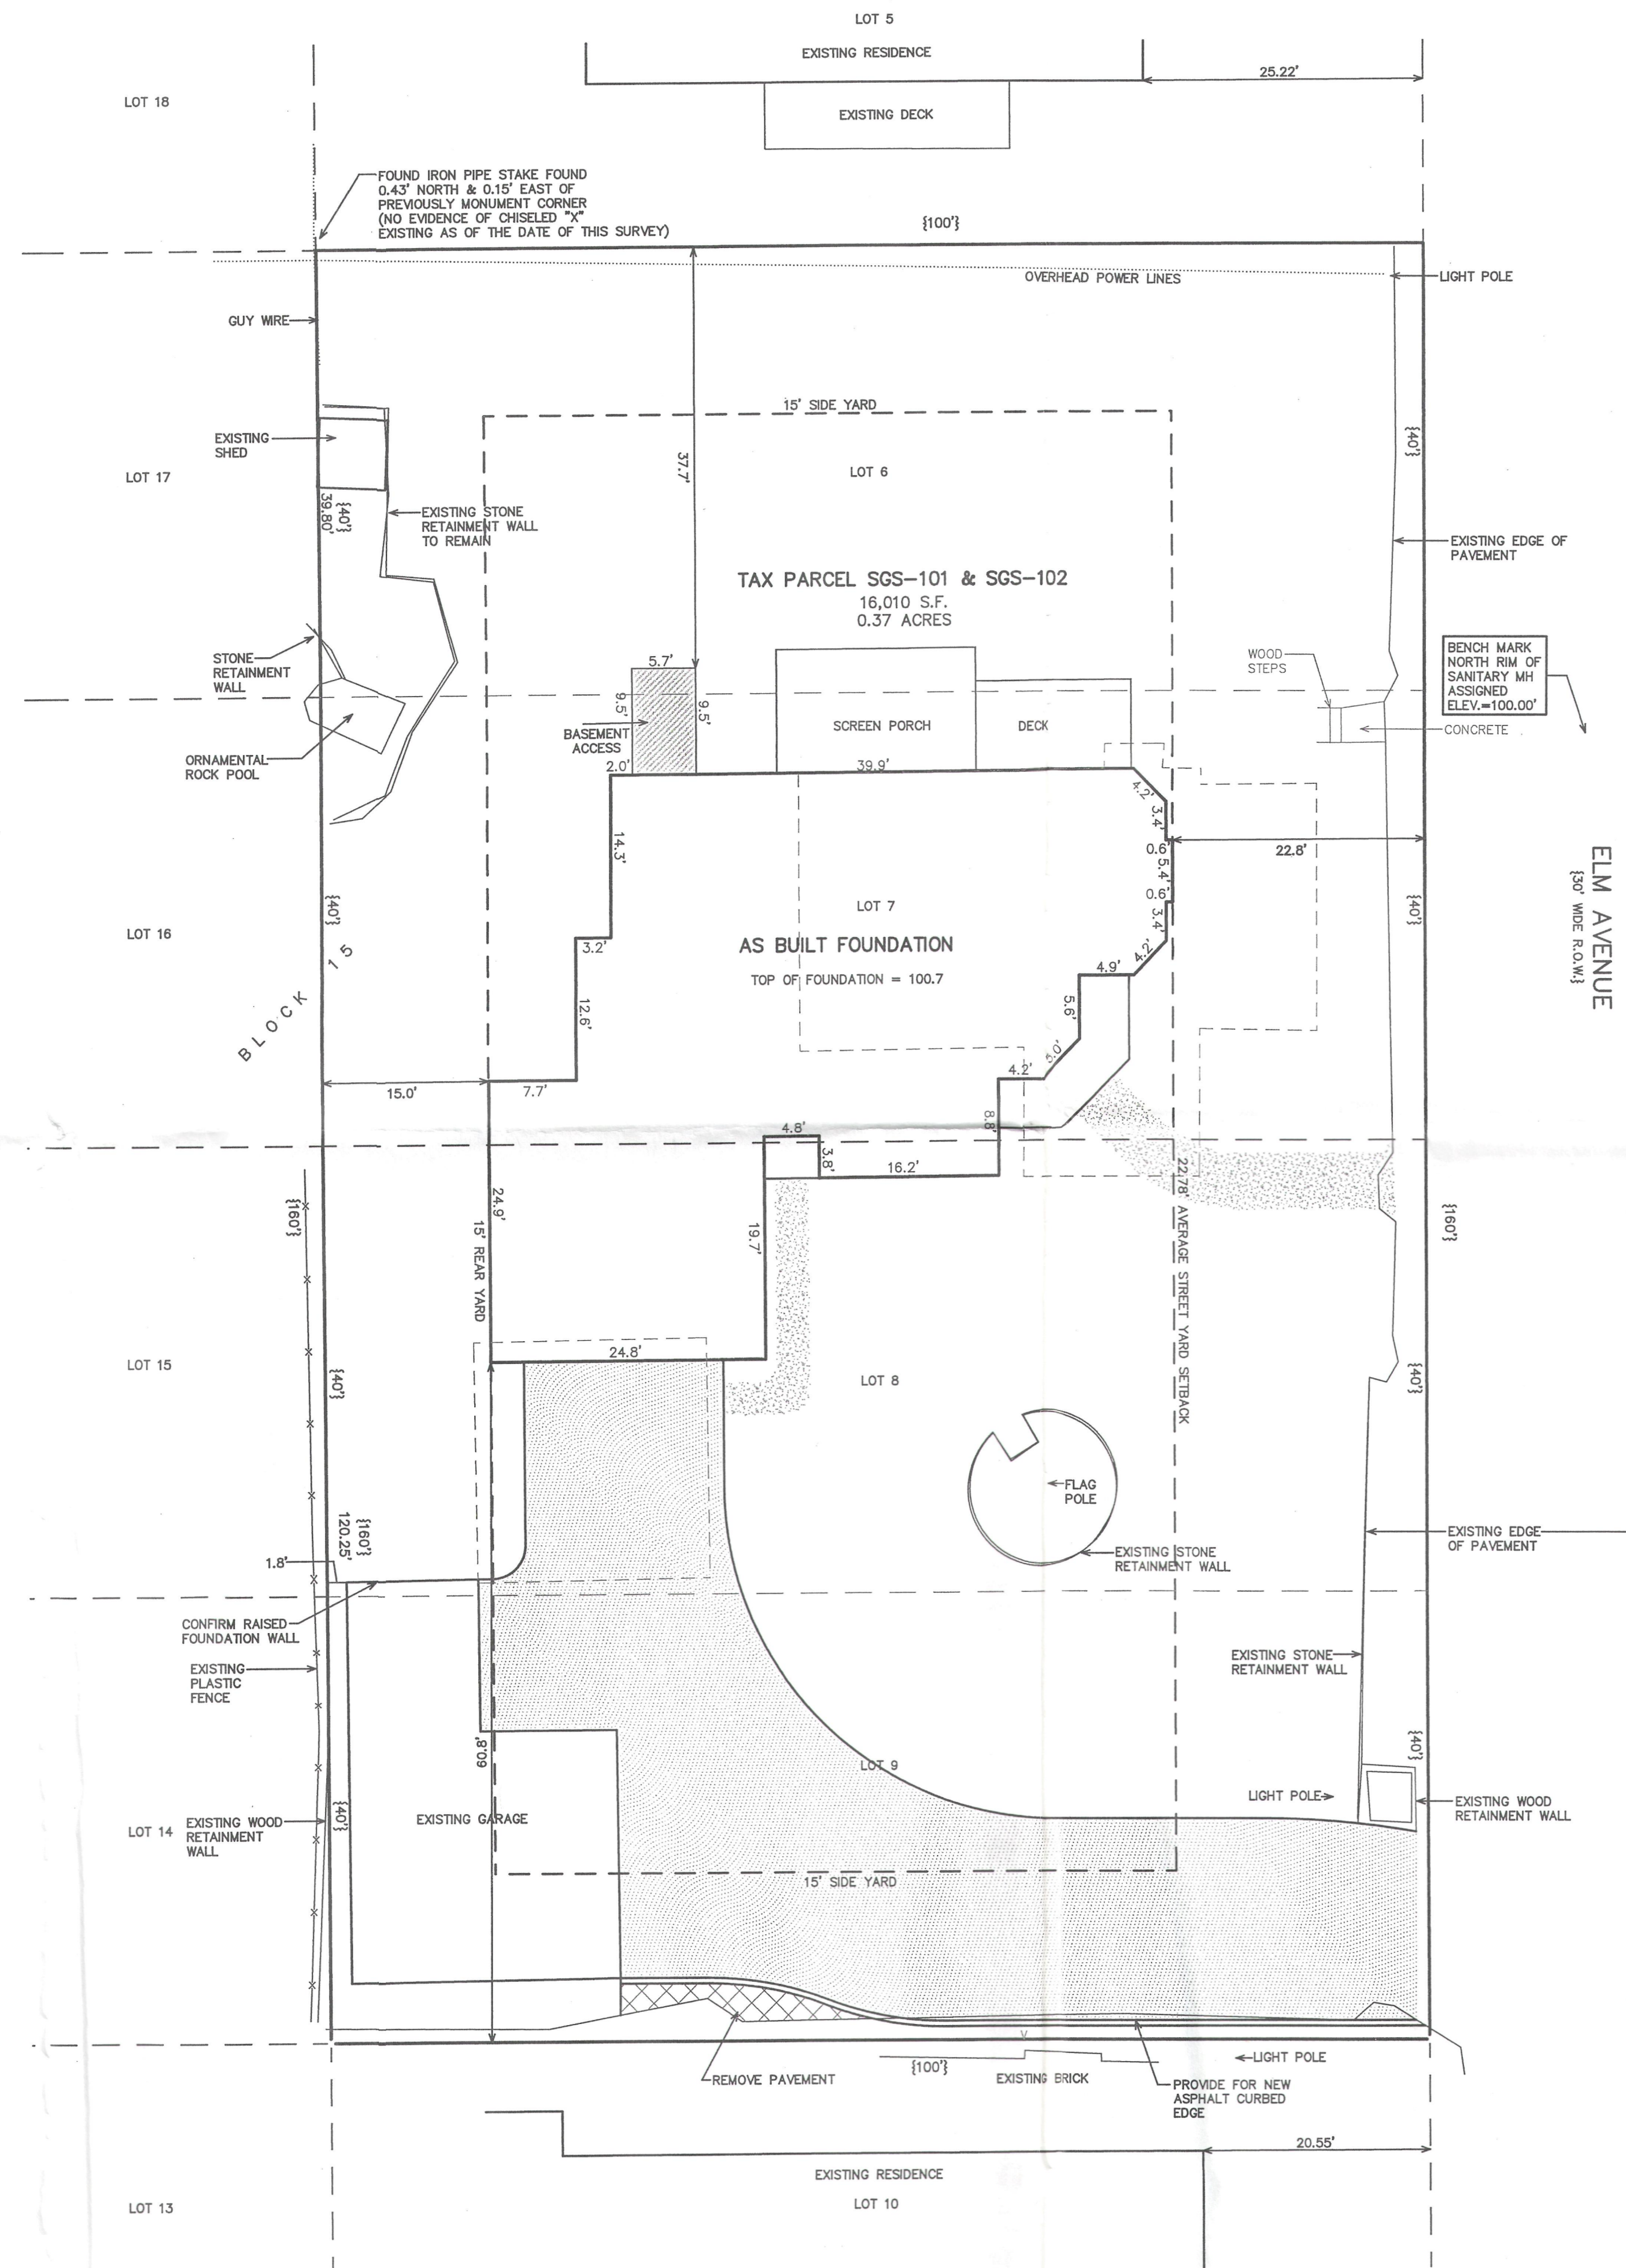



LEGEND  
 ○ = FOUND IRON PIPE STAKE  
 ● = FOUND IRON REBAR STAKE  
 x = FOUND NAIL IN ROCK  
 {xxx} = RECORDED AS

STREET YARD AVERAGE SUMMARY:  
 25.22' (25') TO NORTH + 20.55' TO SOUTH = 45.55' / 2 = 22.78' MIN. STREET YARD SETBACK

BUILDING HEIGHT SUMMARY:  
 LOWEST EXISTING GRADE AT PROPOSED BUILDING FOOTPRINT = 99.15'  
 99.15' + 35' = 134.15' MAXIMUM BUILDING HEIGHT  
 PROPOSED BUILDING ROOF HEIGHT = 131.4' TO RIDGE  
 AS BUILT PEAK ELEVATION = 129.5'

SITE SOILS  
 MpB & MpC - McHENRY SILT LOAM

IMPERVIOUS SURFACE AFTER CONSTRUCTION = 6223 S.F. (39%)  
 GREEN SPACE = 61%

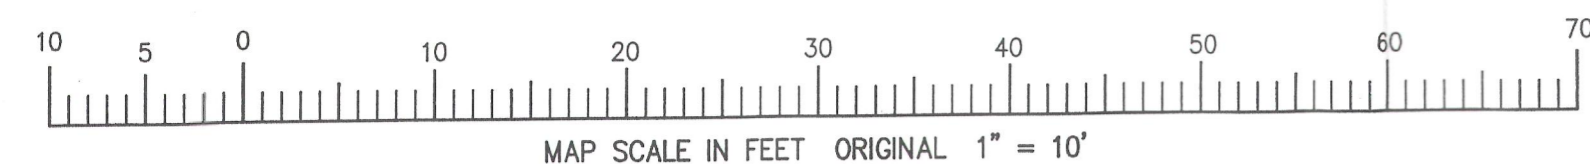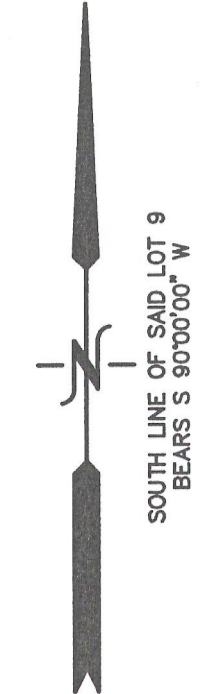


NOTE: COPIES OF THIS MAP TO WHICH THE FOLLOWING CERTIFICATE WILL APPLY SHOW THE SURVEYOR'S ORIGINAL SEAL AND SIGNATURE IN RED INK. COPIES BY ANY OTHER MEANS MAY HAVE ALTERATIONS WHICH DO NOT REPRESENT THE SURVEYOR'S WORK PRODUCT.

I HEREBY CERTIFY THAT THE ABOVE DESCRIBED PROPERTY HAS BEEN SURVEYED UNDER MY DIRECTION AND THAT THE ABOVE MAP IS A TRUE REPRESENTATION THEREOF AND SHOWS THE SIZE AND LOCATION OF THE PROPERTY AND ITS EXTERIOR BOUNDARIES. THIS SURVEY IS MADE FOR THE USE OF THE PRESENT OWNERS OF THE PROPERTY, AND ALSO THOSE WHO PURCHASE, MORTGAGE, OR GUARANTEE THE TITLE THERETO WITHIN ONE YEAR FROM THE DATE HEREOF.

DATED, AUGUST 26, 2009  
 REVISED 10-30-2009 TO SHOW AS BUILT FOUNDATION  
 REVISED 12-10-2009 TO SHOW PEAK AS BUILT EL.

PETER S. GORDON R.L.S. 2101

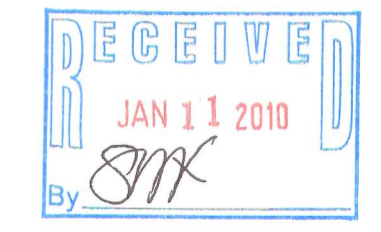

WORK ORDERED BY -  
 TODD CAUFMANN  
 LOWELL MANAGEMENT SERVICES, INC.  
 PO BOX 926  
 LAKE GENEVA, WI 53147

FARRIS, HANSEN & ASSOCIATES, INC.  
 ENGINEERING - ARCHITECTURE - SURVEYING  
 7 RIDGWAY COURT P.O. BOX 437  
 ELKHORN, WISCONSIN 53121  
 OFFICE: (262) 723-2098 FAX: (262) 723-5886

REVISIONS  
 09-18-2009 MSC REV.'S  
 09-25-2009 ADD GREEN SPACE COMP.

PROJECT NO. 7977  
 DATE 09/04/2009  
 SHEET NO. 1 OF 1

SGS-101 SGS-102

005-2710

DEC 1 0 2008

12/10/2008 X:\Projects\7977\Draw\ASBUILT