## PLAT OF SURVEY


PHONE: 262-537-4874 FAX: 262-537-4221

PARCEL A: Lot 47 of BUENA VISTA PARK SUBDIVISION, located in the Southwest Quarter of Section 11, Township 1 North, Range 16 East of the 4th Principal Meridian, Village of Fontana—On—Geneva Lake, Walworth County, Wisconsin.

PARCEL IDENTIFICATION NO: SBV 00034

PARCEL B: Lot 60 of BUENA VISTA PARK SUBDIVISION, located in the Southwest Quarter of Section 11, Township 1 North, Range 16 East of the 4th Principal Meridian, Village of Fontana-On-Geneva Lake, Walworth County, Wisconsin.


PARCEL IDENTIFICATION NO: SBV 00041

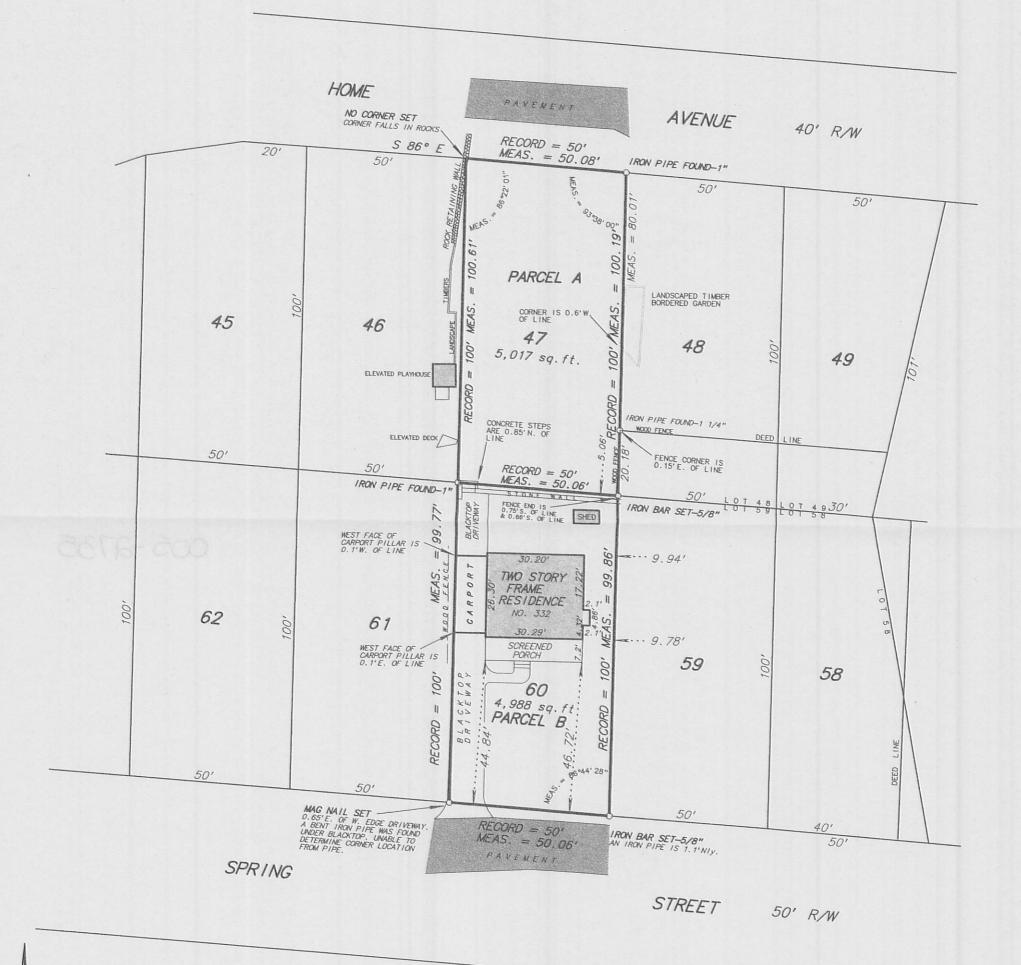

NOTE:

THIS SURVEY WAS AN ATTEMPT TO RETRACE TWO SURVEYS BY HAROLD H. KOLB. ONE SURVEY WAS DATED DEC. 19, 1974 AND WAS OF THE SUBJECT PROPERTY. THE OTHER SURVEY WAS OF LOTS 61 AND 62, DATED DECEMBER 30, 1994. A SURVEY OF LOTS 45 AND 46, DATED MAY 18, 1984, BY THOMAS JENSEN WAS ALSO USED AS REFERENCE FOR PROPERTY LINE LOCATION.

SCALE: 1 inch = 30 feetORDERED BY: J. Bateman / James P. Bateman, LTD. JOB NO. 07228

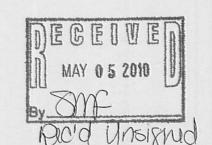

Fieldwork completed on and date of certification: October 17, 2007

I hereby certify that I have surveyed the above described property and the above plat is a true representation thereof and shows the size and location of the property, its exterior boundaries, the location and dimensions of all visible structures thereon, boundary fences, apparent easements and roadways and visible encroachments, if any.

This survey is made for the exclusive use of the present owners of the property, and also those who purchase, mortgage or guarantee the title thereto within ONE YEAR from the date hereof.

Dated at Bassett, Wisconsin this \_\_\_\_\_ day of \_\_\_

Mark A. Bolender Wisconsin Registered Land Surveyor S - 1784

005 -2735