
## PLAT OF SURVEY


PHONE: 262-537-4874 FAX: 262-537-4221

Lot 8 of ADDITION "B" TO COUNTRY CLUB ESTATES located in the Northwest Quarter of Section 23, Township 1 North, Range 16 East of the 4th Principal Meridian, Village of Fontana—on—Geneva Lake, Walworth County, Wisconsin.

Parcel Identification Number: SCTB 00009



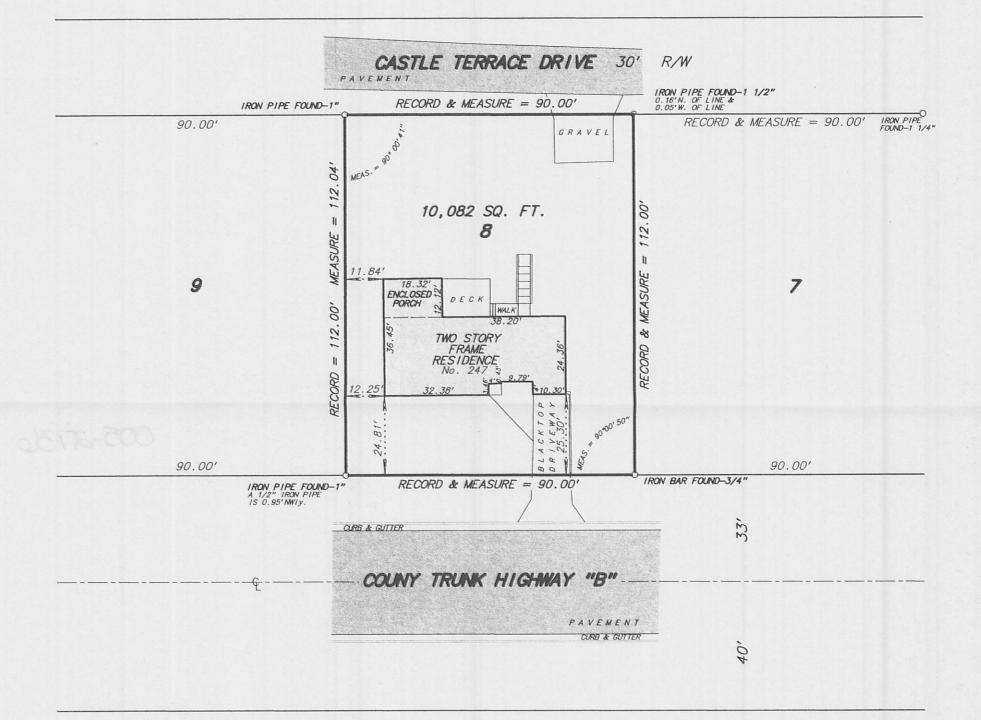

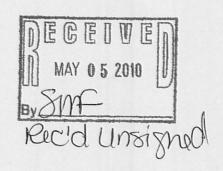

SCALE:	1 inch = 30 feet	
ORDERED	BY: M. Petersen / Midwest Property Consultants	7
JOB NO.	07138	

	June	18.	2007	
Fieldwork completed on and date of certification:	Cuire	, ,	2001	

I hereby certify that I have surveyed the above described property and the above plat is a true representation thereof and shows the size and location of the property, its exterior boundaries, the location and dimensions of all visible structures thereon, boundary fences, apparent easements and roadways and visible encroachments, if any.

This survey is made for the exclusive use of the present owners of the property, and also those who purchase, mortgage or guarantee the title thereto within  $\emph{ONE}$  YEAR from the date hereof.

005-2736

Dated at Bassett,	Wisconsin	this	day of	2007.
The state of the s			Contract of the Contract of th	

Mark A. Bolender Wisconsin Registered Land Surveyor S - 1784