



Plat of Survey

of


Unit No. 156 of Abbey Springs Condominium No. 5,

located in the Southwest 1/4 of Section 18, Town 1 North, Range 17
East, Village of Fontana-on-Geneva Lake, Walworth County, Wisconsin.

Surveyed for: **John Casali**
3900 Bordeaux Drive
Hoffman Estates, Illinois. 60192

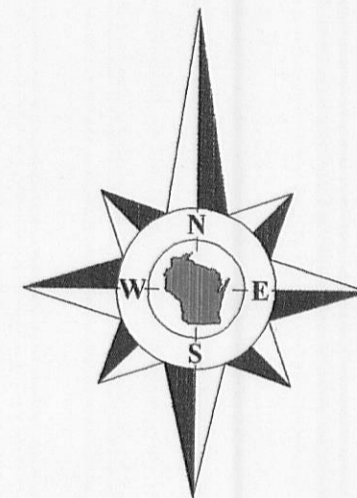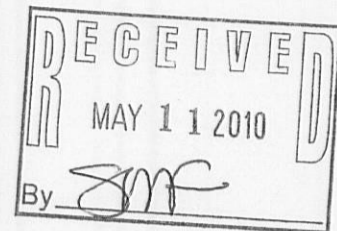

Bearings reference to the plat of Abbey
Springs Condominium No. 5.

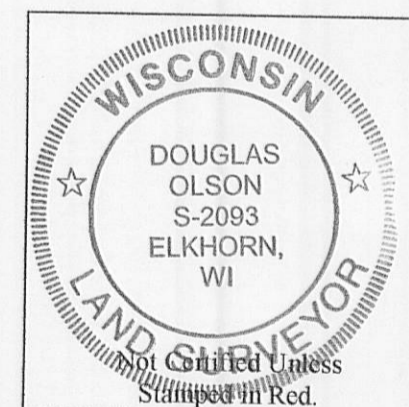

Notes:

- 1) This survey plat is not certified unless signed and sealed in red ink.
- 2) This survey is subject to Wisconsin lien laws. This Plat of Survey is the notice of intent to file lien. Lien waiver required.

Copyright 2010 by Jensen & Olson Land Surveying, LLC.

All rights reserved. No part of this survey plat may be reproduced or transmitted in any form by any means - graphic, electronic, or mechanical, including photocopying, tracing, or information storage and retrieval systems - without permission in writing from Douglas G. Olson, Jensen & Olson Land Surveying, LLC.

I hereby certify that I have surveyed the above described property and the map hereon is correct to the best of my professional knowledge and belief and shows the size and location of the property, its exterior boundaries, the location and dimensions of all visible structures thereon, boundary fences, apparent easements and roadways and visible encroachments, if any.

This survey is made for the exclusive use of the present owners of the property, and also those who purchase, mortgage or guarantee title thereto, within one year from the date hereof.

Douglas G. Olson
Wisconsin Registered Land Surveyor - 2093

SCDB 5-156

005-2739

Sheet 1 of 1 Sheets

Drawing Name: t1nr16e-2010015-2010015Platrev1.sd

Job Reference Number

2010.015

Legend

- Found Iron Pipe
- Found Iron Rod
- Recorded Information
- Manhole
- Utility Pedestal
- Asphalt Surface
- Concrete Surface
- Brick Pavers
- Stone Pavers



Jensen & Olson Land Surveying, LLC


45 South Wisconsin Street * P.O. Box 322 * Elkhorn, Wisconsin. 53121

Telephone: (262) 723-3434 * Facsimile: (262) 723-8044

Email: jensen.olson@elknet.net

Scale in Feet

1" = 20'

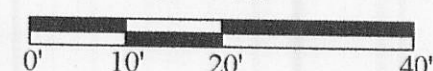

Survey Date: March 19, 2010.

Revisions: No. 1 - Proposed Screen Porch

2010.015