
PREPARED FOR: RODNEY WHETLOW KEEFE REAL ESTATE 751 GENEVA PKWY. LAKE GENEVA, WI 53147

PLAT OF SURVEY

PATHFINDER SURVEYING, INC. W2888 KRUEGER ROAD UNIT "D" LAKE GENEVA, WI 53147 (262) 248-8303

- OF -

LOT 13 AND THE EAST 1/4 OF LOT 14, OF DAVID O. MARSH'S SUBDIVISION OF OUTLOT OR BLOCK NUMBER 7 IN THE CITY OF LAKE GENEVA, WALWORTH COUNTY, WISCONSIN, EXCEPTING THE NORTH 60 FEET THEREOF

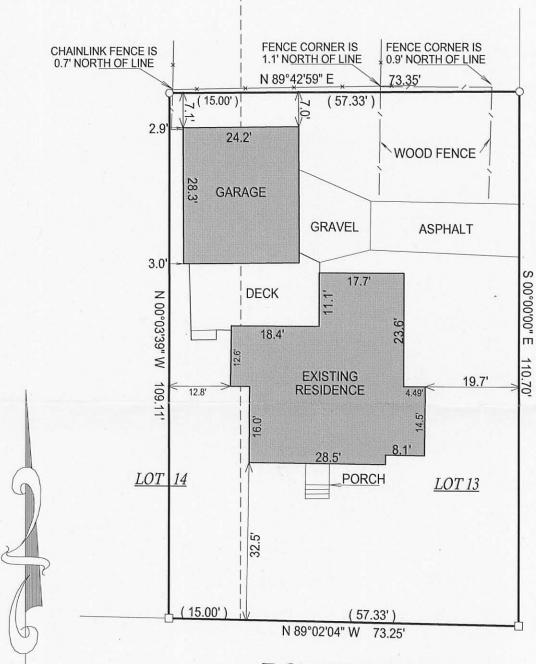

1AXWELL SIKEE!

DODGE STREET



SUNSCONO