PREPARED FOR: NANCY SCHLEICHER 211 PEARSON DRIVE LAKE GENEVA, WI 53147

PLAT OF SURVEY

- OF -

LOT 34 OF PEARSON SUBDIVISION, LOCATED IN TOWN 2 NORTH, RANGE 17 EAST, CITY OF LAKE GENEVA, WALWORTH COUNTY, WISCONSIN

PATHFINDER SURVEYING, INC. W2888 KRUEGER ROAD UNIT "D" LAKE GENEVA, WI 53147 (262) 248-8303



() = RECORDED AS

 \Box = FOUND IRON BAR

○ = FOUND IRON PIPE


■ = SET IRON BAR

= SET IRON PIPE

SCALE: 1" = 20'

JOB #: 09-074

TAX ID #: ZP 00034

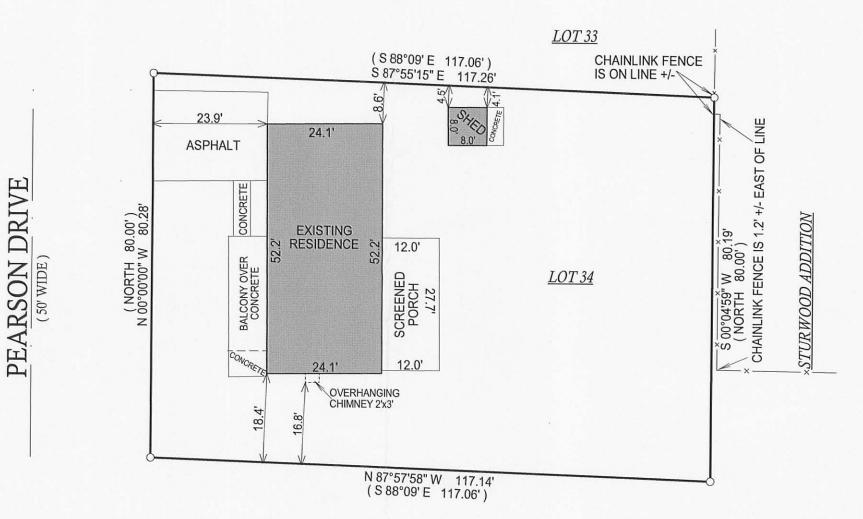


NOTE: BASIS OF BEARING IS THE RECORD PLAT OF PEARSONS SUBDIVISION, PEARSON DRIVE IS ASSUMED TO BEAR NORTH

COMPARE LEGAL DESCRIPTION ABOVE AND DRAWING WITH DEED. FOR BUILDING RESTRICTIONS AND EASEMENTS NOT SHOWN, REFER TO DEED, ABSTRACT SOURCES AND LOCAL MUNICIPAL CODES. NOTIFY THE SURVEYOR IMMEDIATELY OF ANY DISCREPANCY.

"I hereby certify that I have surveyed the above described property and that the above map, to the best of my knowledge and belief, is a true representation thereof and shows the size and location of all visible structures, apparent easements and encoachments if any."

This survey is made for the present owners of the property, and those who purchase, mortgage, or guarantee the title thereto, within one year from the date hereof.

LOT 35

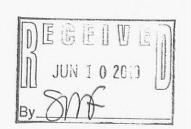



JEFFREY L KIMPS S - 2436 Wisconsin Registered Land Surveyor (original if signed in red)

DATED THIS 11th, DAY OF AUGUST, 2009.

775