

PREPARED FOR  
MICHAEL HOGAN  
PO. BOX 295  
FONTANA WI. 53125

**PLAT OF SURVEY**




-OF-

**KROTT SURVEYING INC.**


N3705 WILLOW BEND LANE  
LAKE GENEVA WI. 53147  
PHONE # (262)248-3697  
FAX # (262)249-0639

LOT 15 ADDITION "D" TO COUNTRY CLUB ESTATES, A SUBDIVISION  
LOCATED IN THE SOUTHWEST 1/4 OF THE SOUTHEAST 1/4 OF SECTION 14,  
TOWN 1 NORTH, RANGE 16 EAST, VILLAGE OF FONTANA - ON - GENEVA LAKE,  
WALWORTH COUNTY, WISCONSIN.

**C.L. BRICKLEY COURT**  
(PLATED AS WOODLAND DRIVE 66' WIDE)

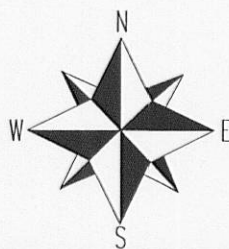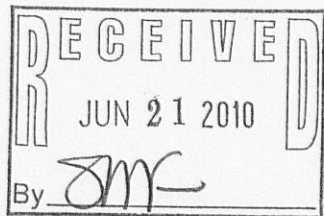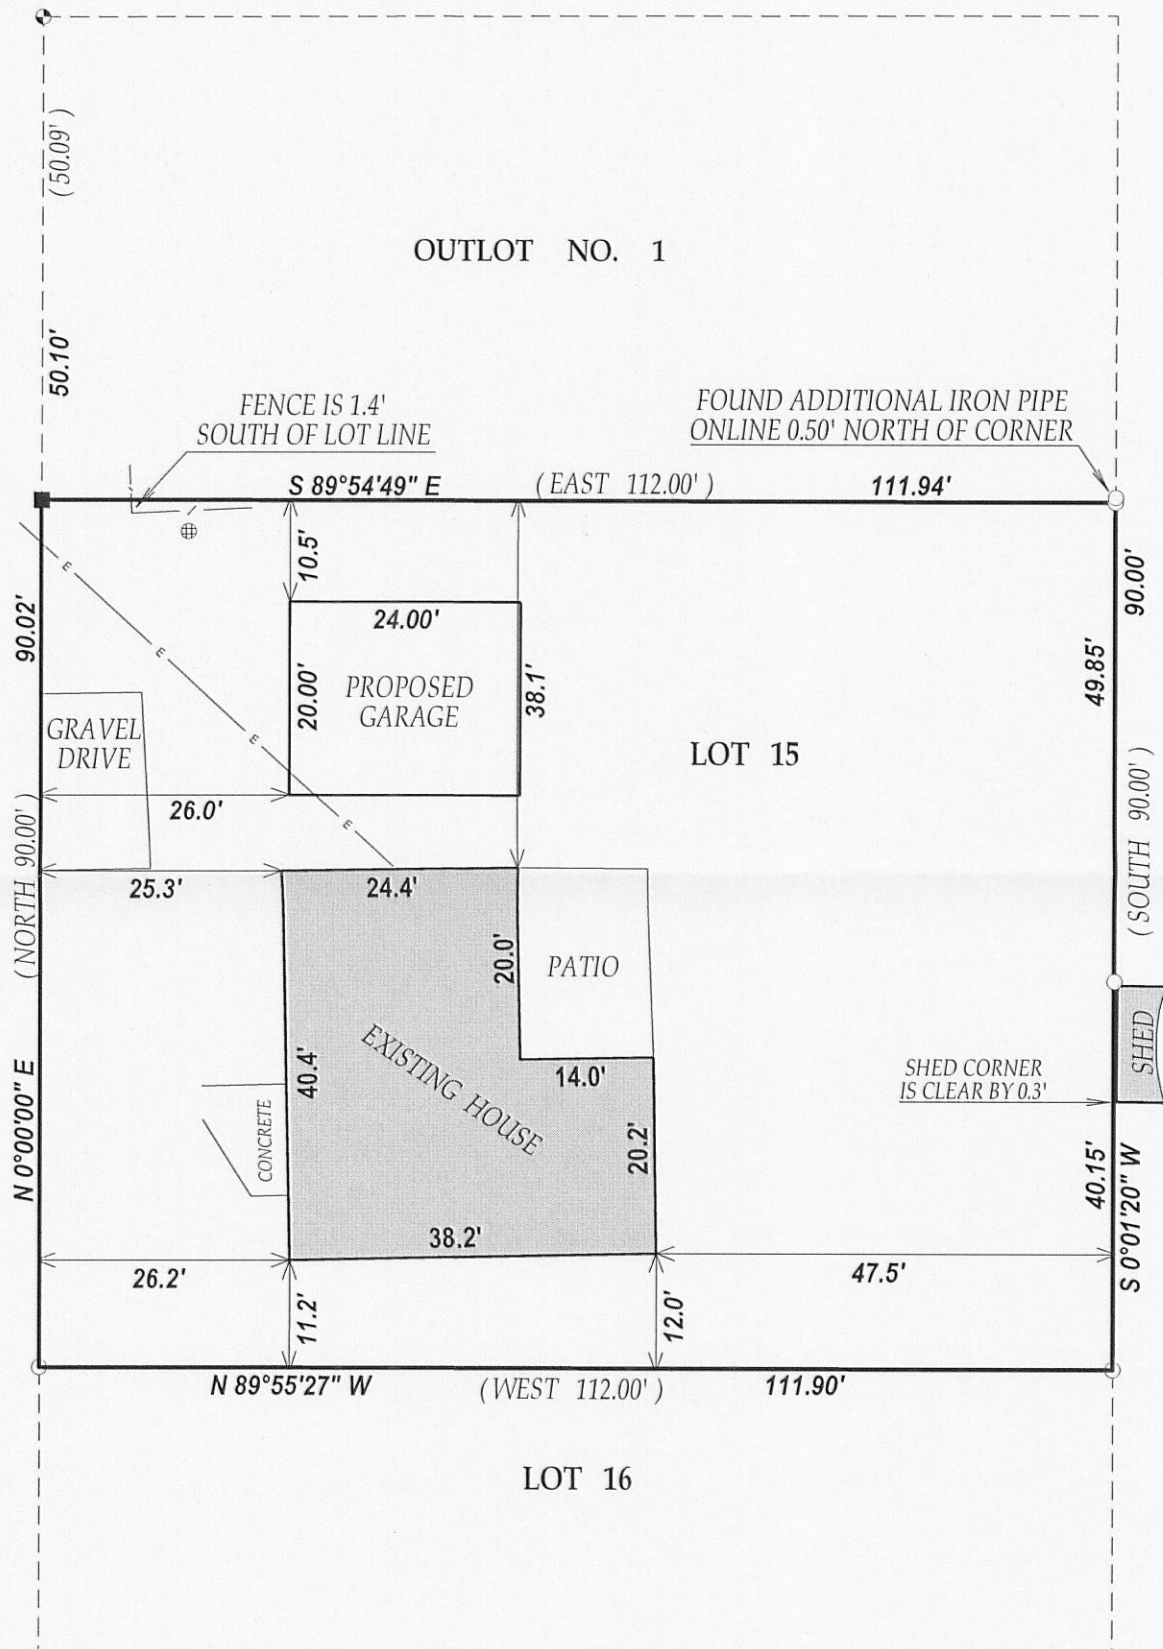

SCALE 1" = 20'

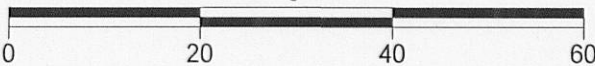

NOTE: BEARINGS ARE REFERENCED TO THE RECORD PLAT OF ADDITION "D" TO COUNTRY CLUB ESTATES

I have surveyed the above-described property and the above map is a true representation thereof and shows the size and location of the property, its exterior boundaries, the location and dimensions of all structures thereon, fences apparent easements and roadways and visible encroachments, if any.

This survey is made for the exclusive use of the present owners of the property, and also those who purchase, mortgage, or insure the title thereto within one (1) year from date hereof; and as to them I warrant the accuracy of said survey map.



DATED THIS 3rd DAY OF MAY 2010.

*John P. Krott*  
JOHN KROTT S - 2258  
Wisconsin Registered Land Surveyor  
(original if signed in red)

- LEGEND**
- FOUND IRON PIPE
  - FOUND CONCRETE MONUMENT
  - SET IRON BAR
  - ⊕ MANHOLE
  - E— OVERHEAD WIRES
  - (xx) RECORDED AS
  - TAX ID # SCTD00016
  - JOB # 10-077

005-2751