


PLAT OF SURVEY

-OF-

KROTT SURVEYING INC.

N3705 WILLOW BEND LANE
LAKE GENEVA WI. 53147
PHONE # (262)248-3697
FAX # (262)249-0639

GENEVA LAKE

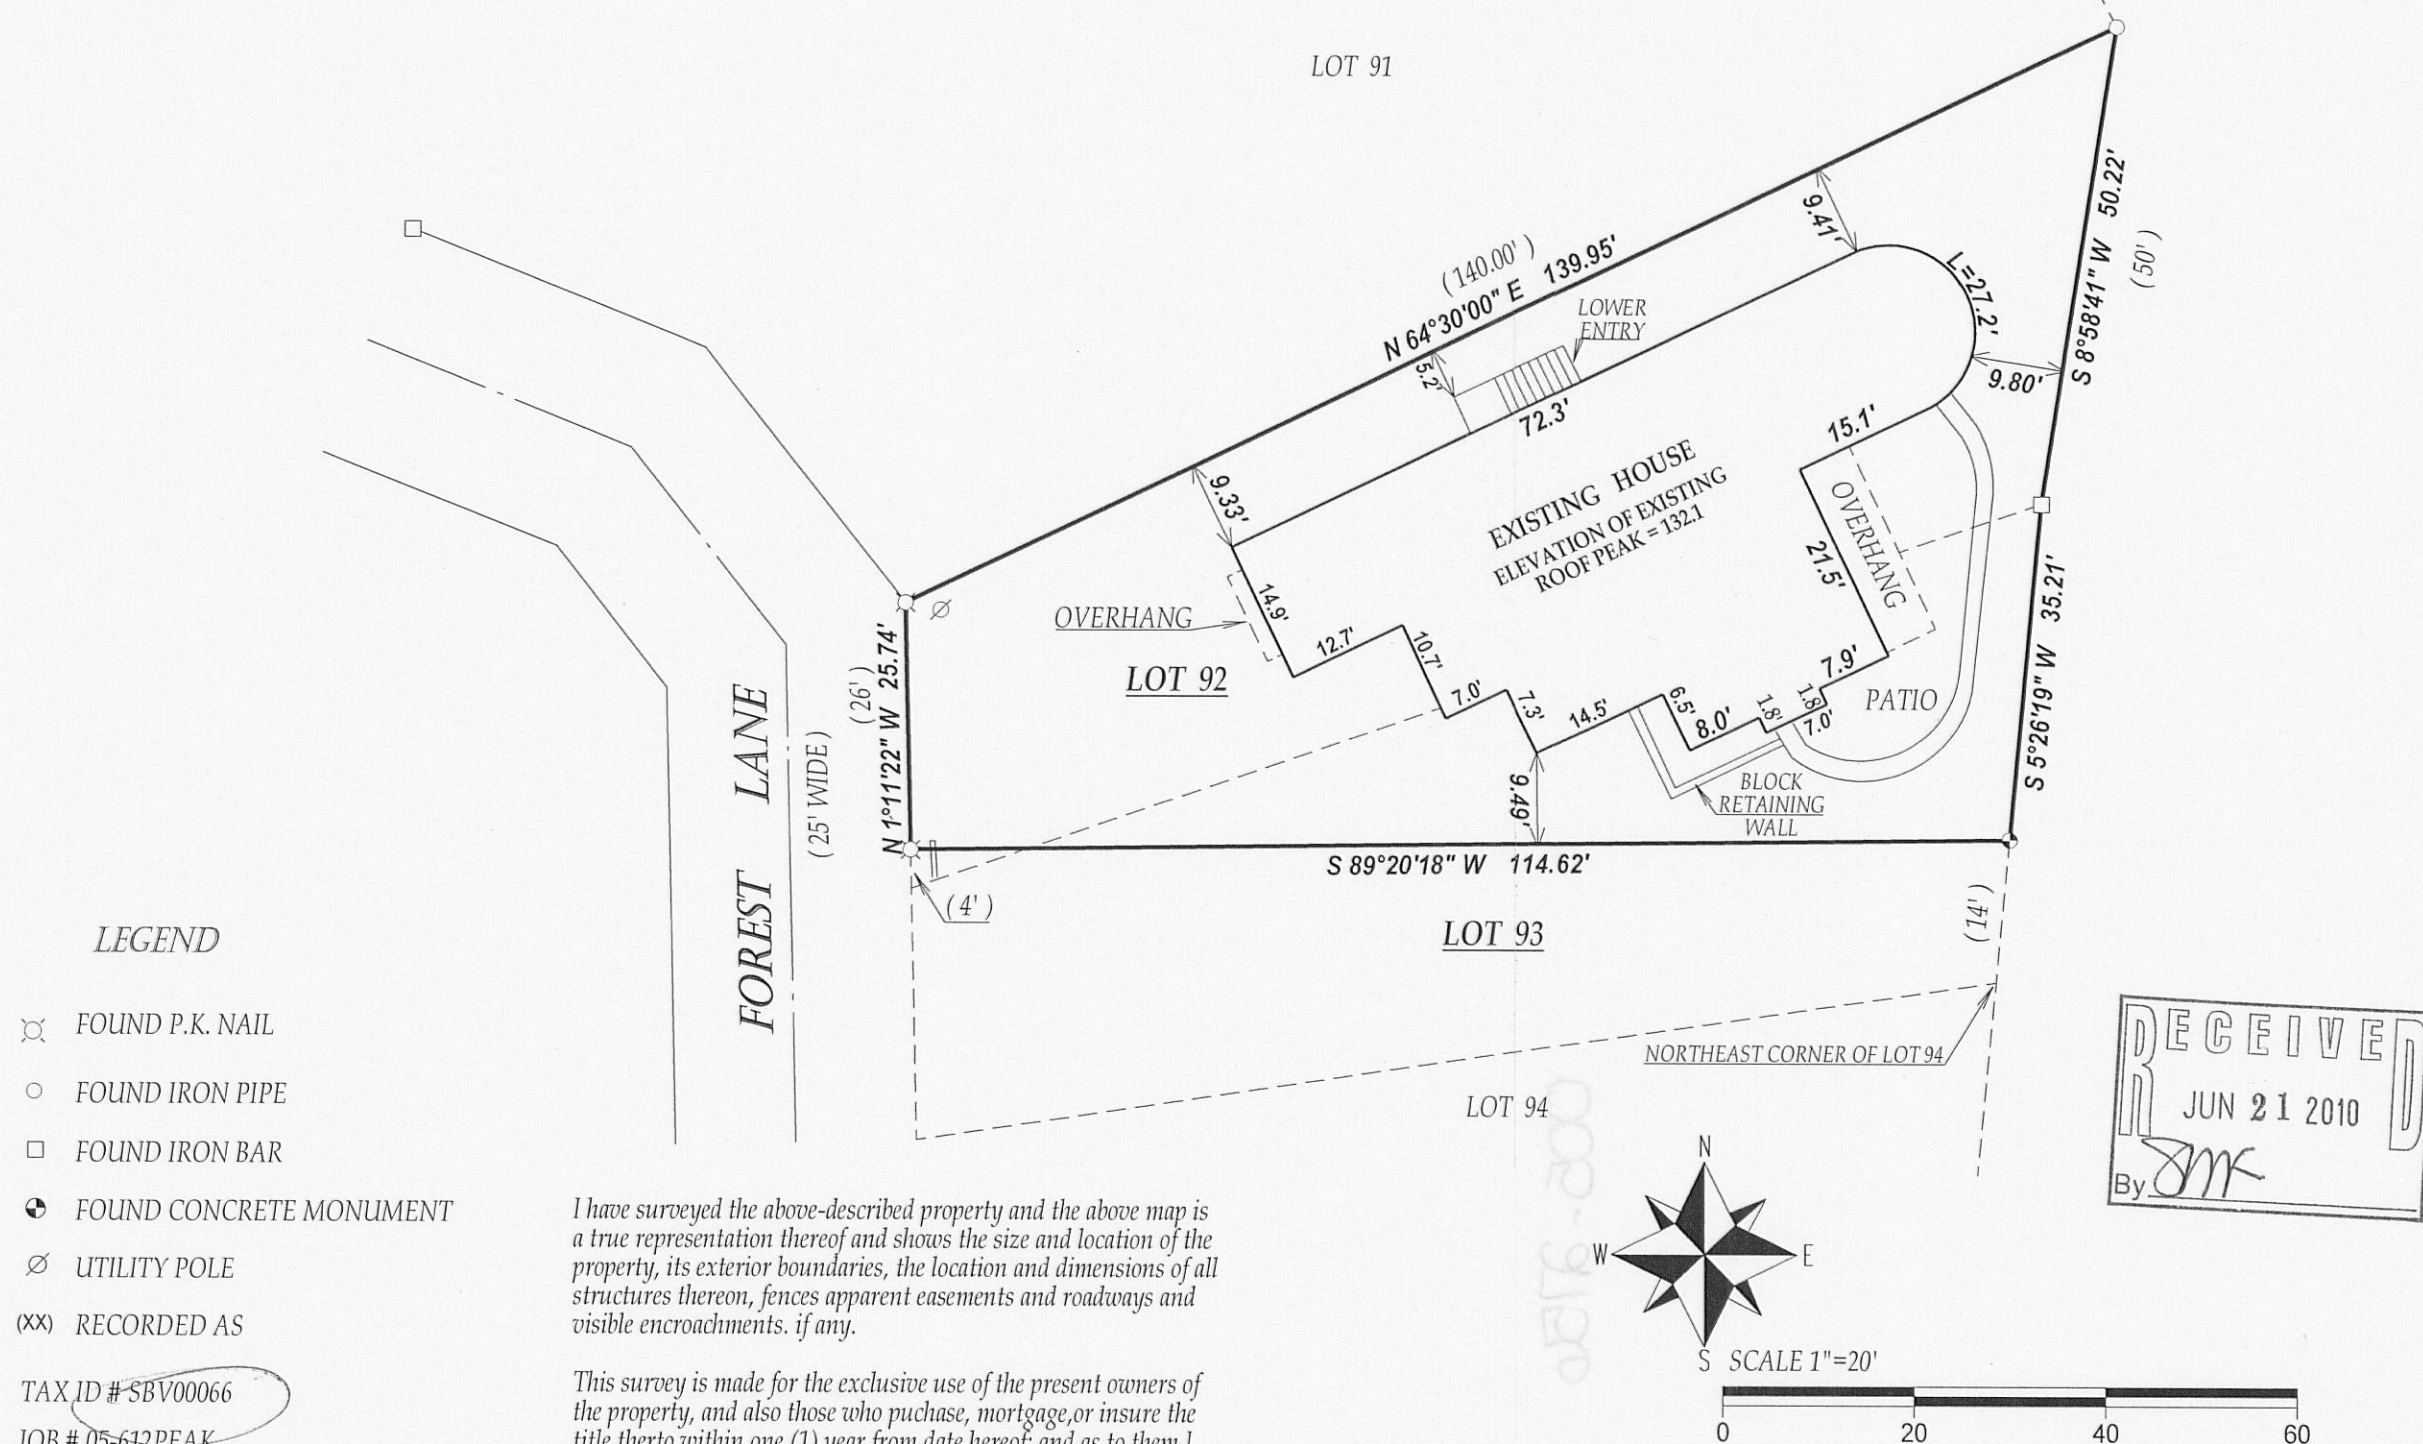

DATED THIS 25th, DAY OF NOVEMBER, 2009
DATE OF LAST REVISION 05/24/2010.

JOHN KROTT S - 2258
Wisconsin Registered Land Surveyor
(original if signed in red)

005-2750