
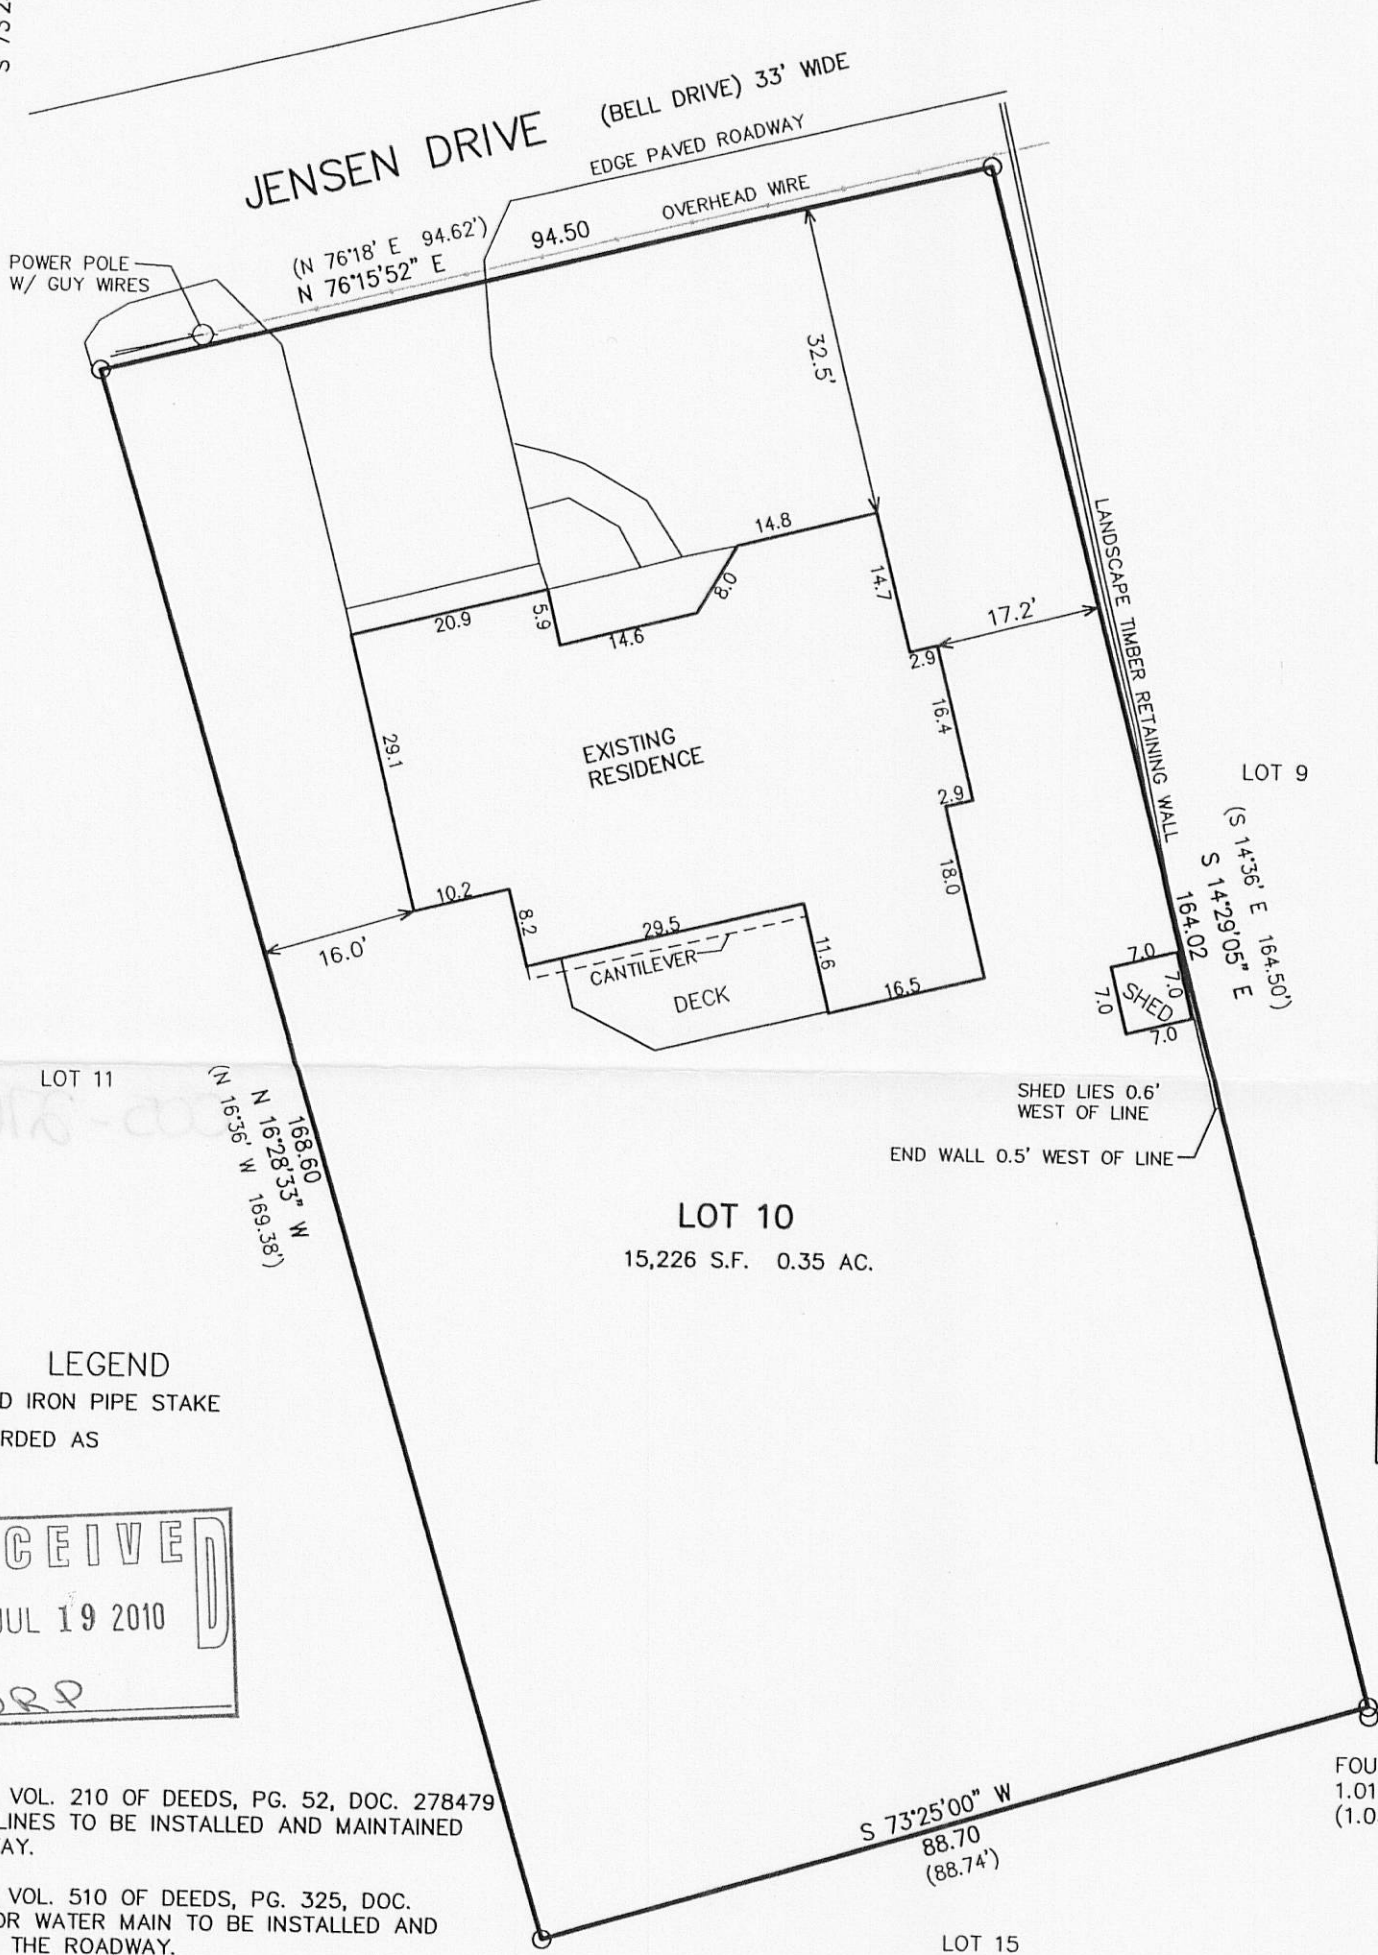
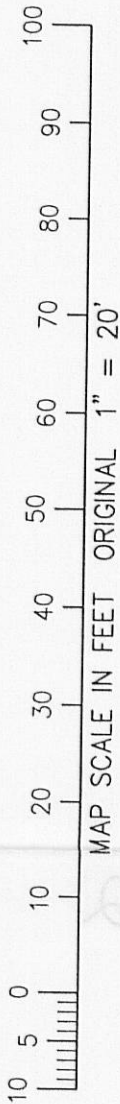


FARRIS, HANSEN & ASSOCIATES, INC.

ENGINEERING - ARCHITECTURE - SURVEYING
 7 RIDGWAY COURT - P.O. BOX 437 - ELKHORN, WISCONSIN 53121
 PHONE: (262) 723-2098 FAX: (262) 723-5886


PLAT OF SURVEY
 LOT 10 ADDITION 1 TO COUNTRY CLUB ESTATES
 LOCATED IN THE SW 1/4 SECTION 14, T1N, R16E
 VILLAGE OF FONTANA-ON-GENEVA LAKE, WALWORTH COUNTY, WI.

- WORK ORDERED BY -
 DERRICK CHATTERTON
 312 SUNSET RIDGE
 NORTHFIELD, IL. 60093

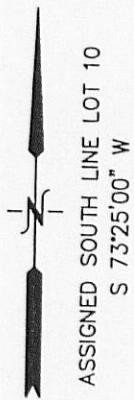

LEGAL DESCRIPTION
 Lot 10, Addition No. 1 to Country Club Estates, a subdivision located in the SE 1/4 of SW 1/4 and the SW 1/4 of SW 1/4 of Section 14, T1N, R16E, Village of Fontana, Walworth County, Wisconsin.
 Tax Key No. SCT 00010

LEGEND
 O = FOUND IRON PIPE STAKE
 (XXX) = RECORDED AS

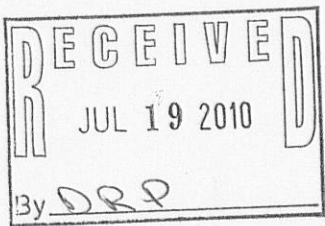

EASEMENT REC. IN VOL. 210 OF DEEDS, PG. 52, DOC. 278479
 ALLOWS FOR GAS LINES TO BE INSTALLED AND MAINTAINED
 WITHIN THE ROADWAY.

EASEMENT REC. IN VOL. 510 OF DEEDS, PG. 325, DOC.
 489552 ALLOWS FOR WATER MAIN TO BE INSTALLED AND
 MAINTAINED WITHIN THE ROADWAY.


NOTE: COPIES OF THIS MAP TO WHICH THE FOLLOWING CERTIFICATE WILL APPLY SHOW SURVEYOR'S ORIGINAL SEAL AND SIGNATURE IN RED INK. COPIES BY ANY OTHER MEANS MAY HAVE ALTERATIONS WHICH DO NOT REPRESENT THE SURVEYOR'S WORK PRODUCT.

I HEREBY CERTIFY THAT THE ABOVE DESCRIBED PROPERTY HAS BEEN SURVEYED UNDER MY DIRECTION AND THAT THE ABOVE MAP IS A TRUE REPRESENTATION THEREOF AND SHOWS THE SIZE AND LOCATION OF THE PROPERTY, ITS EXTERIOR BOUNDARIES, THE LOCATION OF ALL VISIBLE STRUCTURES, AND DIMENSIONS OF ALL PRINCIPLE BUILDINGS THEREON, BOUNDARY FENCES, APPARENT EASEMENTS, ROADWAYS, AND VISIBLE ENCROACHMENTS, IF ANY. THIS SURVEY IS MADE FOR THE USE OF THE PRESENT OWNERS OF THE PROPERTY, AND ALSO THOSE WHO PURCHASE, MORTGAGE, OR GUARANTEE THE TITLE THERETO WITHIN ONE YEAR FROM THE DATE HEREOF.

I FURTHER CERTIFY THAT THE LANDS SURVEYED FALL IN FLOOD HAZARD AREA "X" (AREAS DETERMINED TO BE OUTSIDE THE 0.2% ANNUAL CHANCE FLOODPLAIN), AS SHOWN ON FLOOD INSURANCE RATE MAP PANEL NO. 55127C0312D, EFFECTIVE DATE OF OCTOBER 2, 2009 AS PUBLISHED BY THE FEDERAL EMERGENCY MANAGEMENT AGENCY.

DATED: JUNE 9, 2010

Peter S. Gordon
 PETER S. GORDON R.L.S. 2101

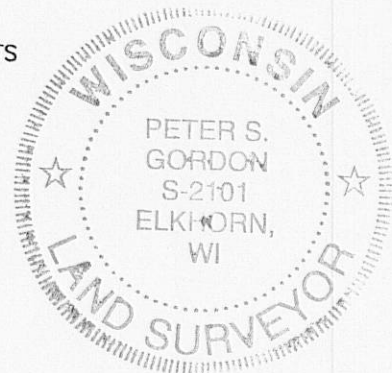

PROJECT: 8152
 DATE: 05-25-2010
 SHEET 1 OF 1

X:\Projects\8152\dcad\survey

6/9/2010

JUN 09 2010 8152-10

005-2762-9100