


GEORGE T. DUNHAM  
 SURVEYING & SUBDIVIDING  
 DELAVAN, WISCONSIN

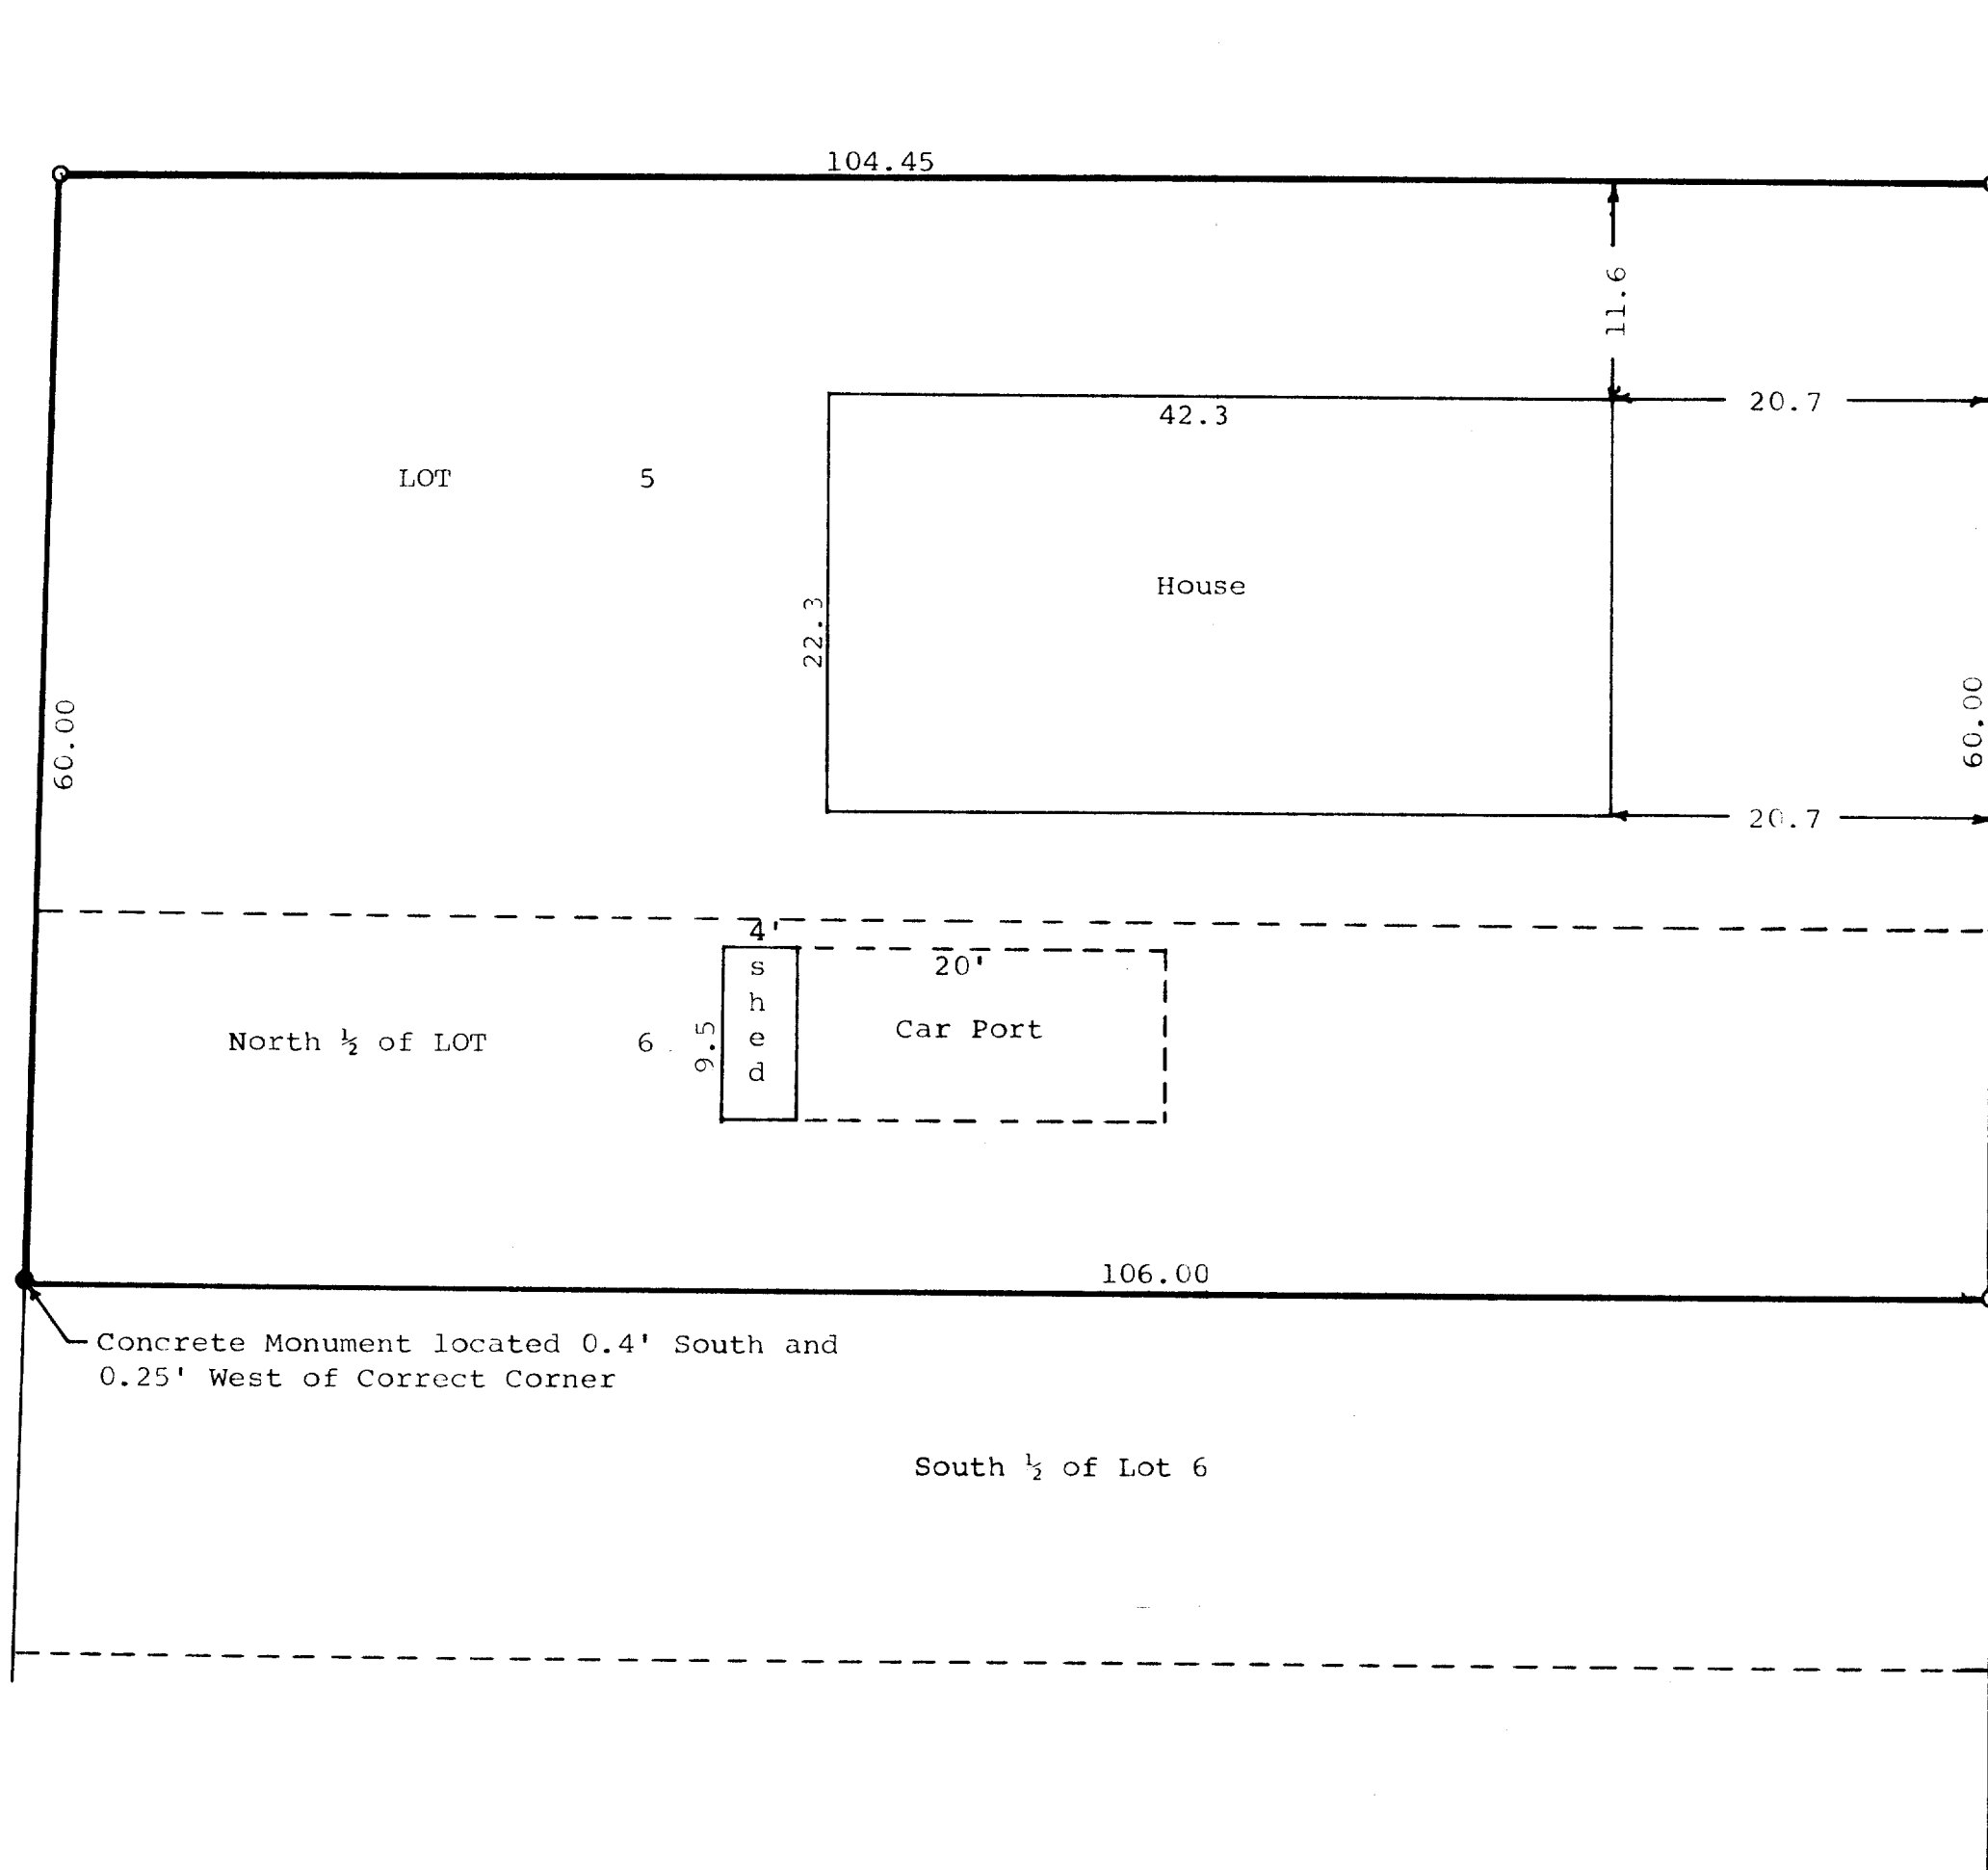

Scale - 1" = 10'  
 ○ = Iron Pipe  
 ● = Concrete Monument

STATE OF WISCONSIN) SS  
 COUNTY OF WALWORTH)

I, George T. Dunham, Surveyor, certify that I have surveyed the property described as follows,  
 Lot 5 and the North 1/2 of Lot 6 in Block No. 4 of D. A. Reid's Addition to Reids Park, Village of Fontana, Walworth County, Wisconsin,  
 and that the above plat is an accurate survey and a true representation thereof and correctly shows the exterior boundary lines and location of buildings on said property and the correct measurements thereof.  
 February 16, 1971

*George T. Dunham*  
 George T. Dunham, Surveyor

