PREPARED FOR:

FRED PAPPAS


PLAT OF SURVEY


- OF -

LOTS4 AND THE EAST 1/2 OF LOT 5, BLOCK 6, INDIAN HILLS SUBDIVISION; LOCATED IN THE VILLAGE OF FONTANA-ON-GENEVA LAKE, WALWORTH COUNTY, WISCONSIN.

PATHFINDER SURVEYING INC. (formerly) J.K. SURVEYING INC. W2888 KRUEGER RD. STE. "D" 262-248-8303

S. LAKESHORE DRIVE

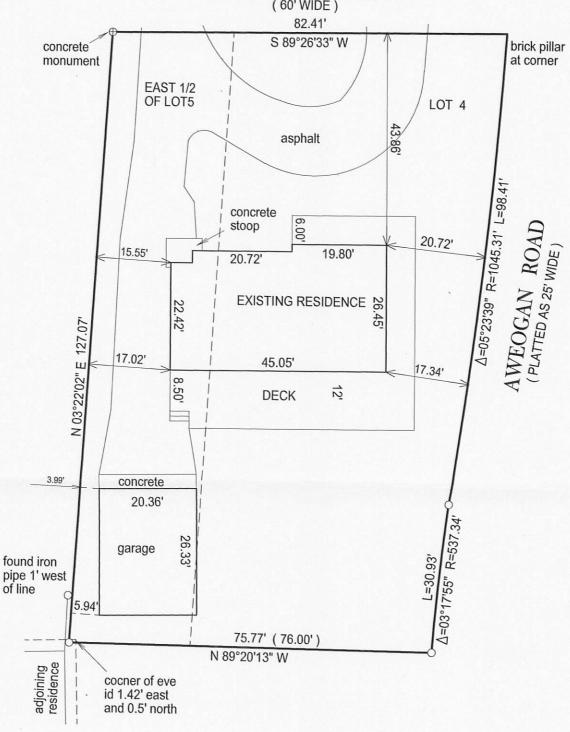


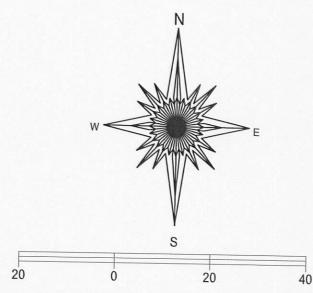

BASIS OF BEARING OF THIS PLAT WAS BASED ON MAGNETIC NORTH.

"I hereby certify that I have surveyed the above described property and that the above map is a true representation thereof and shows the size and location of all visible structures, apparent easements and encroachments if any."

This survey is made for the present owners of the property, and those who purchase, mortgage, or guarantee the title thereto, within one year from the date hereof.

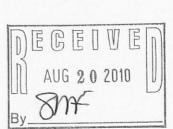



JEFFREY L KIMPS S - 2436 Wisconsin Registered Land Surveyor (original if signed in red)

DATED THIS 29TH DAY OF APRIL, 2010.

TAX1D # SIHB 00004

()= recorded as

= found iron bar

= set iron pipe

= set iron bar

SCALE 1" = 20'

JOB # 10-56

= found iron pipe