


N



- = Concrete Monument
- = Iron Pipe

George T. Dunham
George T. Dunham, Surveyor

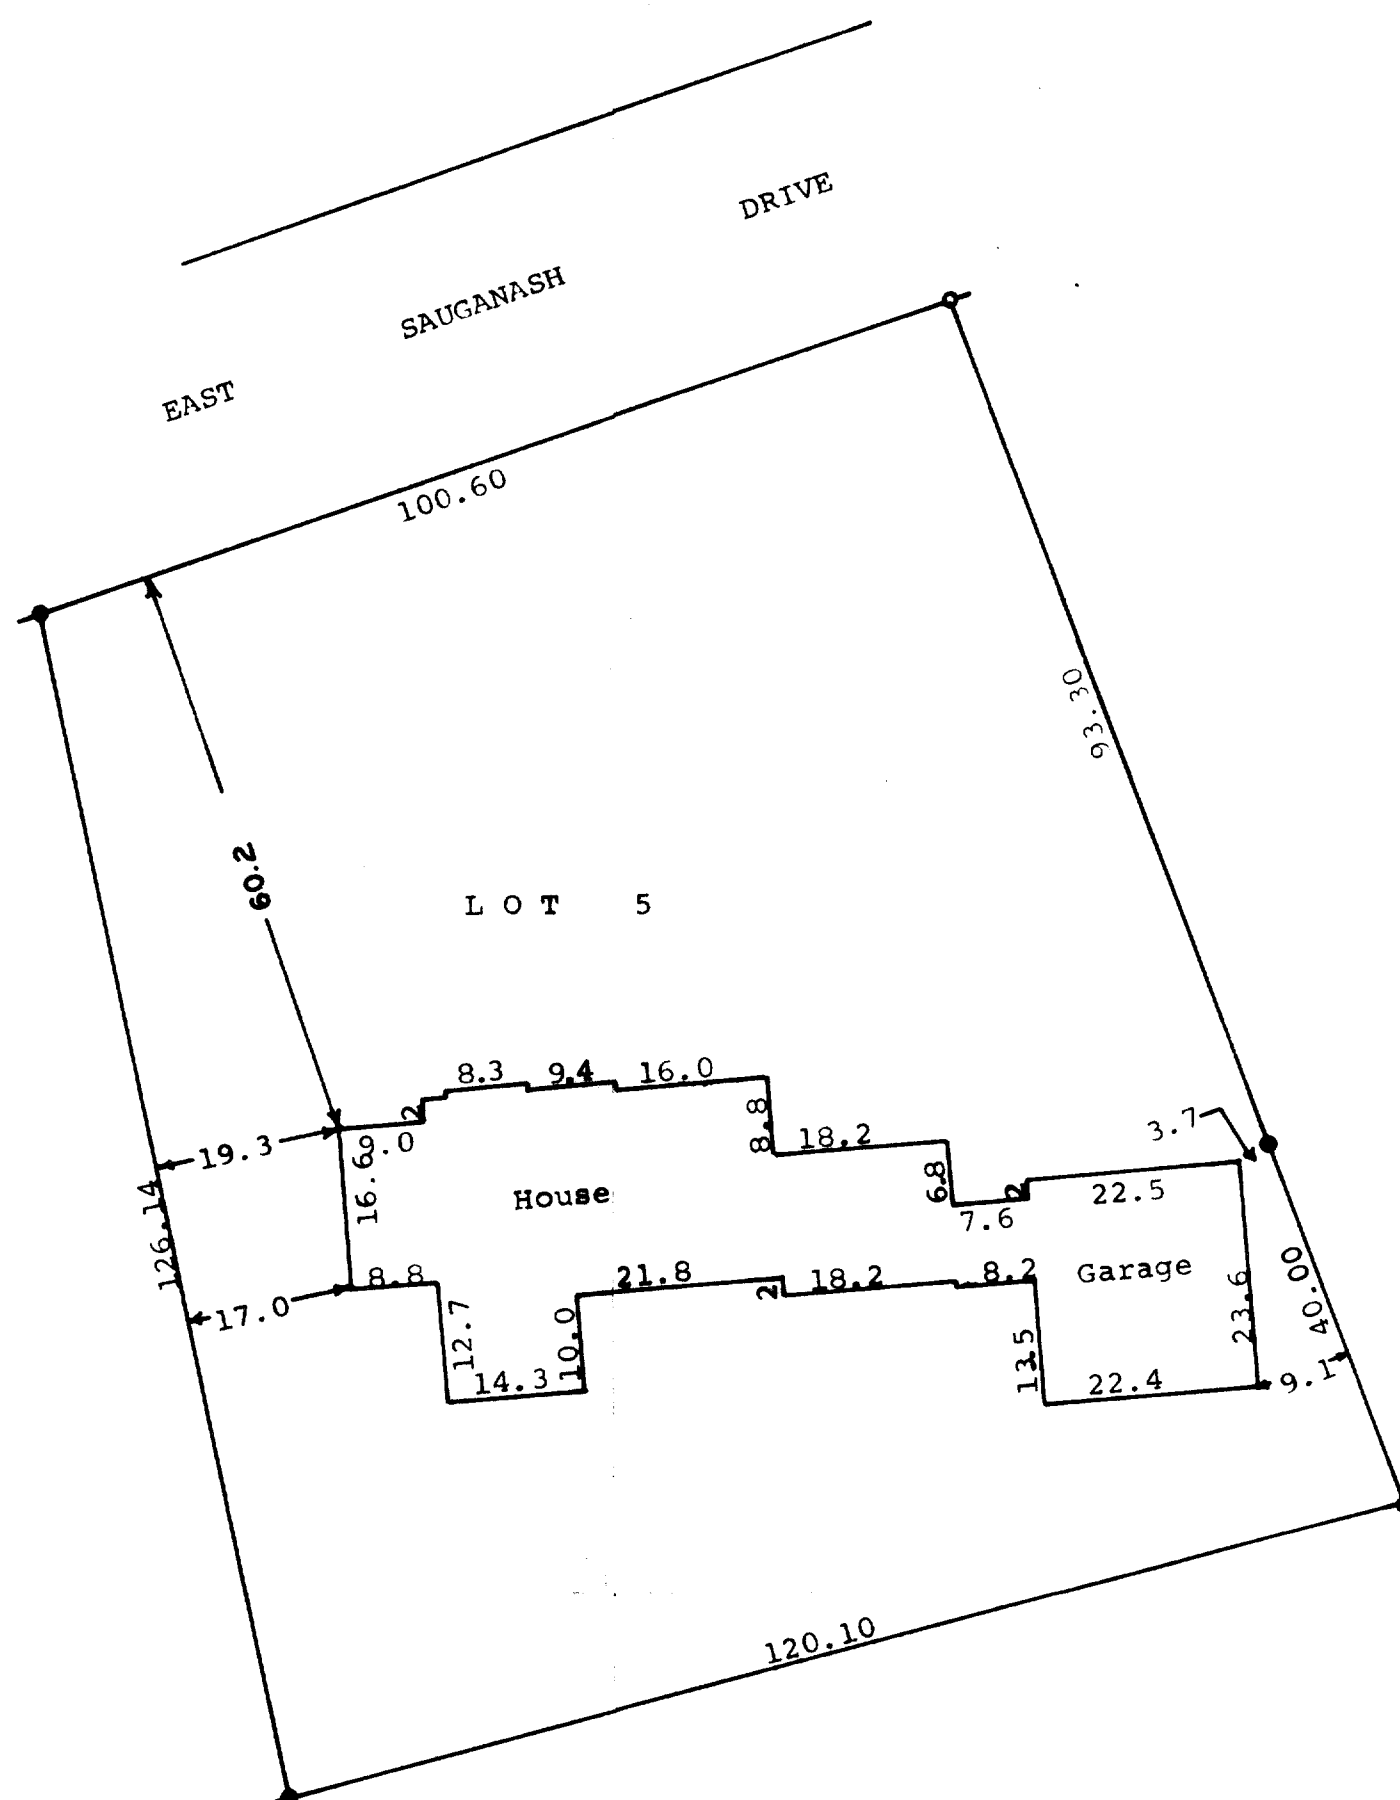