

PREPARED FOR:
 PHILLIP COSTA
 191 FARMGATE LN.
 PALATINE, IL 60067




PLAT OF SURVEY

-OF-

KROTT SURVEYING INC.

N3705 WILLOW BEND LANE
 LAKE GENEVA WI. 53147
 PHONE # (262)248-3697
 FAX # (262)249-0639

LOT 1, ADDITION "D" TO COUNTRY CLUB ESTATES, LOCATED IN THE VILLAGE OF FONTANA-ON GENEVA LAKE, WALWORTH COUNTY, WISCONSIN, EXCEPTING THEREFROM THAT PART OF LOT 1 DESCRIBED AS FOLLOWS: COMMENCING AT THE SOUTHEAST CORNER OF SAID LOT 1, THENCE N 00°12' E ALONG THE EASTERLY LINE OF SAID LOT 1, 37.61 FEET TO THE PLACE OF BEGINNING; THENCE N 10°53' W 44.72 FEET; THENCE N 09°32' E 52.99 FEET TO THE NORTHEASTERLY CORNER OF SAID LOT 1; THENCE S 00°12' W 96.18 FEET TO THE PLACE OF BEGINNING.

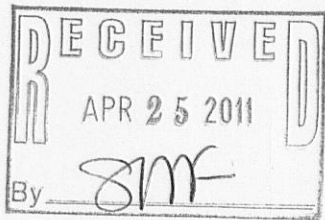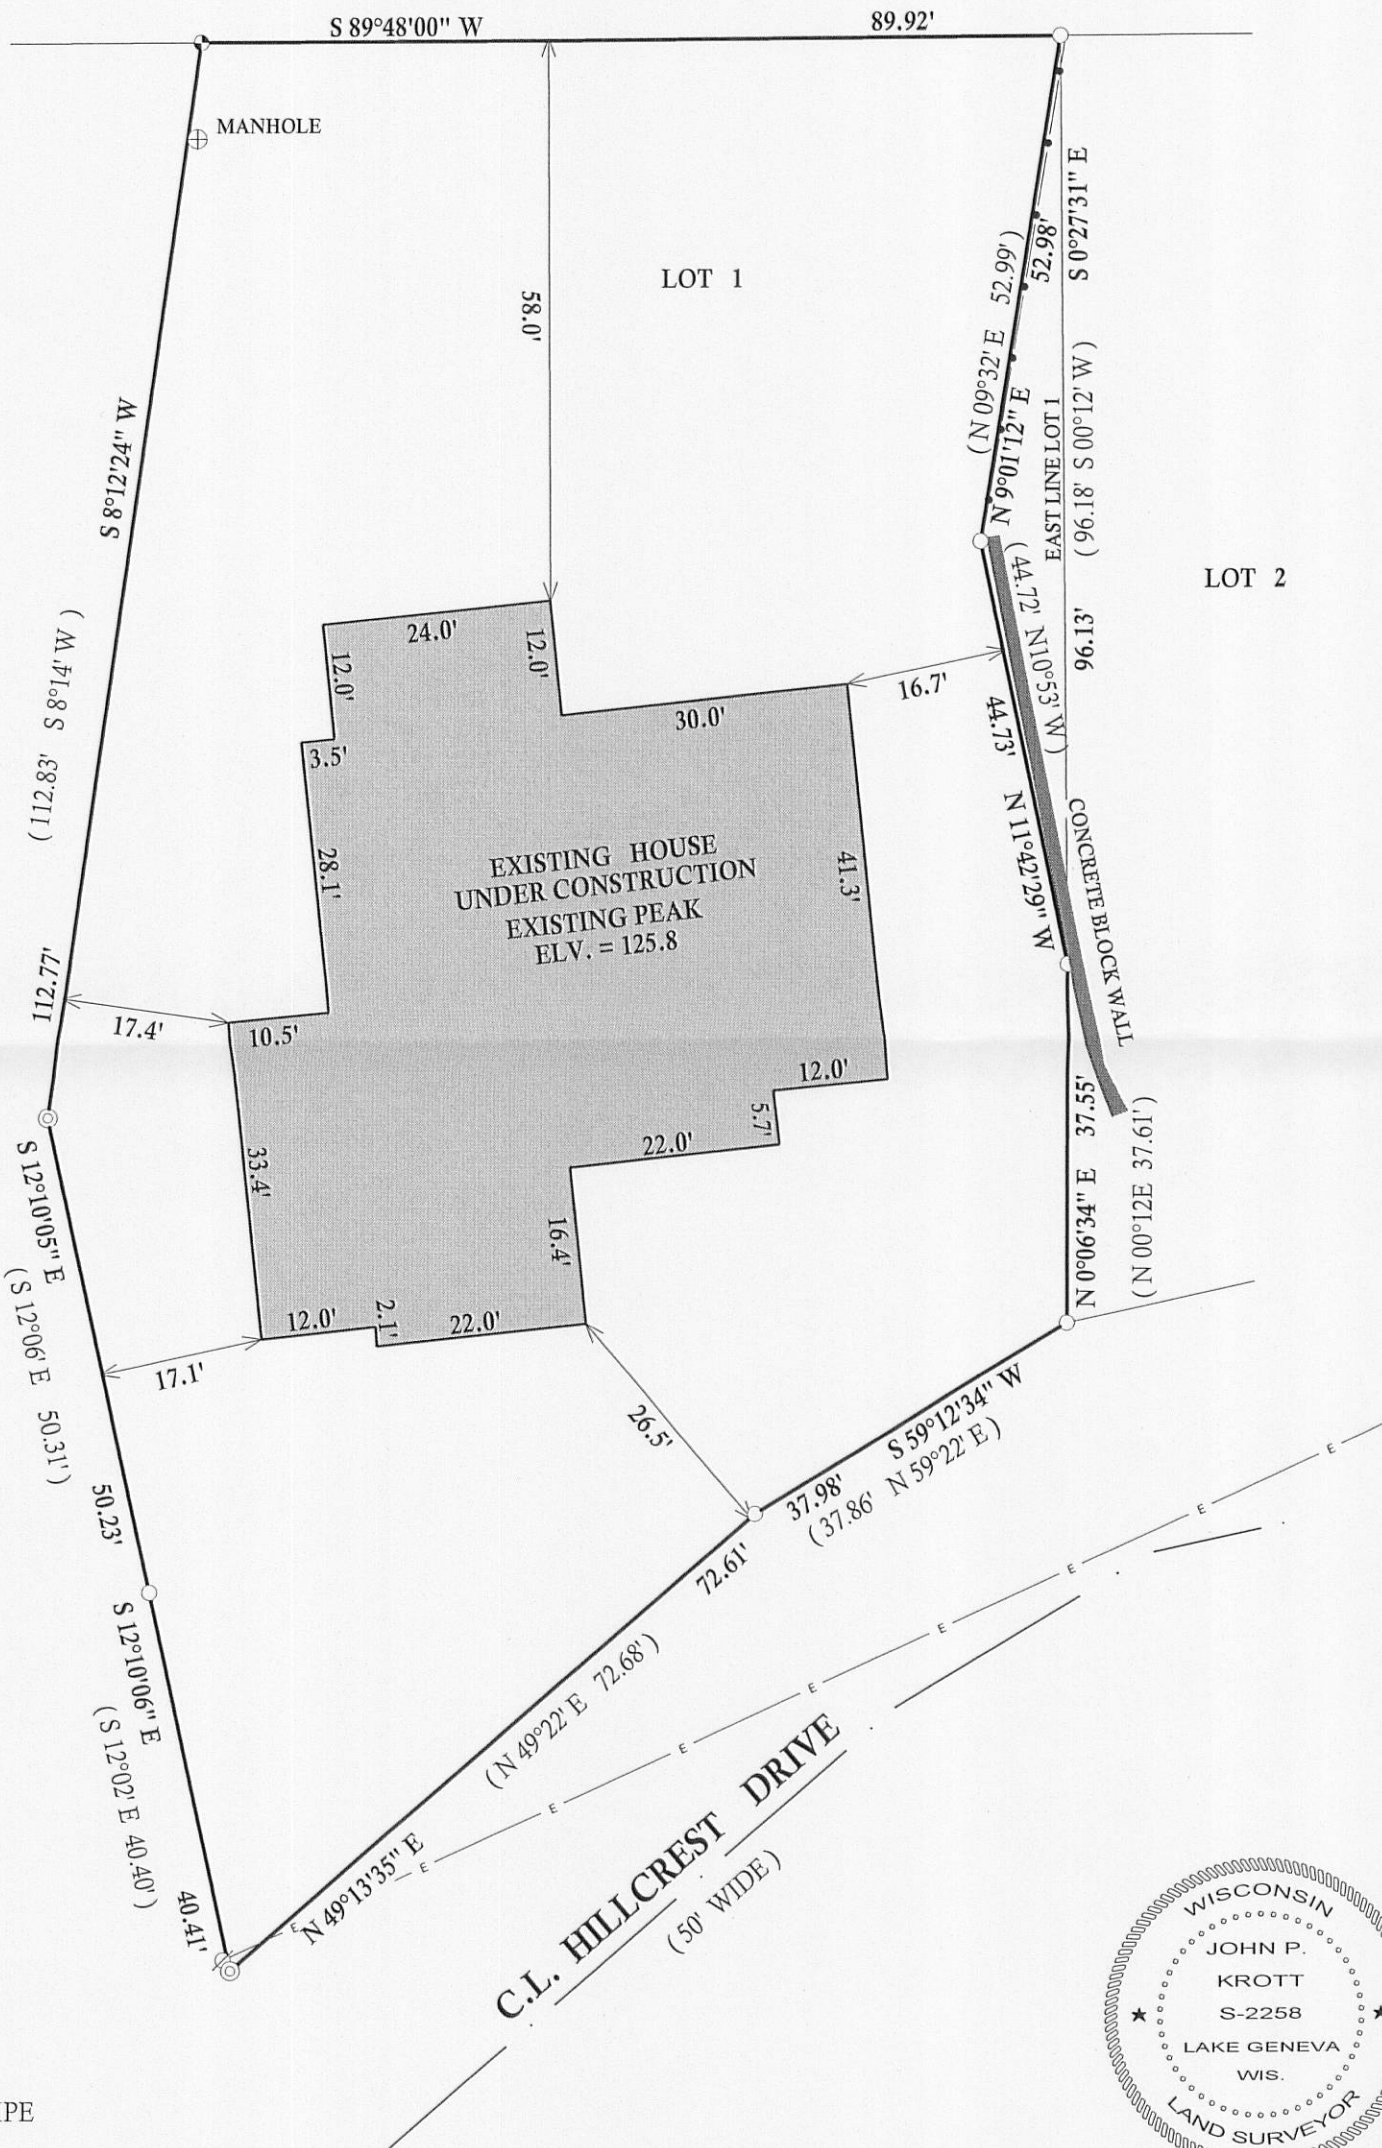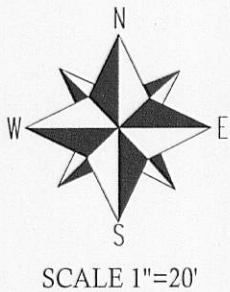

LEGEND

- ROCK WALL
- E— OVERHEAD UTILITIES
- CHAIN LINK FENCE
- ⊙ FOUND 2" DIA. IRON PIPE
- ⊕ CONCRETE MONUMENT
- FOUND 1" DIA. IRON PIPE
- FOUND IRON BAR
- SET IRON BAR


(XX) RECORDED AS

TAX ID # SCTD 00001
 JOB # 10-124PEAK

BEARINGS REFERENCED TO THE RECORD PLAT

I have surveyed the above-described property and the above map is a true representation thereof and shows the size and location of the property, its exterior boundaries, the location and dimensions of all structures thereon, fences apparent easements and roadways and visible encroachments, if any.

This survey is made for the exclusive use of the present owners of the property, and also those who purchase, mortgage, or insure the title thereto within one (1) year from date hereof; and as to them I warrant the accuracy of said survey map.

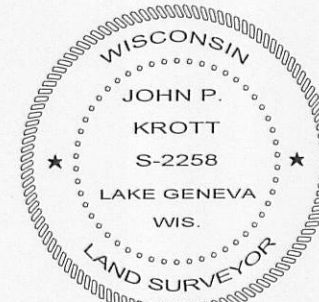

DATED THIS 3rd, DAY OF AUGUST, 2010
 DATE OF LAST REVISION: 02 / 28 / 2011
 REVISED 01 / 28 / 2011
 REVISED 12 / 02 / 2010

John P. Krott

JOHN KROTT S - 2258
 Wisconsin Registered Land Surveyor
 (original if signed in red)

005-28260-92000