LAND-MARK SURVEYING


Mark L. Miritz

Wisconsin Registered Land Surveyor S-2582

N9330 Knuteson Drive Whitewater, WI 53190 Phone: (262)495-3284 FAX: (262) 495-8421 LAND-MARKSURVEYING.COM

PLAT OF SURVEY

LOTS 7 AND 28 IN BLOCK 4 OF C.L. DOUGLAS' ADDITION NO. 1, KNOWN AS THE ASSESSOR'S PLAT OF FONTANA. LOCATED IN THE NORTHEAST 1/4 OF SECTION 15, TOWN 1 NORTH, RANGE 16 EAST, VILLAGE OF FONTANA-ON-GENEVA LAKE, WALWORTH COUNTY, WISCONSIN.

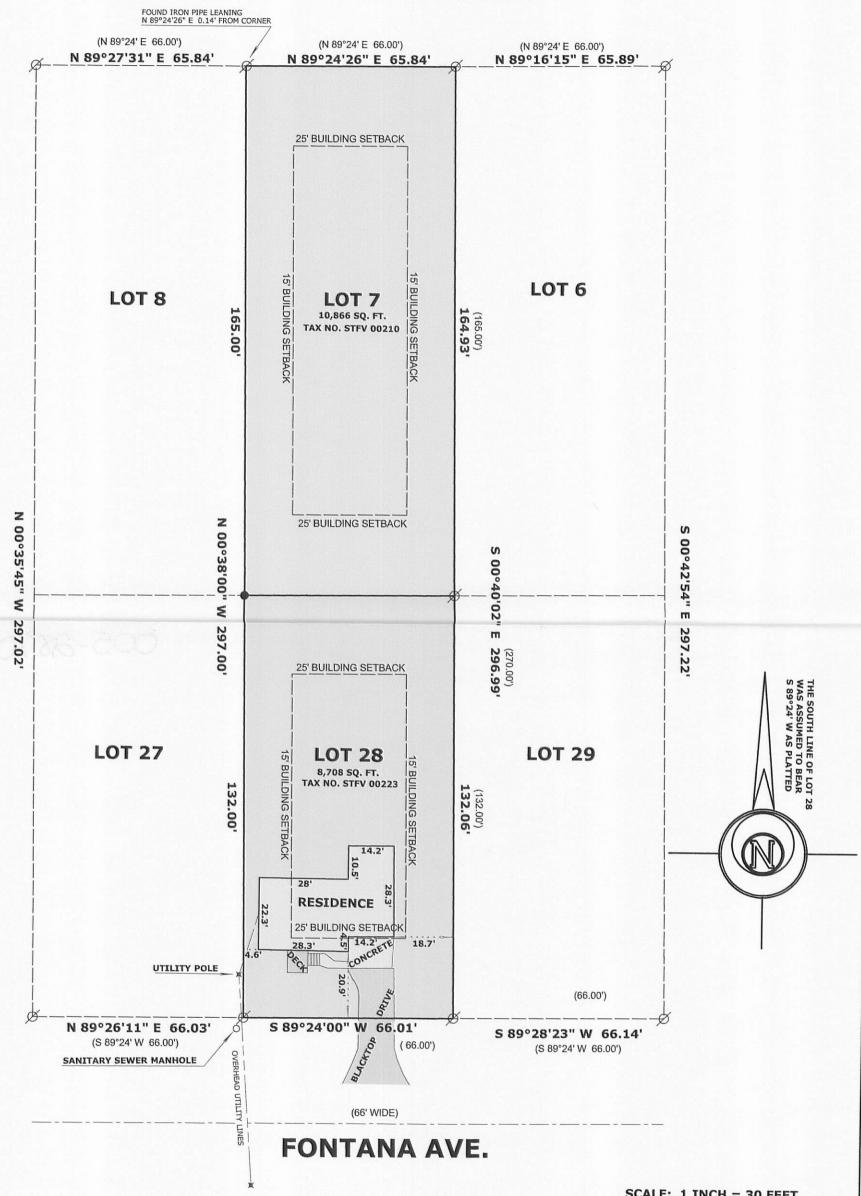

LEGEND

FOUND IRON PIPE 1"

SET IRON ROD, 18" LONG, WEIGHING 1.5 LBS./LINEAL FT., 3/4" DIA.

RECORDED AS DIMENSION





SCALE: 1 INCH = 30 FEET

"I hereby certify that the above described property has been surveyed by me or under my direction and that the above map is a true representation thereof and shows the size and location of the property, its exterior boundaries, the location of all visible structures and dimensions of all principal buildings thereon, boundary fences, apparent easements, roadways and visible encroachments, if any."

"This survey is made for the use of the present owners of the property, and also those who purchase, mortgage, or guarantee the title thereto within one year from date

> MARK L. MIRITZ WISCONSIN REGISTERED

LAND SURVEYOR S-2582

DATE: APRIL 17, 2011 JOB NO. 11.408