


HAROLD H. KOLB

REGISTERED PROFESSIONAL LAND SURVEYOR
LAKE GENEVA, WISCONSIN

PLAT OF SURVEY OF
Lot 1 and the East 1/2 of Lot 2, Block
5, Glenwood Springs Subdivision,
Village of Fontana-on-Geneva-Lake,
Walworth County, Wisconsin.

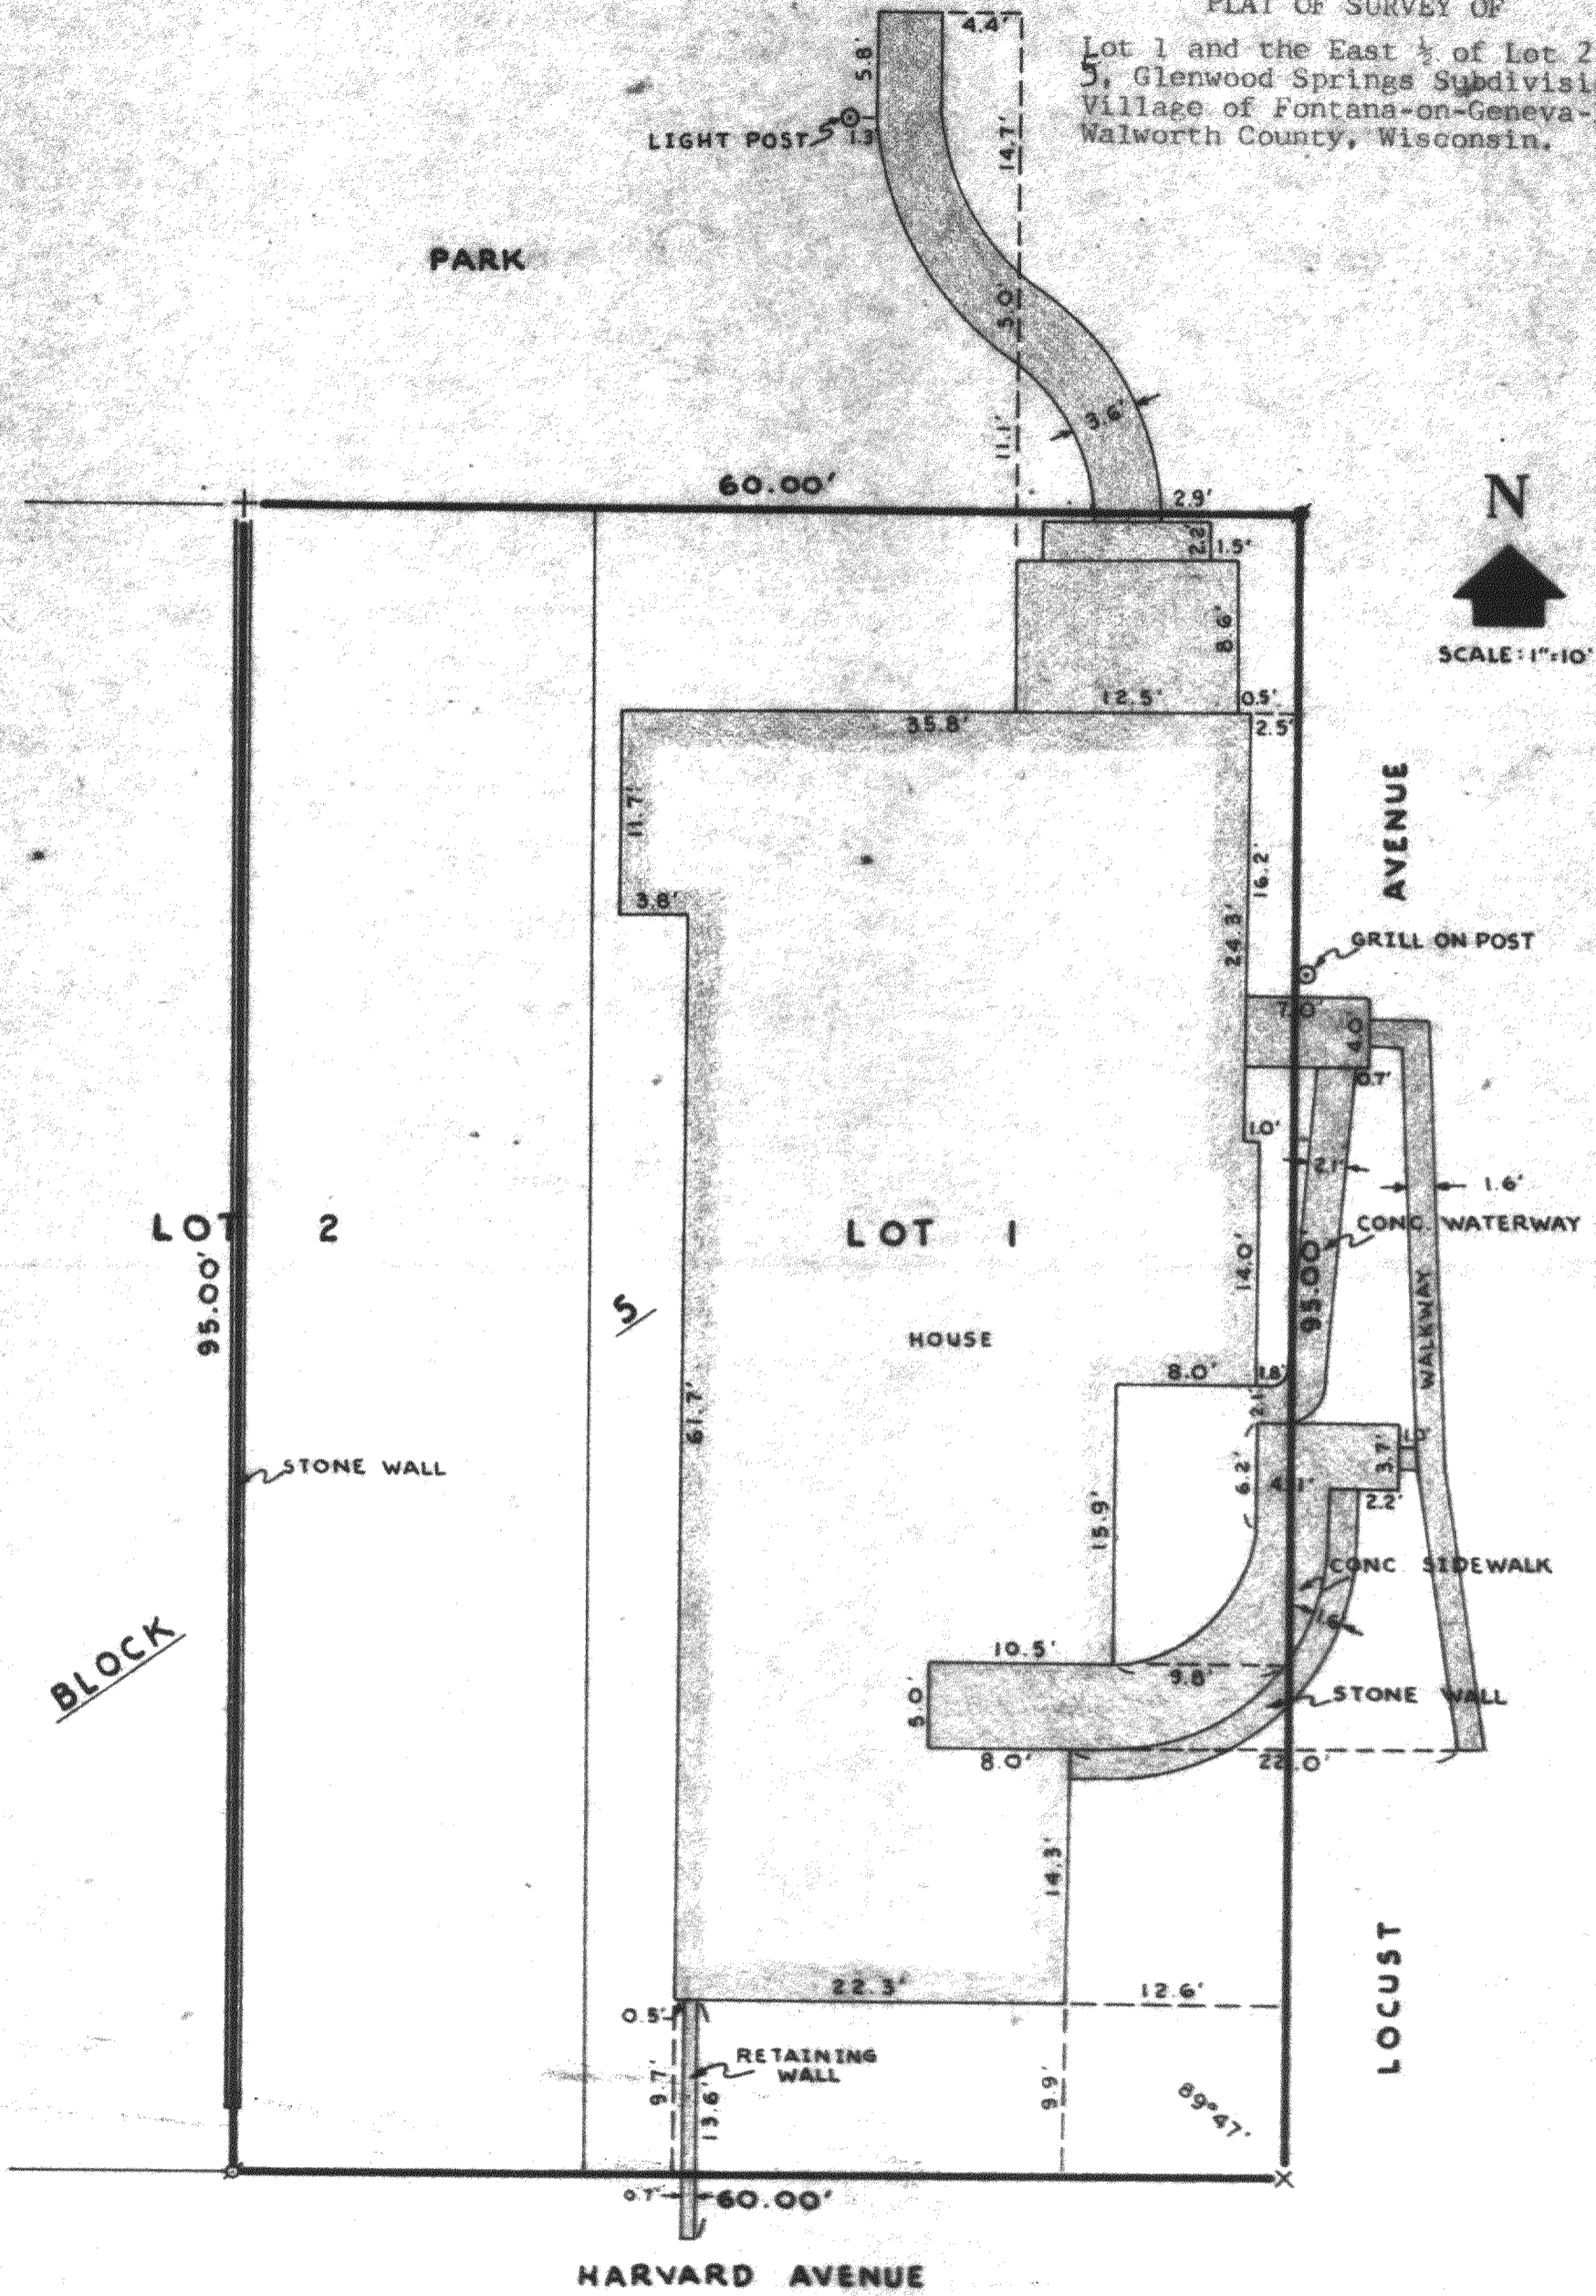

BLOCK

LOT 2

LOT 1

HOUSE


AVENUE

LOCUST

HARVARD AVENUE

LEGEND

- - IRON PIPE FOUND
- - IRON PIPE PLACED
- ⊕ - Found Iron Rod
- ⊕ - SPIKE
- ⊕ - Found Cross-Cut In Concrete

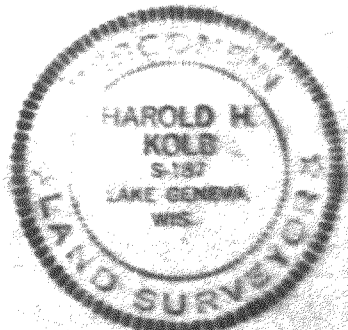

I, HAROLD H. KOLB, DO HEREBY CERTIFY THAT I HAVE SURVEYED THE PROPERTY HEREON DESCRIBED ACCORDING TO THE OFFICIAL RECORDS, AND THAT THE PLAT HEREON IS A CORRECT REPRESENTATION OF THE LOT LINES.

Harold H. Kolb
HAROLD H. KOLB
WISCONSIN REGISTERED LAND SURVEYOR, S-187
DATE March 23, 1973