

PHONE: (262) 723-2098 FAX: (262) 723-5886 PLAT OF SURVEY

LOTS 7 & 8 OF BLOCK 9, GLENWOOD SPRINGS, A SUBDIVISION LOCATED IN PERT OF THE SOUTHEAST FRACTIONAL 1/4 OF SECTION 14, TOWN 1 NORTH, RANGE 16 EAST, VILLAGE OF FONTANA—ON—GENEVA

WORK ORDERED BY –
 MELINDA SNELL
 3436 PIPING ROCK
 HOUSTON, TX 77027

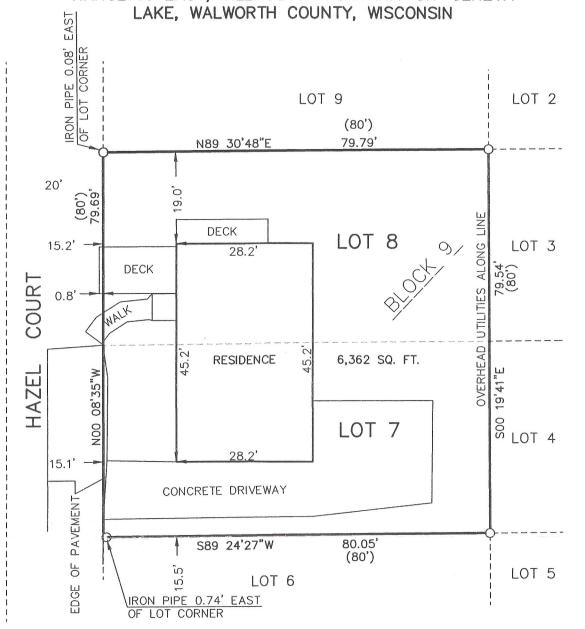

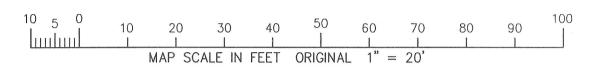

LEGEND
O = FOUND IRON PIPE STAKE
(XXX) = RECORDED AS

NOTE: COPIES OF THIS MAP TO WHICH THE FOLLOWING CERTIFICATE WILL APPLY SHOW THE SURVEYOR'S ORIGINAL SEAL AND SIGNATURE IN RED INK. COPIES BY ANY OTHER MEANS MAY HAVE ALTERATIONS WHICH DO NOT REPRESENT THE SURVEYOR'S WORK PRODUCT.

I HEREBY CERTIFY THAT THE ABOVE DESCRIBED PROPERTY HAS BEEN SURVEYED UNDER MY DIRECTION AND THAT THE ABOVE MAP IS A TRUE REPRESENTATION THEREOF AND SHOWS THE SIZE AND LOCATION OF THE PROPERTY AND ITS EXTERIOR BOUNDARIES. THIS SURVEY IS MADE FOR THE USE OF THE PRESENT OWNERS OF THE PROPERTY, AND ALSO THOSE WHO PURCHASE, MORTGAGE, OR GUARANTEE THE TITLE THERETO WITHIN ONE YEAR FROM THE DATE HEREOF.

DATED: FEBRUARY 15, 2012

LOT

9

ASSIGNED THE SOUTH LINE S 89D24'27" W

PETER S. GORDÓN R.L.S. 2101





PROJECT: 8513 DATE: 02-15-2012 SHEET 1 OF 1