

— WORK ORDERED BY —
JORNDT FAHEY REMODELING, LLC
168 ELKHORN ROAD
WILLIAMS BAY, WI 53191

FARRIS, HANSEN & ASSOCIATES, INC.
ENGINEERING — ARCHITECTURE — SURVEYING
7 RIDGWAY COURT P.O. BOX 437
ELKHORN, WISCONSIN 53121
OFFICE: (262) 723-2098 FAX: (262) 723-5886

REVISIONS

PROJECT NO.
5952.12
DATE:
01-12-02
SHEET NO.
1 OF 1

PLAT OF SURVEY

LOT 10 OF COUNTRY CLUB ESTATES ADDITION "K"

LOCATED IN SECTIONS 22 & 23, TOWN 1 NORTH,
RANGE 16 EAST, VILLAGE OF FONTANA-ON-GENEVA
LAKE, WALWORTH COUTNY, WISCONSIN

LEGEND

- = FOUND IRON REBAR STAKE
- = SET IRON REBAR STAKE
- = UTILITY BOX LOCATED
- = MANHOLE LOCATED
- {XXX} = RECORDED AS


NOTE: COPIES OF THIS MAP TO WHICH THE FOLLOWING CERTIFICATE
WILL APPLY SHOW THE SURVEYOR'S ORIGINAL SEAL AND SIGNATURE
IN RED INK. COPIES BY ANY OTHER MEANS MAY HAVE ALTERATIONS
WHICH DO NOT REPRESENT THE SURVEYOR'S WORK PRODUCT.

I HEREBY CERTIFY THAT THE ABOVE DESCRIBED PROPERTY HAS BEEN
SURVEYED UNDER MY DIRECTION AND THAT THE ABOVE MAP IS A TRUE
REPRESENTATION THEREOF AND SHOWS THE SIZE AND LOCATION OF
THE PROPERTY AND ITS EXTERIOR BOUNDARIES. THIS SURVEY IS
MADE FOR THE USE OF THE PRESENT OWNERS OF THE PROPERTY, AND
ALSO THOSE WHO PURCHASE, MORTGAGE, OR GUARANTEE THE TITLE
THERETO WITHIN ONE YEAR FROM THE DATE HEREOF.


DATED: JAN. 14, 2002
REVISED 02-20-2002 TO SHOW SIZE & LOCATION OF
FOUNDATION AS BUILT

PETER S. GORDON R.L.S. 2101

REVISED 1/24/2012-KB
TO SHOW SIZE AND
LOCATION OF
PROPOSED ADDITION
REVISED 02-08-2012
TO SHOW AS BUILT
ADDITION

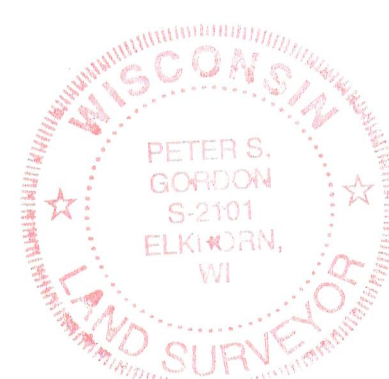

LINE	BEARING	DISTANCE
L1	N 25°09'27" E	22.00'

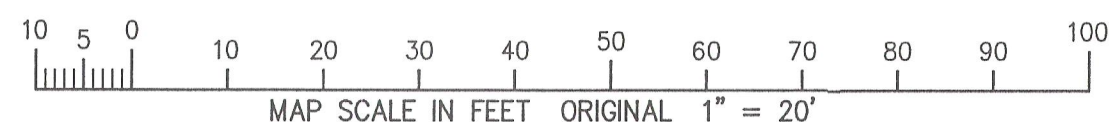

SC7K-10

005-2907