
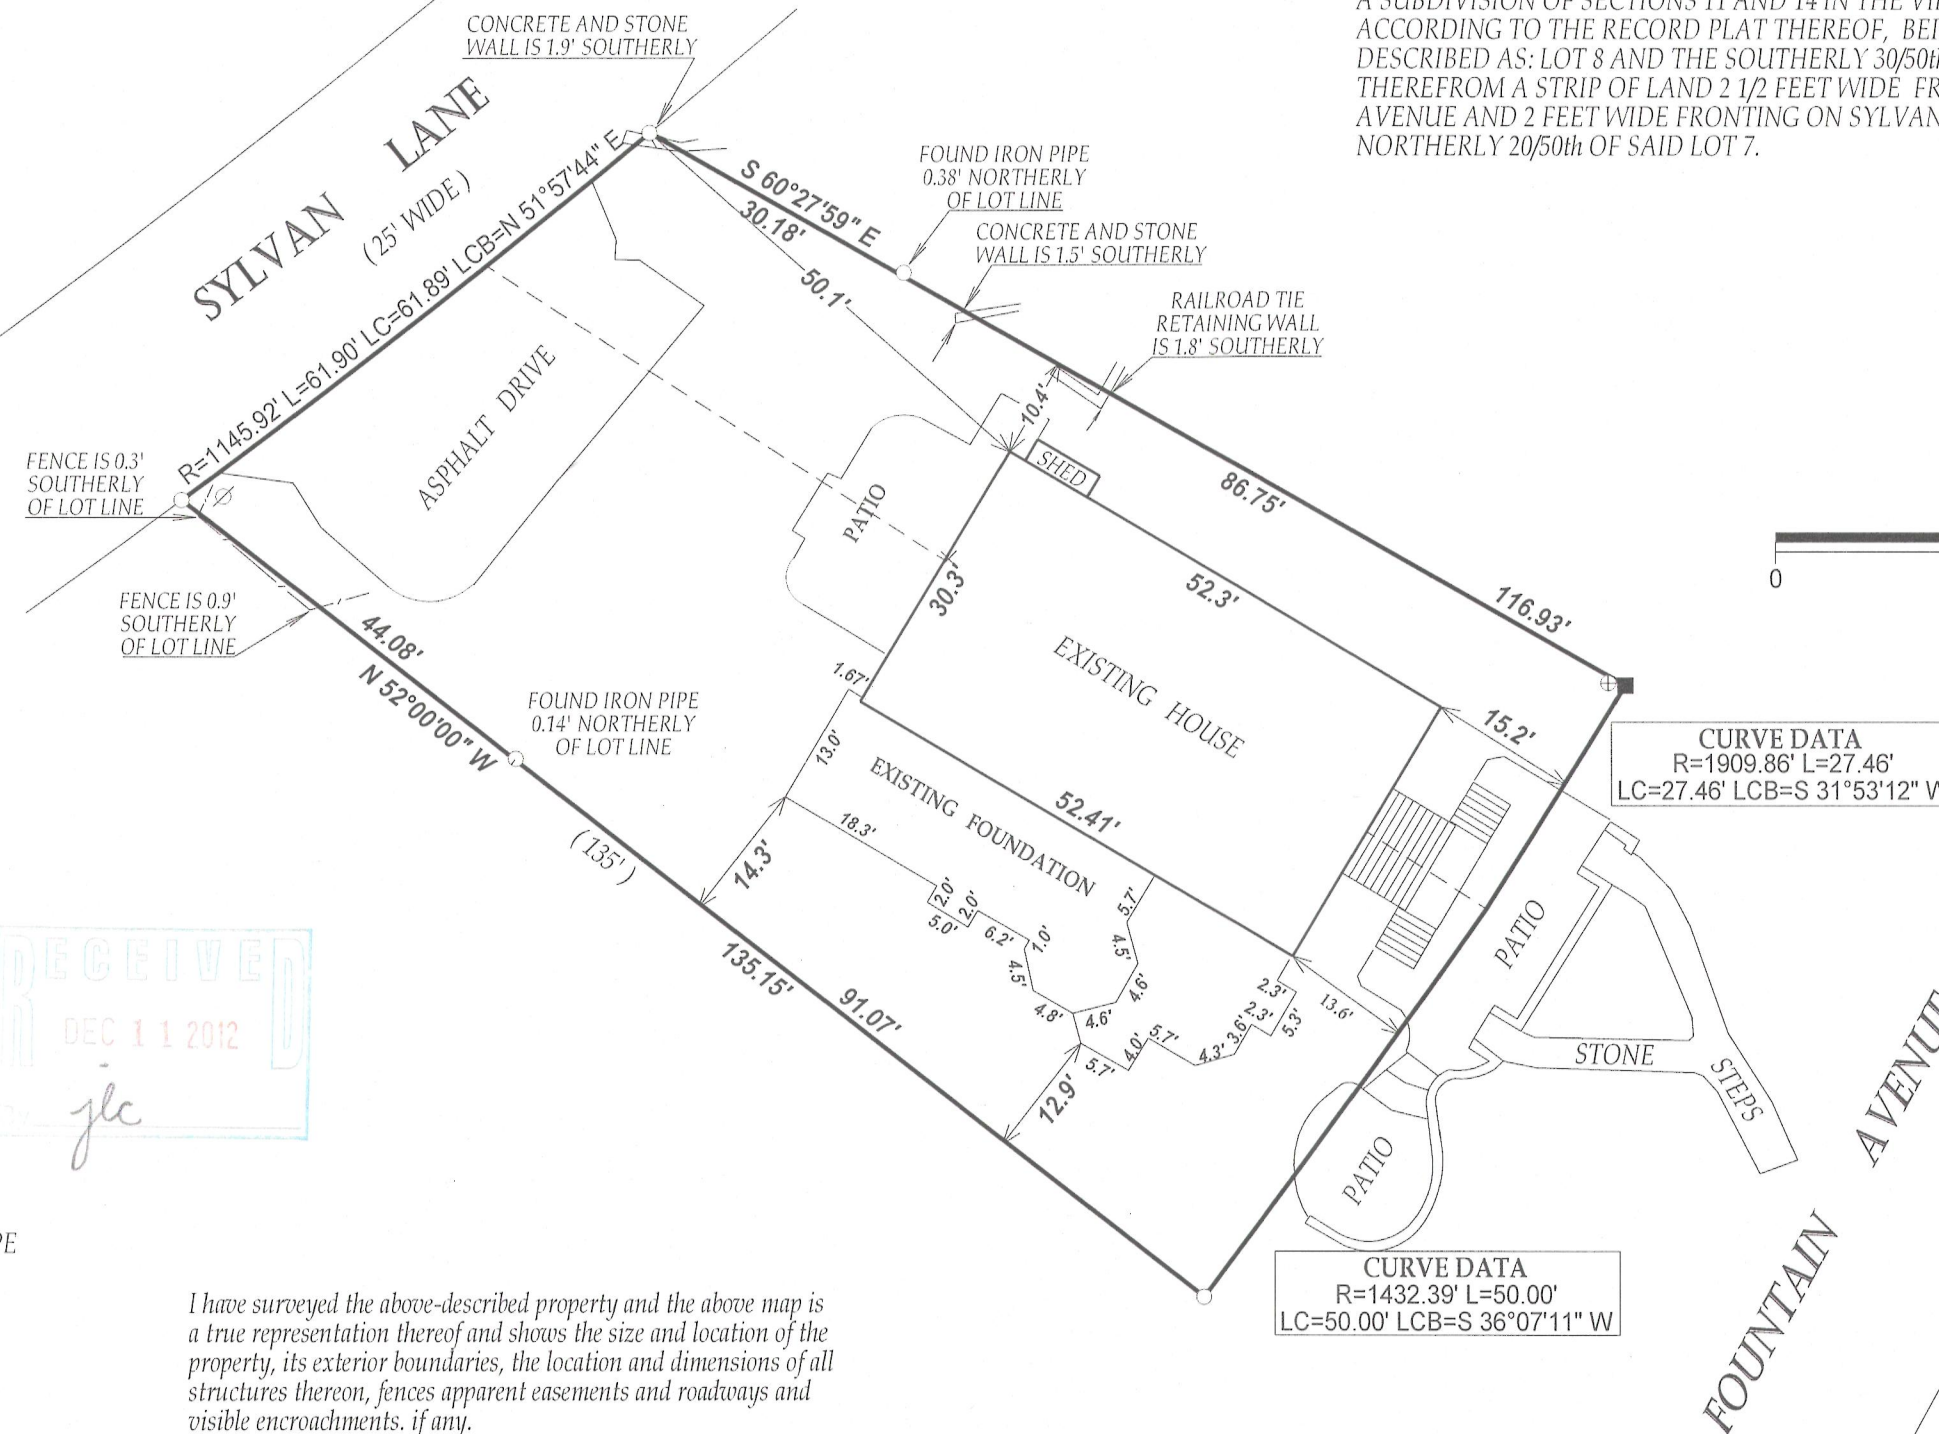


KROTT SURVEYING INC.
N3705 WILLOW BEND LANE
LAKE GENEVA WI. 53147
PHONE # (262)248-3697
FAX # (262)249-0639


-OF-

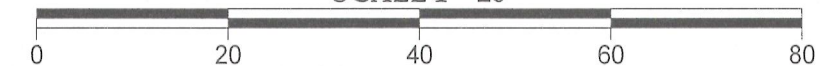

○ FOUND IRON PIPE
■ SET IRON BAR
⊕ YARD BASIN
∅ UTILITY POLE
(XX) RECORDED AS
TAX ID # SBV00006
JOB # 11-065PA

This survey is made for the exclusive use of the present owners of the property, and also those who purchase, mortgage, or insure the title thereto within one (1) year from date hereof; and as to them I warrant the accuracy of said survey map.

NOTE: BEARINGS ARE REFRENCED TO THE RECORD PLAT

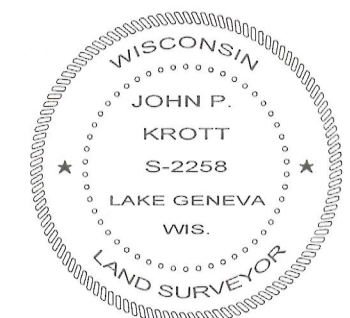

DATED THIS 12th DAY OF MAY 2011.
DATE OF LAST REVISION: 11/14/2012
REVISED 10/16/2012



JOHN KROTT S - 2258
Wisconsin Registered Land Surveyor
(original if signed in red)

005 - 2946