
## LAND-MARK SURVEYING Mark L. Miritz

Wisconsin Registered Land Surveyor S-2582

N9330 Knuteson Drive Whitewater, WI 53190 Phone: (262)495-3284 FAX: (262) 495-8421 LAND-MARKSURVEYING.COM

LOT 6, BLOCK 5 OF THE ORIGINAL PLAT OF THE VILLAGE OF FONTANA, LOCATED IN THE NORTHWEST 1/4 OF SECTION 14, TOWN 1 NORTH, RANGE 16 EAST, WALWORTH COUNTY, WISCONSIN

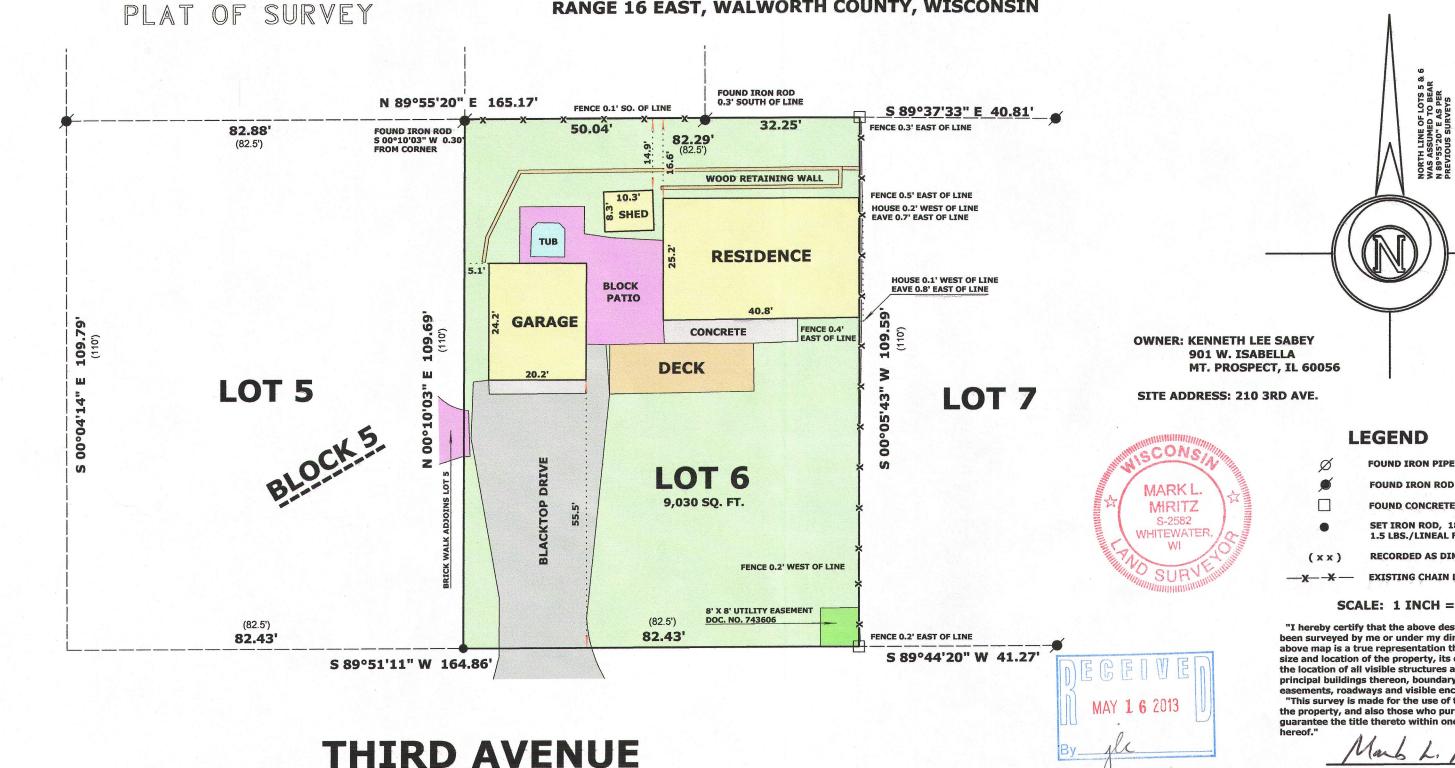

## **LEGEND**

**FOUND IRON PIPE** 

**FOUND CONCRETE MONUMENT** 

SET IRON ROD, 18" LONG, WEIGHING 1.5 LBS./LINEAL FT., 3/4" DIA.

RECORDED AS DIMENSION **EXISTING CHAIN LINK FENCE** 

SCALE: 1 INCH = 20 FEET

"I hereby certify that the above described property has been surveyed by me or under my direction and that the above map is a true representation thereof and shows the size and location of the property, its exterior boundaries, the location of all visible structures and dimensions of all principal buildings thereon, boundary fences, apparent easements, roadways and visible encroachments, if any."

"This survey is made for the use of the present owners of the property, and also those who purchase, mortgage, or guarantee the title thereto within one year from date

> MARK L. MIRITZ **WISCONSIN REGISTERED LAND SURVEYOR S-2582**

DATE: APRIL 5, 2013 JOB NO. 13.306