


Plat of Survey

of

Lots 5 & 6 of Block 7 of Glenwood Springs,

a subdivision located in the Southeast 1/4 of Section 14, Town 1 North, Range 16 East, Village of Fontana-on-Geneva Lake, Walworth County, Wisconsin.

Surveyed for: **Marc Jensen**
646 Linden Drive
Fontana, Wisconsin 53125

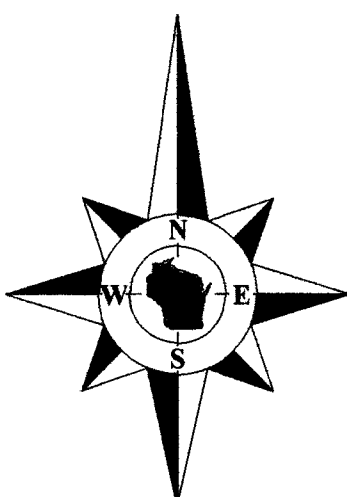

Bearings reference to the plat
of Glenwood Springs.

Survey date: June 9, 2009.
Revisions:
No. 1 - Spot Elevations and
Impervious area
No. 2 - Proposed House
No. 3 - Proposed House
and Impervious
No. 4 - Proposed House as
No. 5 - Proposed House as
No. 6 - Proposed House as
No. 7 - Foundation location
No. 8 - Roof Height

Scale in Feet

1" = 10'



Jensen & Olson Land Surveying, LLC

45 South Wisconsin Street * P.O. Box 322 * Elkhorn, Wisconsin, 53121

Telephone: (262) 723-3434 * Facsimile: (262) 723-8044

Email: jensen.olson@elknet.net




Legend

- Found Concrete Monument
- Found Iron Pipe
- Found Chisel cross
- Recorded Information
- Spot Elevation
- Water Valve
- Gravel Surface
- Concrete Surface

Sheet 1 of 1 Sheets


Job Reference Number
2013.093

2013.093

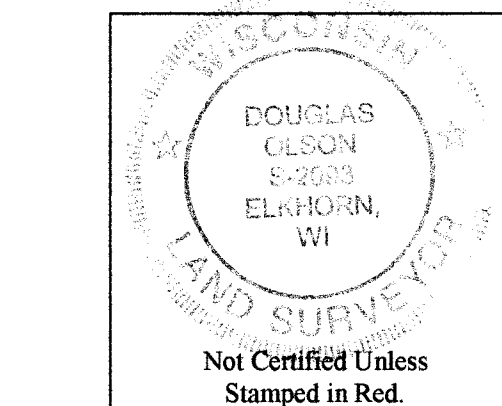

Notes:

- This survey plat is not certified unless signed and sealed in red ink.
- This survey is subject to Wisconsin lien laws. This Plat of Survey is the notice of intent to file lien. Lien waiver required.

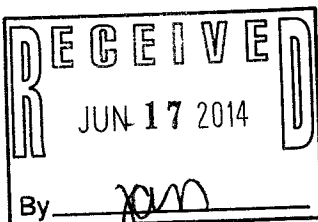

Copyright 2009 by Jensen & Olson Land Surveying, LLC.

All rights reserved. No part of this survey plat may be reproduced or transmitted in any form by any means - graphic, electronic, or mechanical, including photocopying, tracing, or information storage and retrieval systems - without permission in writing from Douglas G. Olson, Jensen & Olson Land Surveying, LLC.

I hereby certify that I have surveyed the above described property and the map hereon is correct to the best of my professional knowledge and belief and shows the size and location of the property, its exterior boundaries, the location and dimensions of all visible structures thereon, boundary fences, apparent easements and roadways and visible encroachments, if any.

This survey is made for the exclusive use of the present owners of the property, and also those who purchase, mortgage or guarantee title thereto, within one year from the date hereof.

Douglas G. Olson
Wisconsin Registered Land Surveyor - 2093

862-25

005-3052

Notes:

- This Plat of Survey shows the boundary of Lots 5 and 6 of Block 7 of Glenwood Springs as currently monumented in the field. Field measurements do not match recorded dimensions. There is an overlap of prior surveys along the South line of Lot 8 as shown.
- Total area of existing and proposed onsite impervious surfaces is 3,093 sq.ft. or 44% of parcel.
- Highest point of prior house along roof ridge line was 134.2.