



PREPARED FOR  
MARIA KEBBEKUS  
886 TIMBER TR.  
FONTANA, WI 53125

# PLAT OF SURVEY

- OF -

LOT F9 ADDITION F TO COUNTRY CLUB ESTATES, LOCATED IN THE SW 1/4 OF THE SE 1/4 OF SECTION 14,  
TOWN 1 NORTH, RANGE 16 EAST, VILLAGE OF FONTANA - ON - GENEVA LAKE, WALWORTH COUNTY,  
WISCONSIN.

PATHFINDER SURVEYING INC.  
(formerly)  
J.K. SURVEYING INC.  
P.O BOX 322  
LAKE GENEVA, WI. 53147  
WWW.PATHFINDERSURVEYING.NET  
262-248-8303

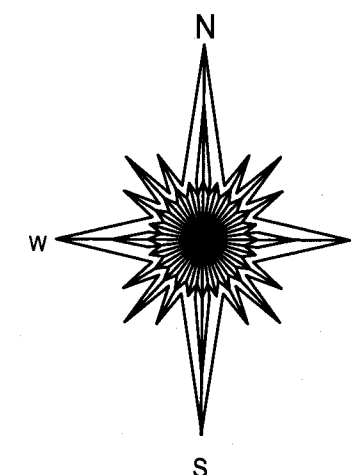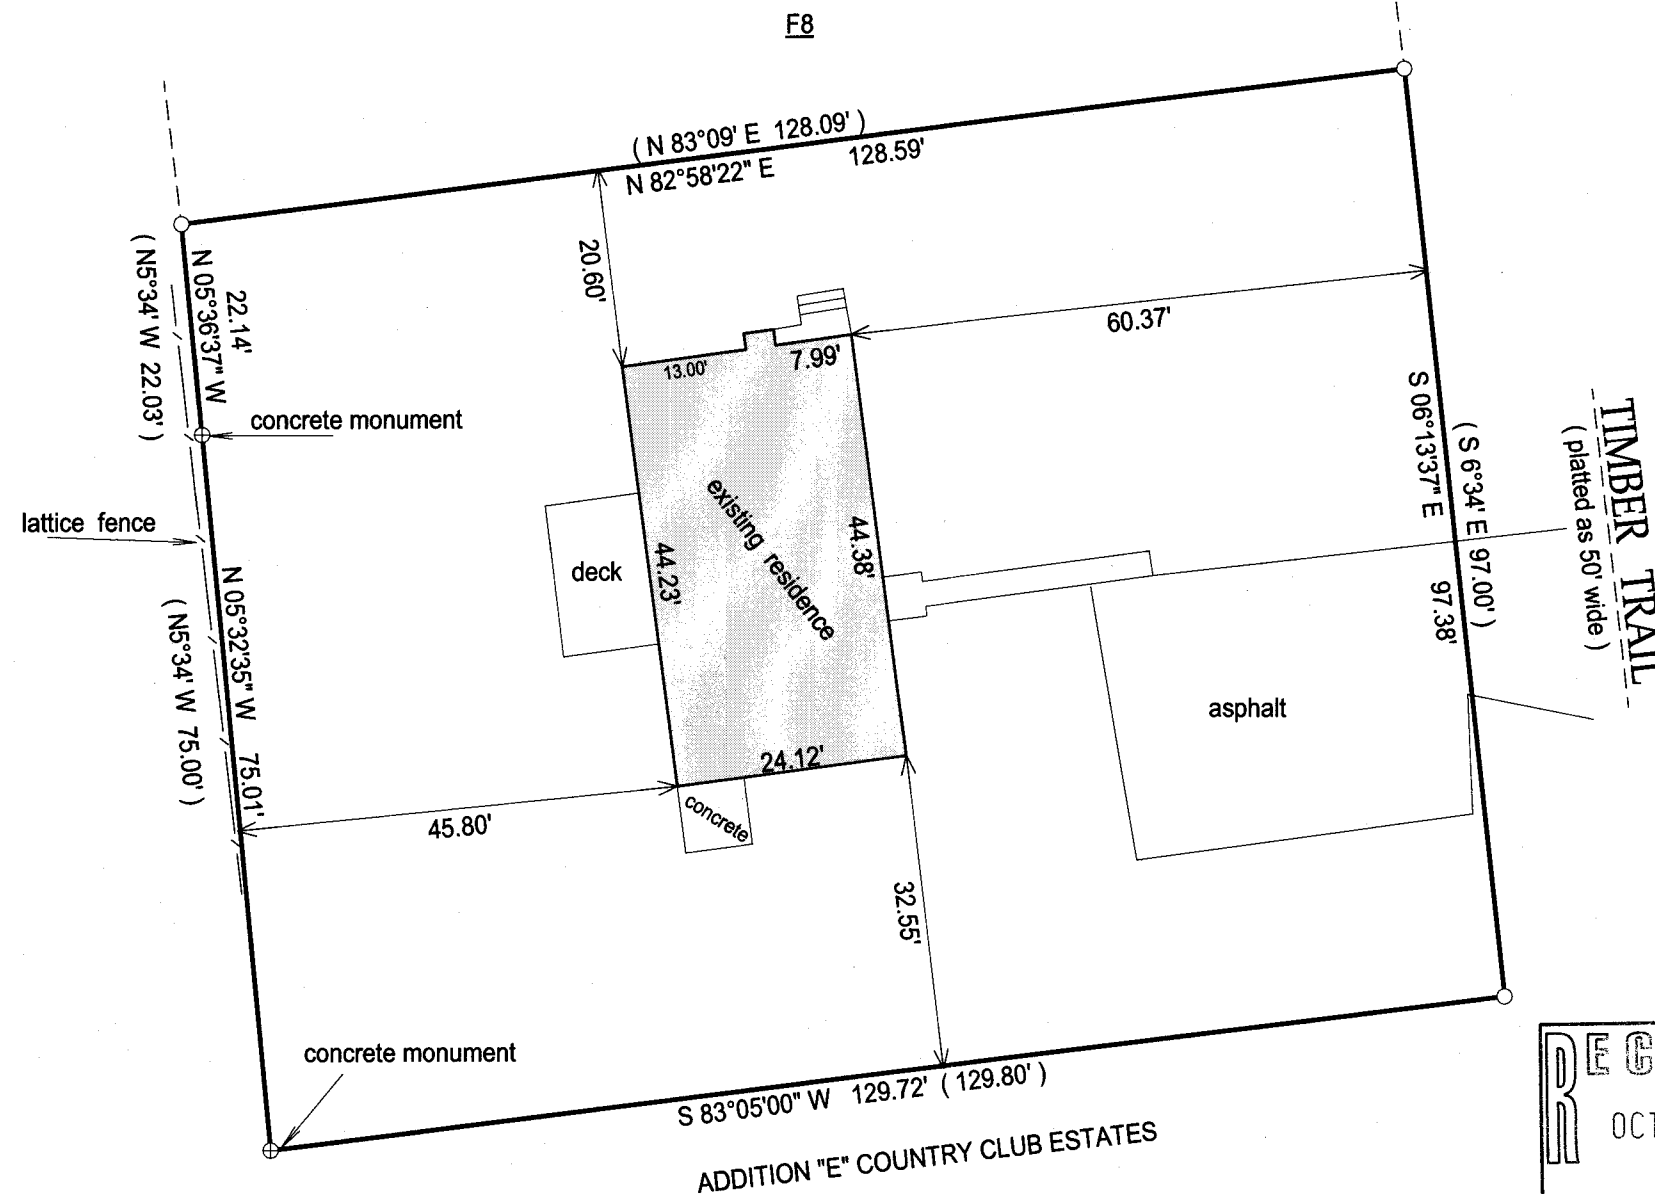

20 0 20 40

BASIS OF BEARING OF THIS PLAT: THE SOUTH LINE OF  
LOT F9 WAS ASSUMED TO BEAR S83°05' W AS  
SHOWN ON THE RECORD PLAT.

- ( ) = recorded as
- = found iron bar
- = found iron pipe
- = set iron pipe
- = set iron bar

SCALE 1" = 20'



JOB # 14-137

TAX ID # SCTF00009

"I hereby certify that I have surveyed the above described property and that the above map is a true representation of its exterior boundary and shows the size and location of all visible structures, apparent easements and encroachments if any."

This survey is made for the present owners of the property, and those who purchase, mortgage, or guarantee the title thereto, within one year from the date hereof.

DATED THIS 258TH DAY OF JUNE, 2014.

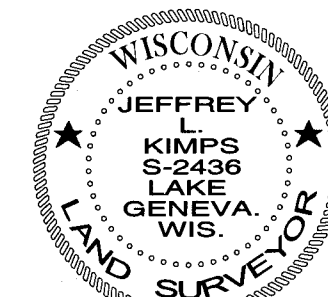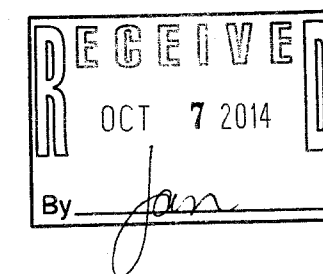

JEFFREY L. KIMPS S-2436  
Wisconsin Registered Land Surveyor  
(original if signed in red)

SCTF-9

005-3070