
PREPARED FOR: CATHY TANK 758 GENEVA LANE FONTANA, WI 53125

PLAT OF SURVEY

-OF-


LOTS 1 AND 2 OF GENEVA LANE, A SUBDIVISION LOCATED IN SECTION 14, TOWN 1 NORTH, RANGE 16 EAST, VILLAGE OF FONTANA ON GENEVA LAKE, WALWORTH COUNTY, WISCONSIN. LYNCH & ASSOCIATES ENGINEERING CONSULTANTS, LLC.

5482 S. WESTRIDGE DR. NEW BERLIN, WI 53151 (262) 248-3697

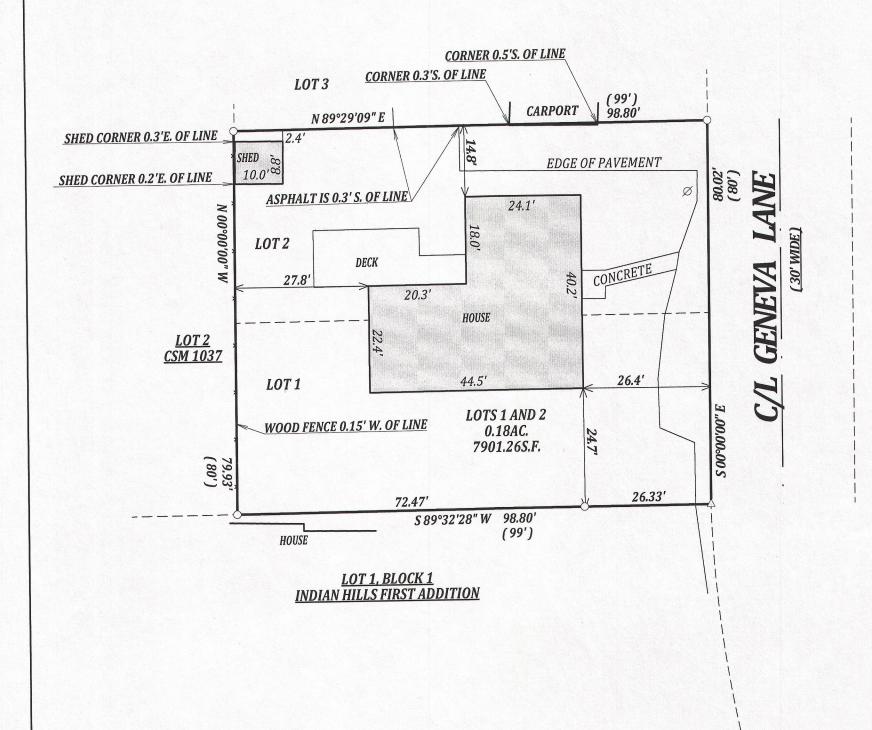

LEGEND

- O FOUND 1" IRON PIPE
- △ SET "PK" NAIL
- ☐ FOUND "GIN SCREW"
- (XX) RECORDED AS
- Ø POWER POLE

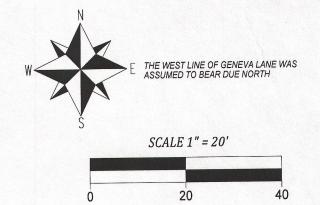



Ø

NOTE:

No title commitment or reults of a title search were provided to this office pertaining to this survey. This Plat Of Survey may not reflect easements of record, encumbrances, restrictions, ownership, title evidence, or other facts that a current and accurate title search may disclose.

I have surveyed the above-described property and the above map is a true representation thereof and shows the size and location of the property, its exterior boundaries, the location and dimensions of all structures thereon, fences apparent easements and roadways and visible encroachments. if any.

This survey is made for the exclusive use of the present owners of the property, and also those who puchase, mortgage, or insure the title therto within one (1) year from date hereof; and as to them I warrant the accuracy of said survey map.



KENNETH B. MEHRING S - 2838Wisconsin Registered Land Surveyor (original if signed in red)

JOB # 14-573 TAX ID # SGL00001