




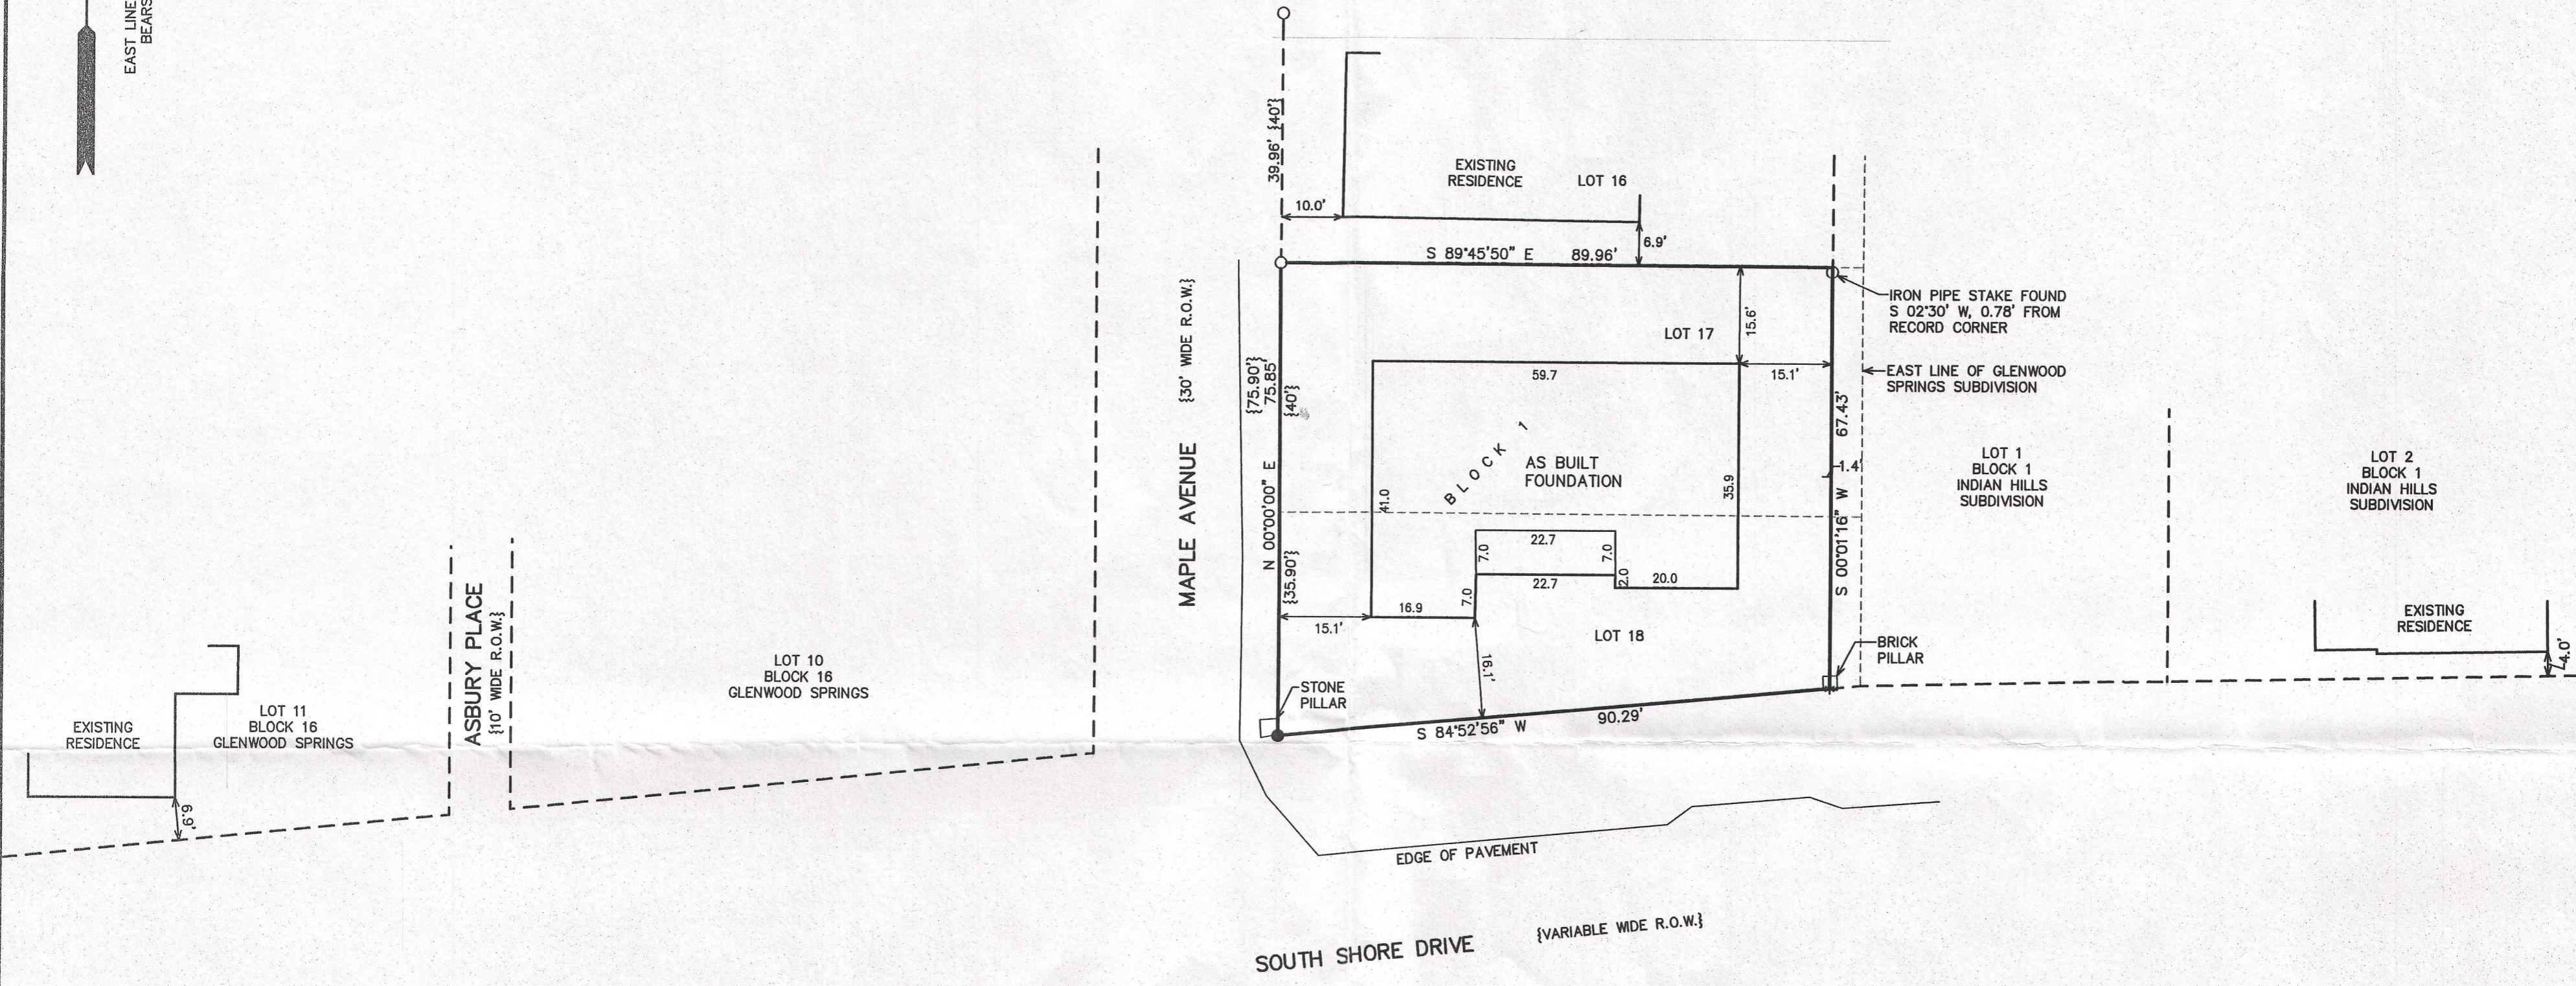

PLAT OF SURVEY
 LOTS 17 & 18, BLOCK 1, OF GLENWOOD SPRINGS SUBDIVISION
 EXCEPT THE EAST 5' THEREOF
 LOCATED IN THE VILLAGE OF FONTANA-ON-GENEVA LAKE,
 WALWORTH COUNTY, WISCONSIN

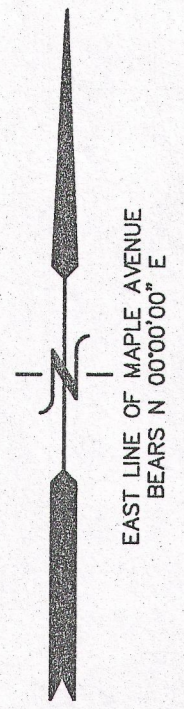

SOUTH SHORE DRIVE {VARIABLE WIDE R.O.W.}

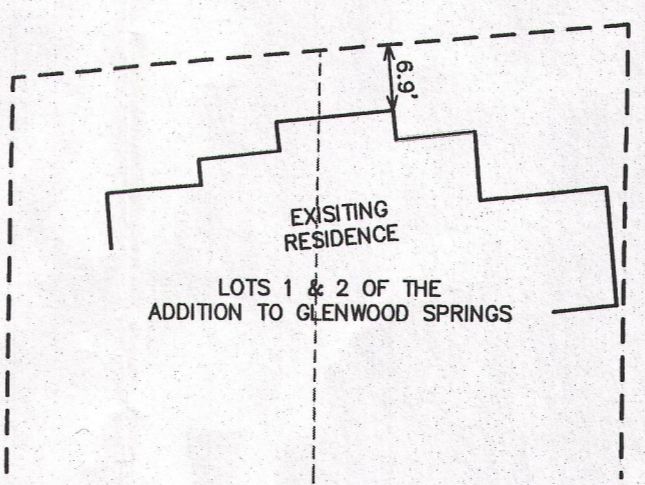




- LEGEND**
- * = CHISELED "X" IN BRICK PILLAR FOUND
 - = IRON REBAR STAKE FOUND
 - = IRON PIPE STAKE FOUND
 - {XXX} = RECORDED AS
- AREA=6,445 SQ. FT.

NOTE: COPIES OF THIS MAP TO WHICH THE FOLLOWING CERTIFICATE WILL APPLY SHOW THE SURVEYOR'S ORIGINAL SEAL AND SIGNATURE IN RED INK. COPIES BY ANY OTHER MEANS MAY HAVE ALTERATIONS WHICH DO NOT REPRESENT THE SURVEYOR'S WORK PRODUCT.

I HEREBY CERTIFY THAT THE ABOVE DESCRIBED PROPERTY HAS BEEN SURVEYED UNDER MY DIRECTION AND THAT THE ABOVE MAP IS A TRUE REPRESENTATION THEREOF AND SHOWS THE SIZE AND LOCATION OF THE PROPERTY AND ITS EXTERIOR BOUNDARIES. THIS SURVEY IS MADE FOR THE USE OF THE PRESENT OWNERS OF THE PROPERTY, AND ALSO THOSE WHO PURCHASE, MORTGAGE, OR GUARANTEE THE TITLE THERETO WITHIN ONE YEAR FROM THE DATE HEREOF.

DATED: MAY 31, 2013 REVISED 1008-2014 TO SHOW SIZE & LOCATION OF AS BUILT FOUNDATION

Peter S. Gordon
 PETER S. GORDON R.L.S. 2101

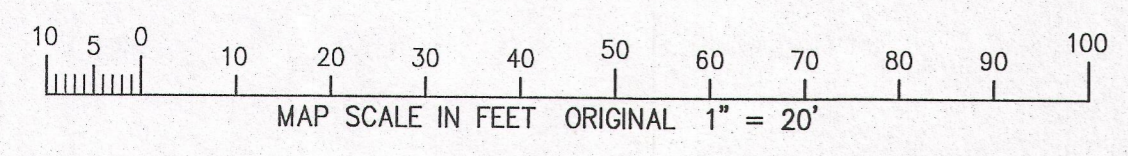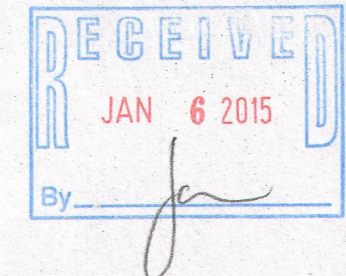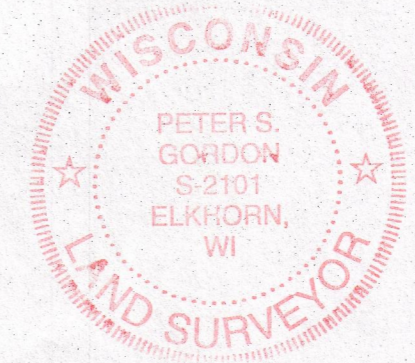

WORK ORDERED BY --
 GARRETT FRYE
 4112 WHITE ASH ROAD
 CRYSTAL LAKE, IL 60014

FARRIS, HANSEN & ASSOCIATES, INC.
 ENGINEERING - ARCHITECTURE - SURVEYING
 7 RIDGWAY COURT P.O. BOX 437
 ELKHORN, WISCONSIN 53121
 OFFICE: (262) 723-2098 FAX: (262) 723-5886

REVISIONS

PROJECT NO. 8808
 DATE: 5/31/2013
 SHEET NO. 1 OF 1

868-6 005-3100

OCT 08 2014

10/8/2014 X:\Projects\8808\dsca\turney