


PLAT OF SURVEY  
PART OF BLOCK 3 OF ASSESSOR'S PLAT NO. 1  
C.L. DOUGLASS SUBDIVISION  
VILLAGE OF FONTANA ON GENEVA LAKE  
WALWORTH COUNTY, WISCONSIN

STATE TRUNK HIGHWAY "67"  
AKA VALLEY VIEW DRIVE

3. The land referred to in the Commitment is described as follows:

Lots 2, 3 and 4 except the South 36 feet of said Lot 4 of Block 3 of the Assessors  
Plat No. 1 of the C. L. Douglas Addition to the Village of Fontana-on-Geneva Lake,  
Walworth County, Wisconsin.

Tax Key No: STFV 00196 and STFV 00197

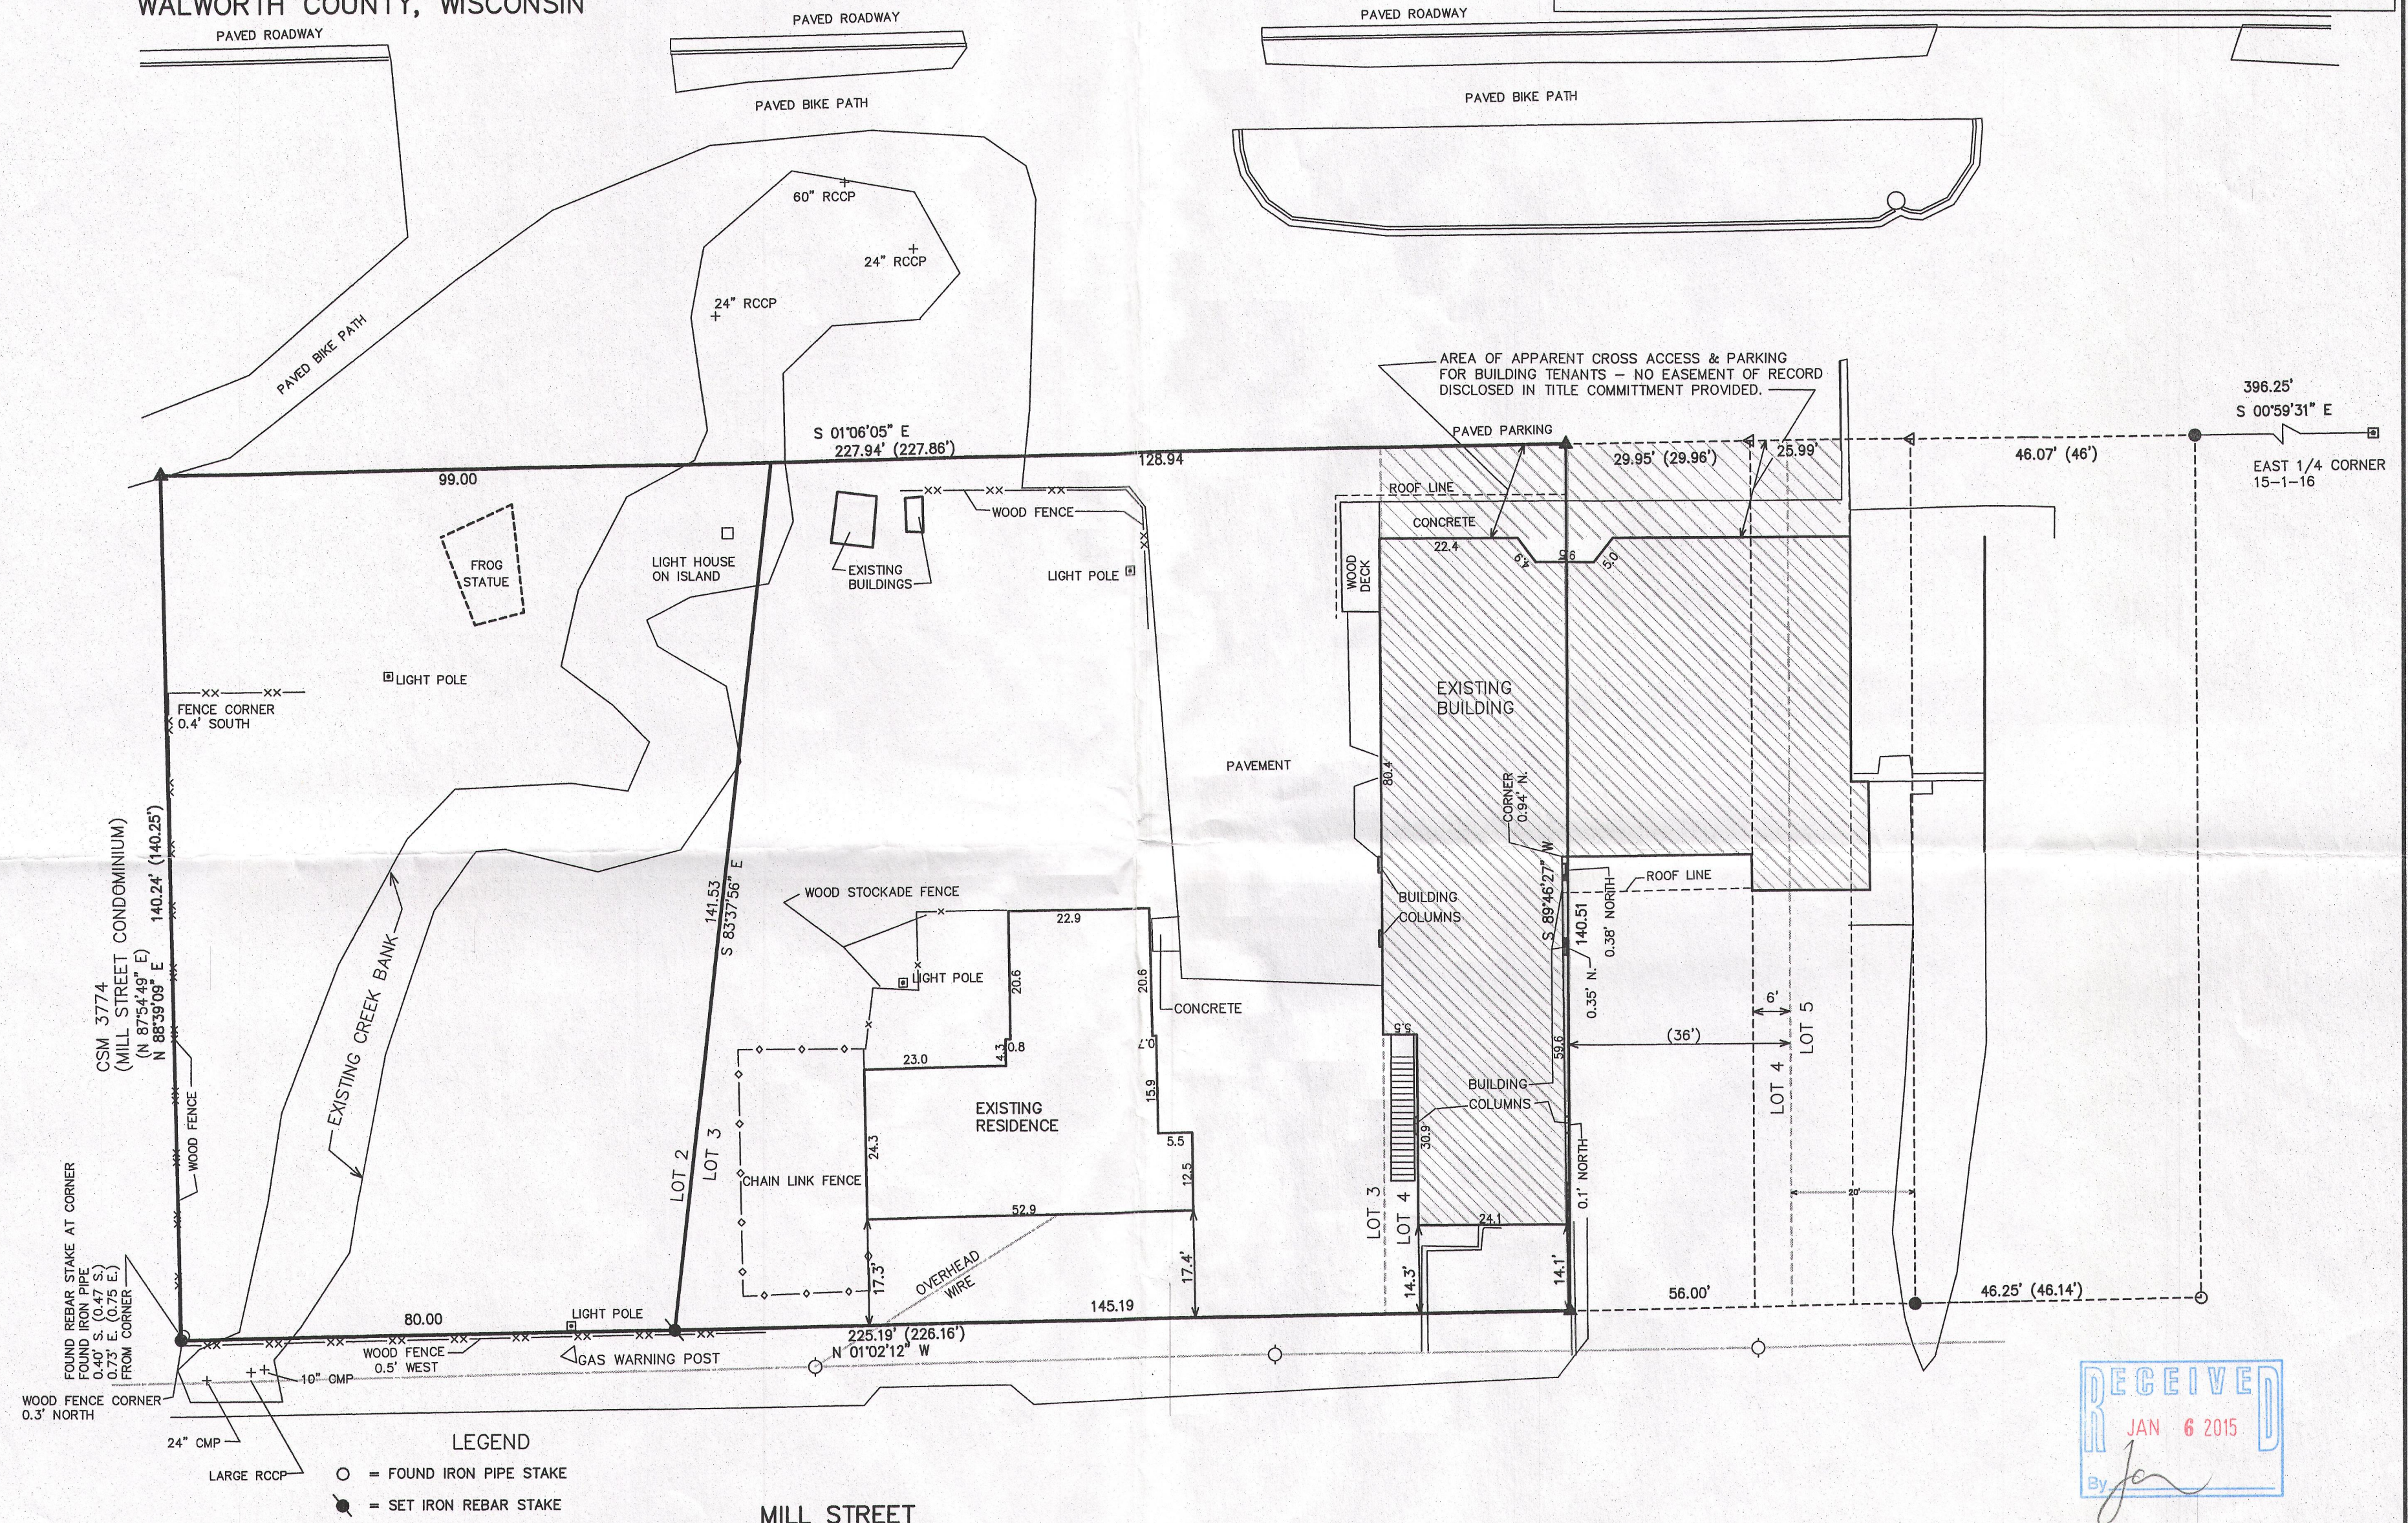


NOTE: COPIES OF THIS MAP TO WHICH THE FOLLOWING CERTIFICATE WILL APPLY SHOW SURVEYOR'S ORIGINAL SEAL AND SIGNATURE IN RED INK. COPIES BY ANY OTHER MEANS MAY HAVE ALTERATIONS WHICH DO NOT REPRESENT THE SURVEYOR'S WORK PRODUCT.

I HEREBY CERTIFY THAT THE ABOVE DESCRIBED PROPERTY HAS BEEN SURVEYED UNDER MY DIRECTION AND THAT THE ABOVE MAP IS A TRUE REPRESENTATION THEREOF AND SHOWS THE SIZE AND LOCATION OF THE PROPERTY, ITS EXTERIOR BOUNDARIES, THE LOCATION OF ALL VISIBLE STRUCTURES, AND DIMENSIONS OF ALL PRINCIPLE BUILDINGS THEREON, BOUNDARY FENCES, APPARENT EASEMENTS, ROADWAYS, AND VISIBLE ENCROACHMENTS, IF ANY. THIS SURVEY IS MADE FOR THE USE OF THE PRESENT OWNERS OF THE PROPERTY, AND ALSO THOSE WHO PURCHASE, MORTGAGE, OR GUARANTEE THE TITLE THERETO WITHIN ONE YEAR FROM THE DATE HEREOF.

DATED: MARCH 5, 2010

REVISED & RECERTIFIED  
SEPTEMBER 23, 2014

PETER S. GORDON R.L.S. 2101

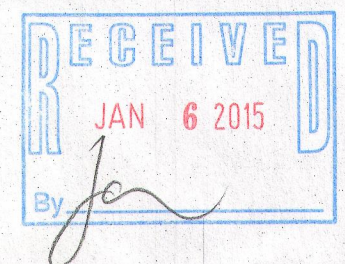

WORK ORDERED BY:  
BRIAN HUTCHINSON  
C/O KEEFE REAL ESTATE  
LAKE GENEVA, WI.

FARRIS, HANSEN & ASSOCIATES, INC.  
ENGINEERING - ARCHITECTURE - SURVEYING  
7 RIDGWAY COURT P.O. BOX 437  
ELKHORN, WISCONSIN 53121  
OFFICE: (262) 723-2098 FAX: (262) 723-5886

REVISIONS

PROJECT NO.  
8075  
DATE:  
02-25-2010  
SHEET NO.  
1 OF 1

STFV-196  
STFV-197  
005-3101