

FARRIS, HANSEN & ASSOCIATES, INC.


ENGINEERING — ARCHITECTURE — SURVEYING
 7 RIDGWAY COURT — P.O. BOX 437 — ELKHORN, WISCONSIN 53121
 PHONE: (262) 723-2098 FAX: (262) 723-5886

PLAT OF SURVEY

LOT 14, "COUNTRY CLUB ESTATES ADDITION 'K'" LOCATED IN
 VILLAGE OF FONTANA—ON—GENEVA LAKE, WALWORTH COUNTY, WISCONSIN

— WORK ORDERED BY —
 D'APRILE PROPERTIES
 P.O. BOX 72
 FONTANA, WI 53115

Lot 14 of Country Club Estates Addition "K", according to the recorded plat thereof. Said land being in the Village of Fontana, County of Walworth and State of Wisconsin.
 FOR INFORMATIONAL PURPOSES ONLY:
 Property Address: 102 Montaque, Fontana, WI 53125
 Tax Key Number: SCKT 00014


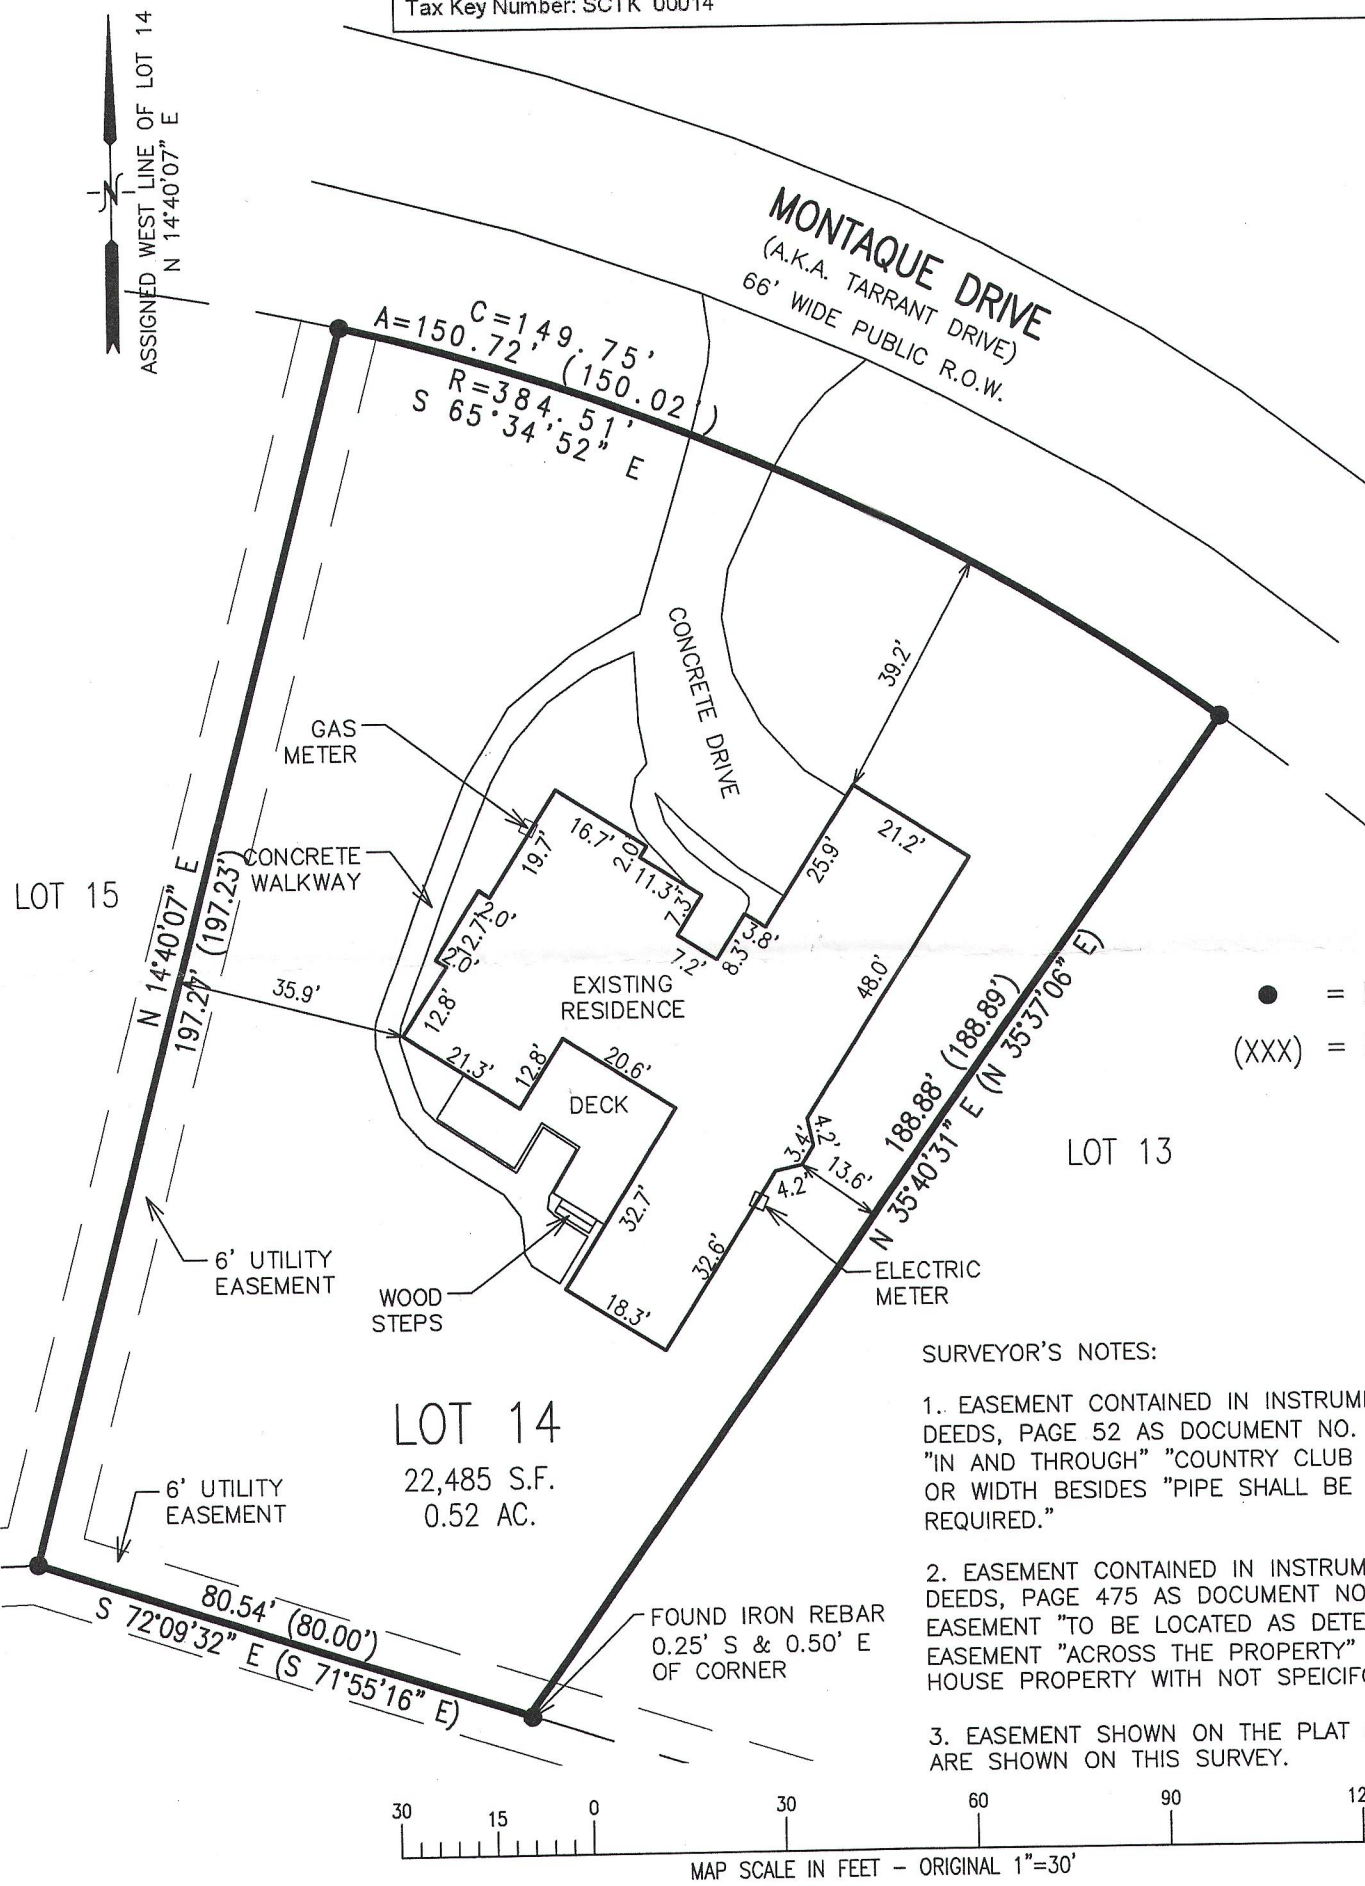


NOTE: COPIES OF THIS MAP TO WHICH THE FOLLOWING CERTIFICATE WILL APPLY SHOW THE SURVEYOR'S ORIGINAL SEAL AND SIGNATURE IN RED INK. COPIES BY ANY OTHER MEANS MAY HAVE ALTERATIONS WHICH DO NOT REPRESENT THE SURVEYOR'S WORK PRODUCT.

I HEREBY CERTIFY THAT THE ABOVE DESCRIBED PROPERTY HAS BEEN SURVEYED UNDER MY DIRECTION AND THAT THE ABOVE MAP IS A TRUE REPRESENTATION THEREOF AND SHOWS THE SIZE AND LOCATION OF THE PROPERTY, ITS EXTERIOR BOUNDARIES, THE LOCATION OF ALL VISIBLE STRUCTURES, AND DIMENSIONS OF ALL PRINCIPLE BUILDINGS THEREON, BOUNDARY FENCES, APPARENT EASEMENTS, ROADWAYS, AND VISIBLE ENCROACHMENTS, IF ANY. THIS SURVEY IS MADE FOR THE USE OF THE PRESENT OWNERS OF THE PROPERTY AND ALSO THOSE WHO PURCHASE, MORTGAGE, OR GUARANTEE THE TITLE THERETO WITHIN ONE YEAR FROM THE DATE HEREOF.

DATED: 06/02/2015

Peter S. Gordon
 PETER S. GORDON

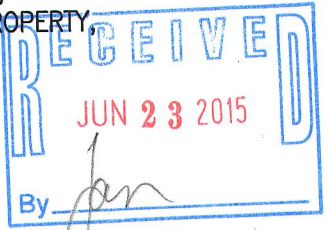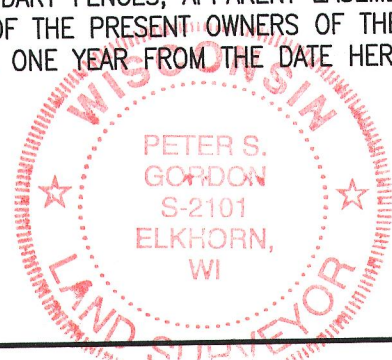

PROJECT: 9298
 DATE: 06/02/2015
 SHEET 1 OF 1

JUN 16 2015

SCKT-14

005-3136

X:\Projects\9298\ACAD\9298_Title.dwg