


PREPARED FOR
 MARC LENSEN
 646 LINDEN AVE
 FONTANA WI 53125

PLAT OF SURVEY


- OF -

LOT 3, BLOCK 14 OF GLENWOOD SPRINGS, LOCATED IN THE VILLAGE OF FONTANA-
 ON-GENEVA LAKE, WALWORTH COUNTY, WISCONSIN.

PATHFINDER SURVEYING INC.
 (formerly)
 J.K. SURVEYING INC.
 P.O BOX 322
 LAKE GENEVA, WI. 53147
 WWW.PATHFINDERSURVEYING.NET
 262-248-8303

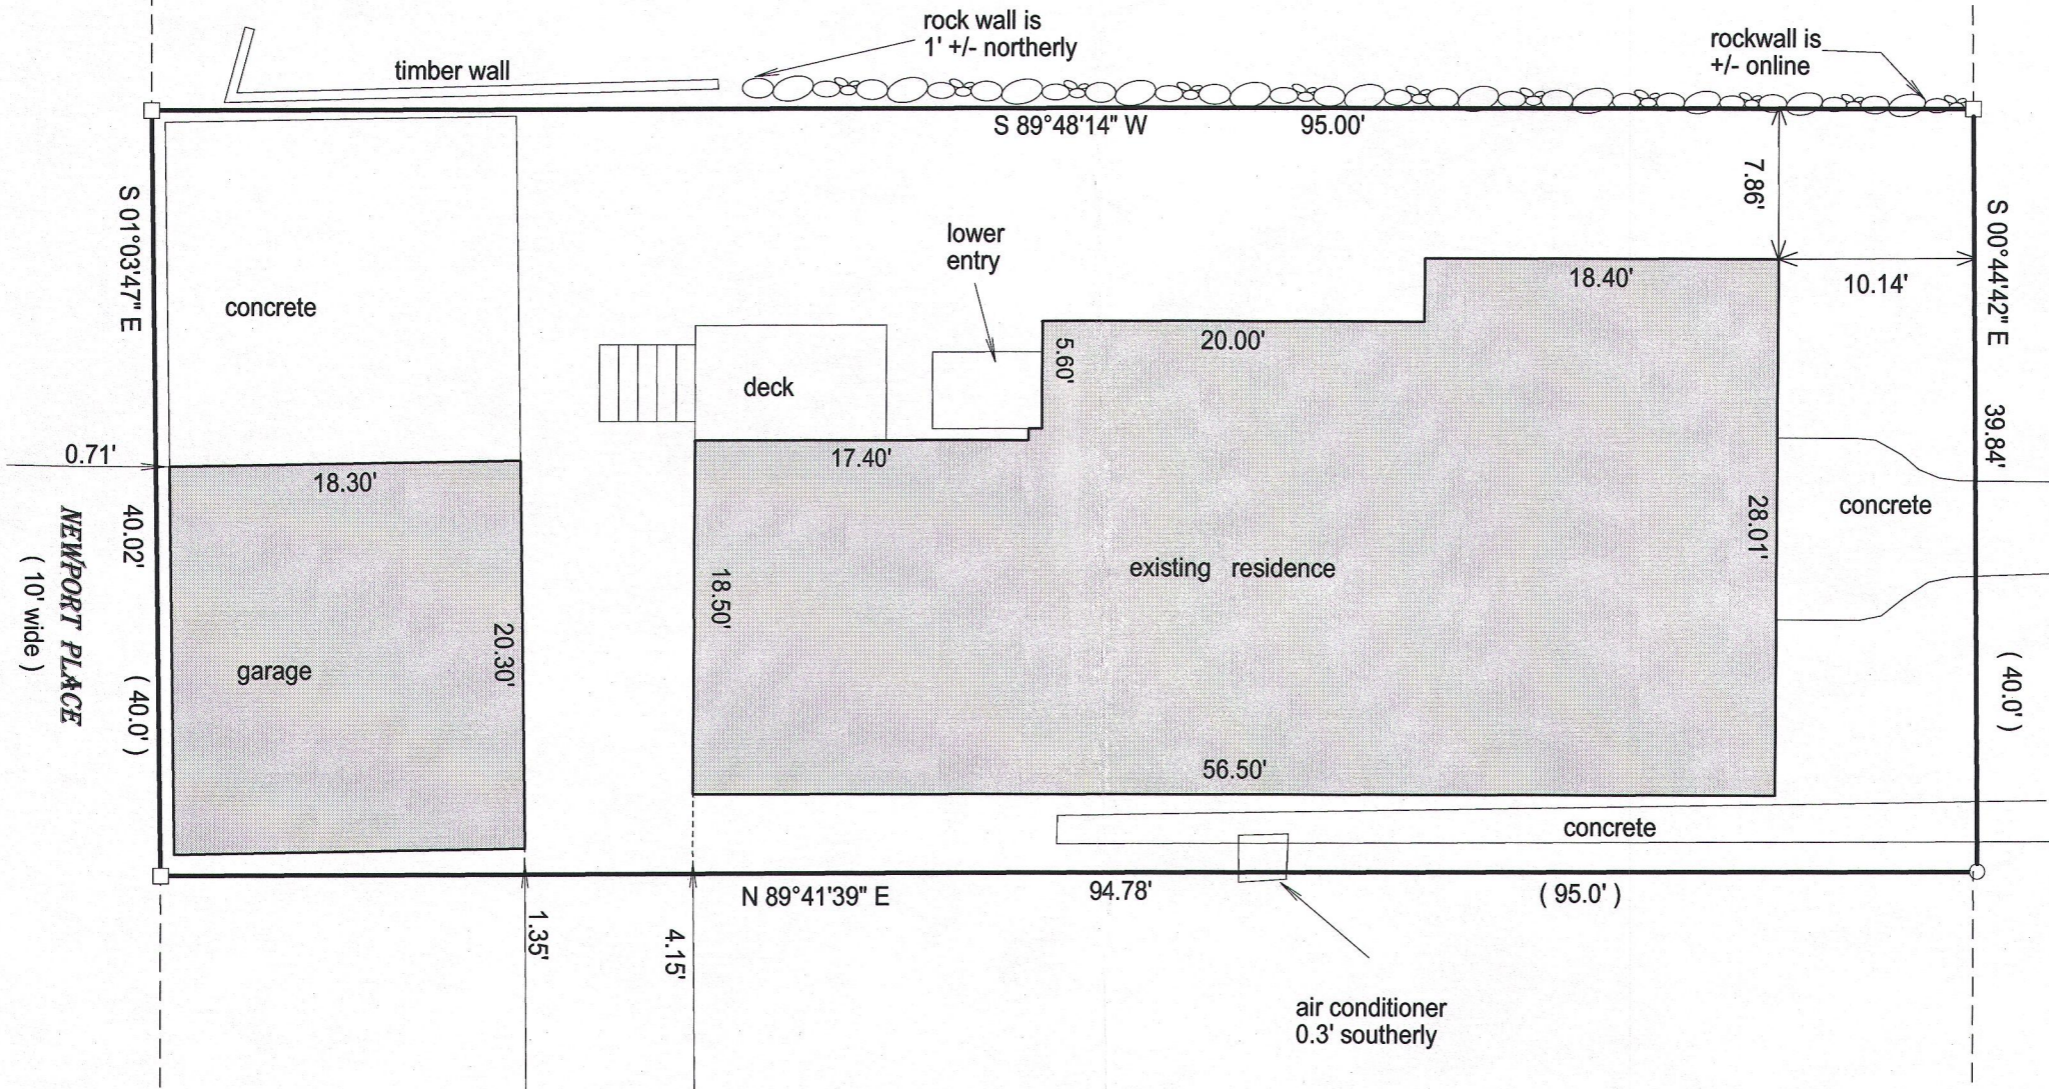


LINDEN AVENUE

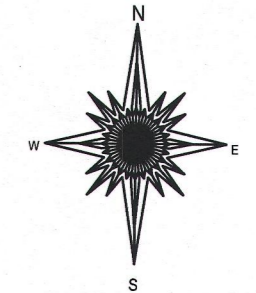

- () = recorded as
- = found iron bar
- = found iron pipe
- = set iron pipe
- = set iron bar

SCALE 1" = 10'
 JOB # 15-171
 TAX ID # SGS00083


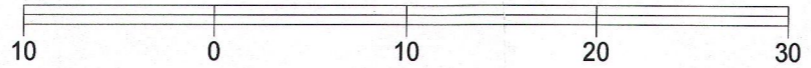


BASIS OF BEARING OF THIS PLAT: EXISTING SURVEYS OF RECORD,

"I hereby certify that I have surveyed the above described property and that the above map is a true representation of its exterior boundary and shows the size and location of all visible structures, apparent easements and encroachments if any."

This survey is made for the present owners of the property, and those who purchase, mortgage, or guarantee the title thereto, within one year from the date hereof.

DATED THIS 8TH DAY OF JUNE, 2015.

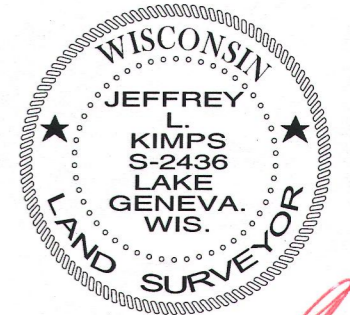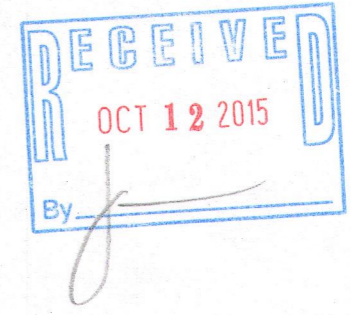

JEFFREY L KIMPS S-2436
 Wisconsin Professional Land Surveyor
 (original if signed in red)

868-82

005-3155